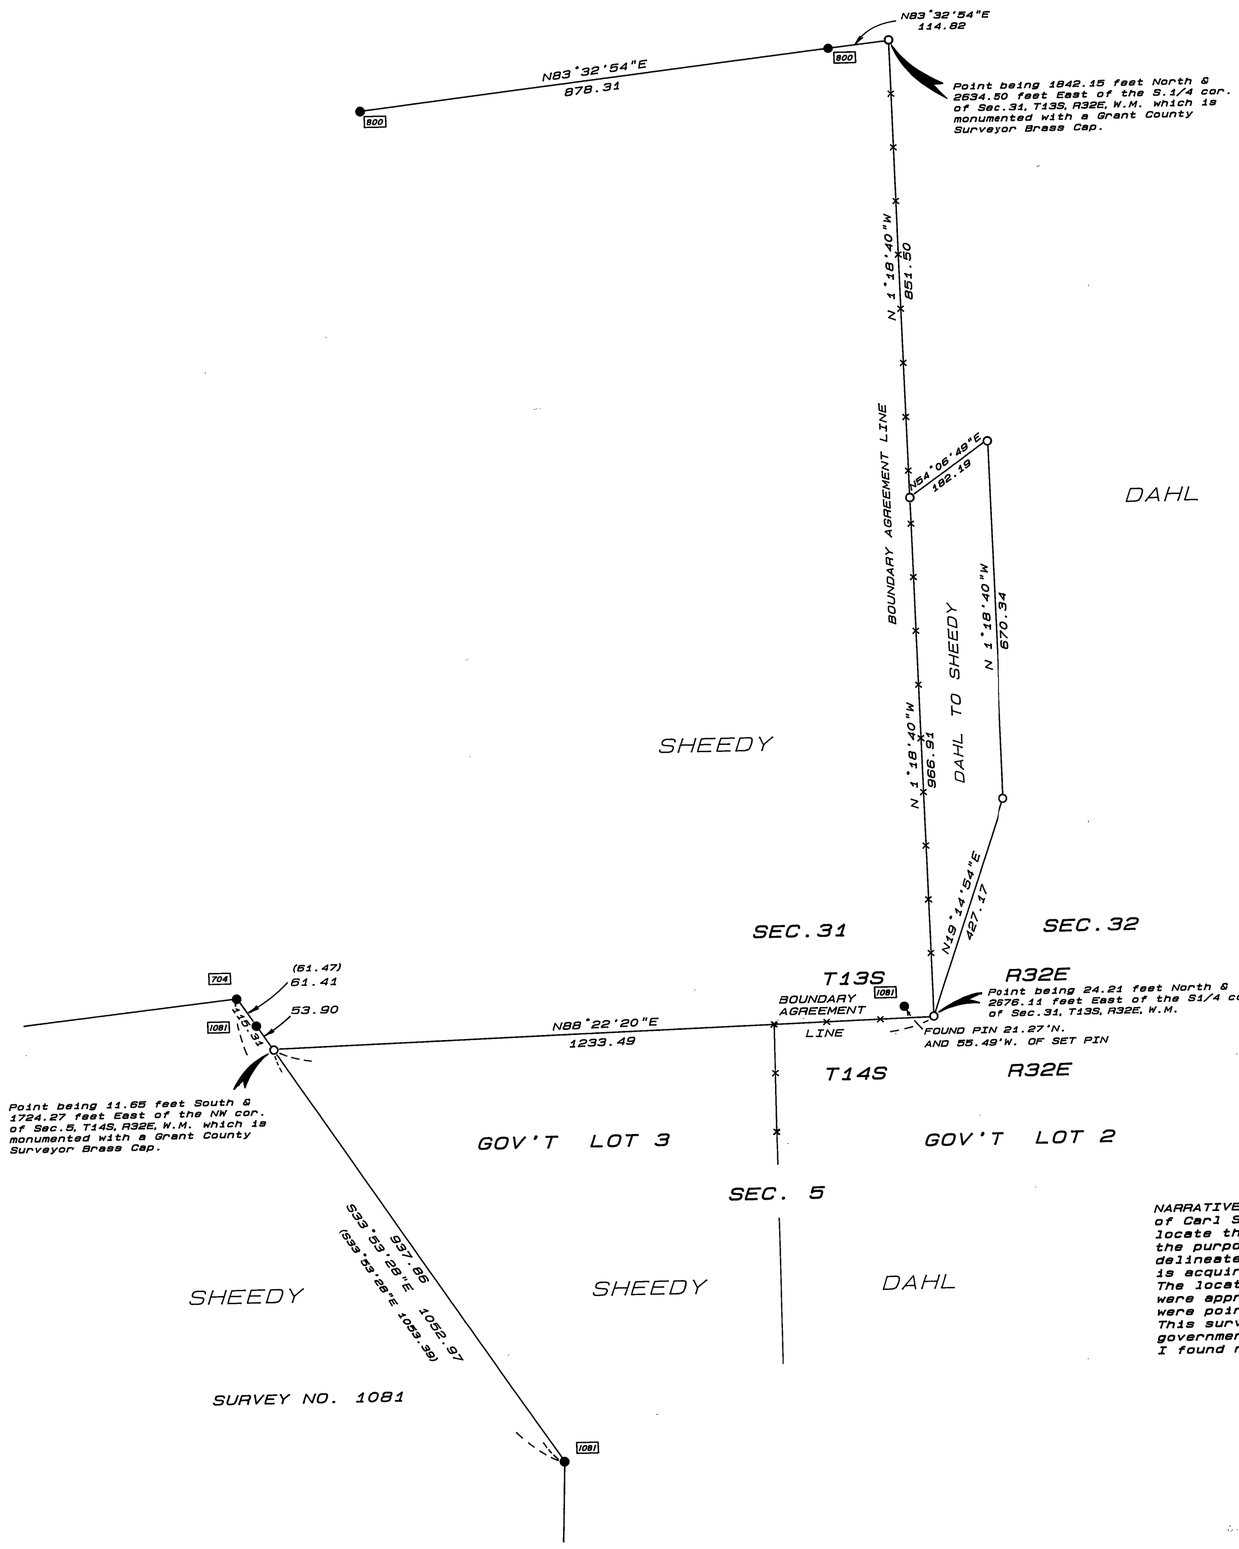

BASIS OF BEARINGS

MAP OF SURVEY NO. 800

LEGEND

- ● Found 5/8" iron pin, of record.
- ○ Set 5/8"x30" iron pin with attached yellow plastic cap marked BGA SURVEY MARKER.
- x——x Fence line.
- ( ) Record bearing and distance.
- ▭ Found monument from recorded Survey No. ▭ Survey No. appears in the box.

REFERENCES

Record Map of Survey No.s 704, 800, 1081

Deed Records Book 107 Page 11
123 429
128 705

NARRATIVE: This survey was performed at the request of Carl Sheedy. The purpose of this survey was to locate the existing fence line as shown hereon for the purpose of a boundary agreement line. Also to the purpose of a boundary agreement line as shown hereon for delineate the tract of land shown which Mr. Sheedy is acquiring from his adjoining neighbor, Dennis Dahl. The location of the monuments set during this survey were approved by Mr. Sheedy and Mr. Dahl. The locations were pointed out to me by Mr. Sheedy. This survey is tied to the nearest known monumented government survey corner as described hereon. I found no unusual conditions with this survey.

REGISTERED PROFESSIONAL LAND SURVEYOR

OREGON
JULY 12, 1963
ROBERT D. BAGETT
598

RECEIVED AND FILED

JAN 2 4 1990

OFFICE OF COUNTY SURVEYOR
Attest:

BAGETT - GRIFFITH & ASSOCIATES
John Day, Oregon

MAP OF SURVEY
SITUATED IN SW1/4SW1/4 SECTION 32 T13S, R32E & IN GOV'T LOTS 2 & 3 OF SECTION 5, T14S, R32E, W.M.

GRANT COUNTY, OREGON

SURVEYED FOR	CARL SHEEDY	
SURVEYED BY	R.D.B. & J.L.W. & K.S.	1/10/90
Scale: 1"=200'	Drawn by: J.L.W.	

RECORD MAP OF SURVEY NO. 1130