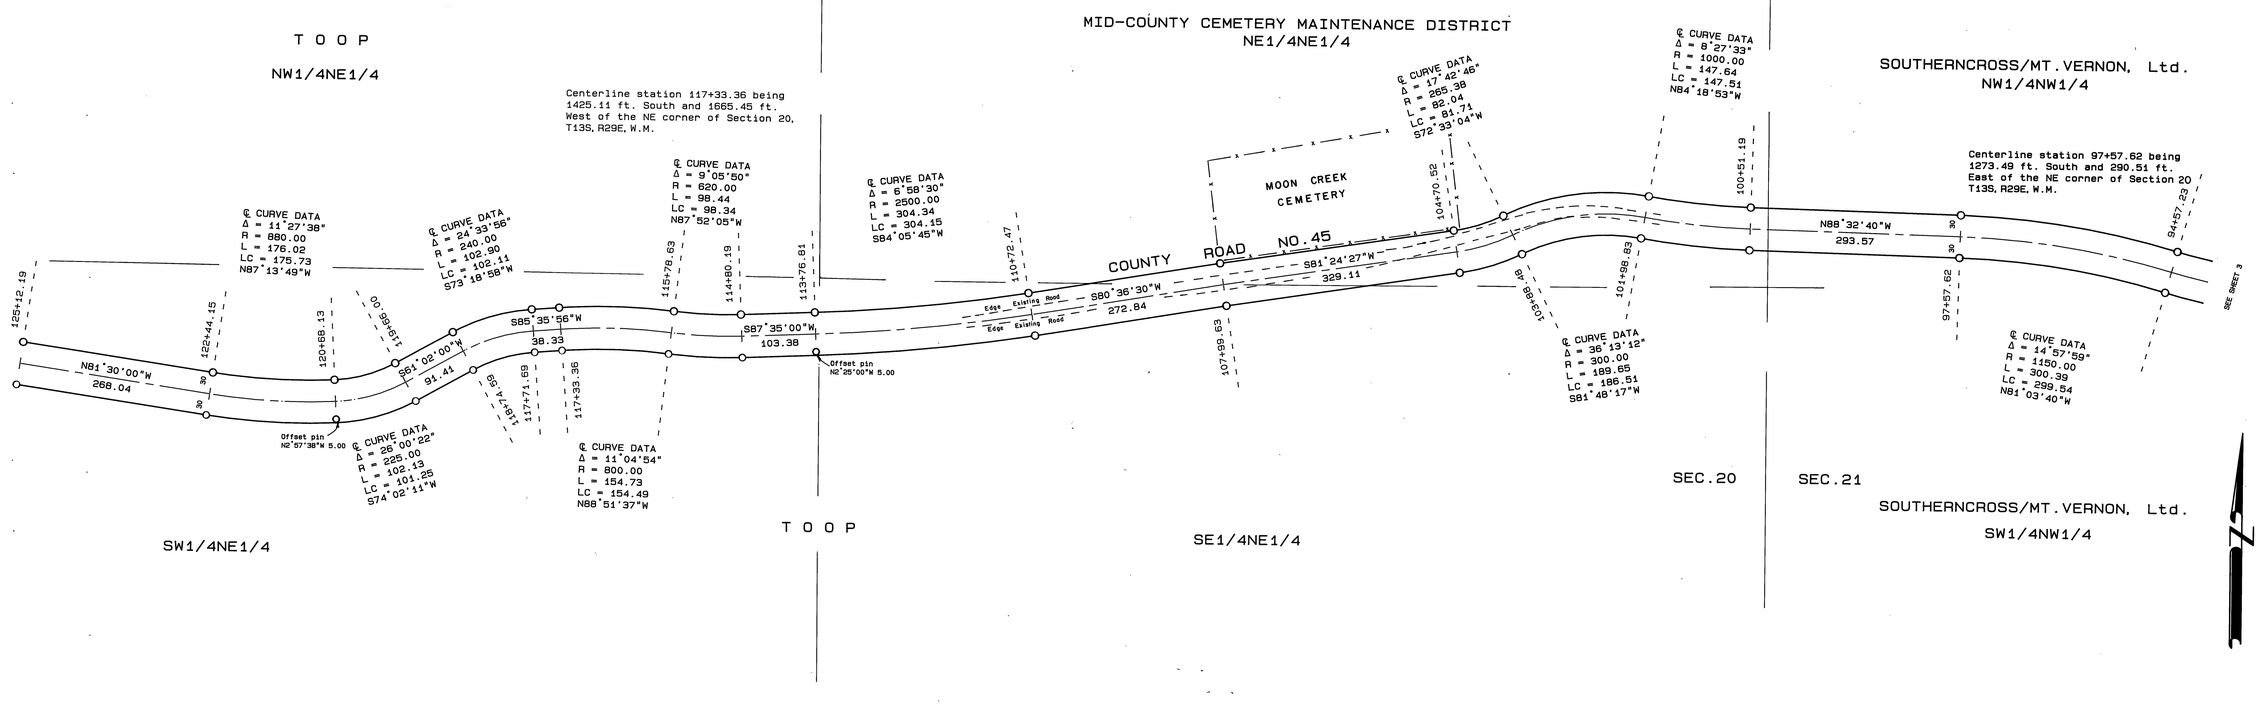


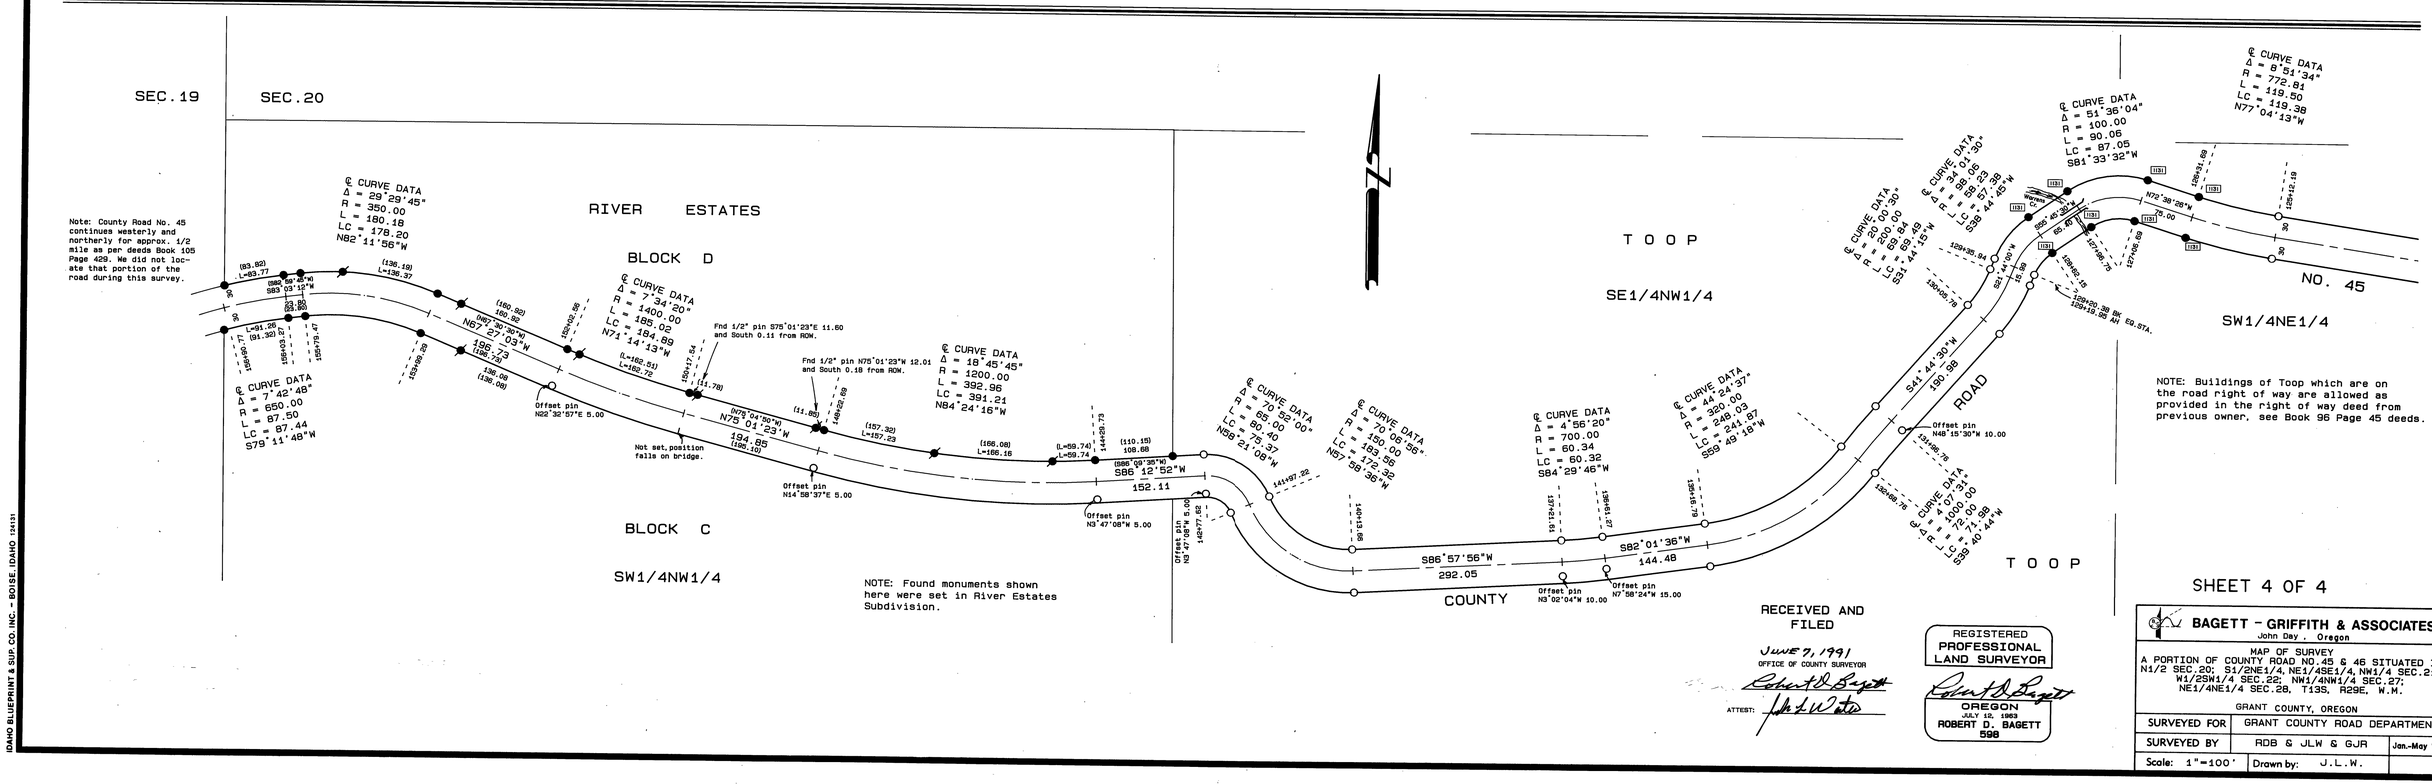


IDAHO BLUEPRINT & SUP. CO. INC. - BOISE, IDAHO 124131

RECORD MAP OF SURVEY NO.1133