



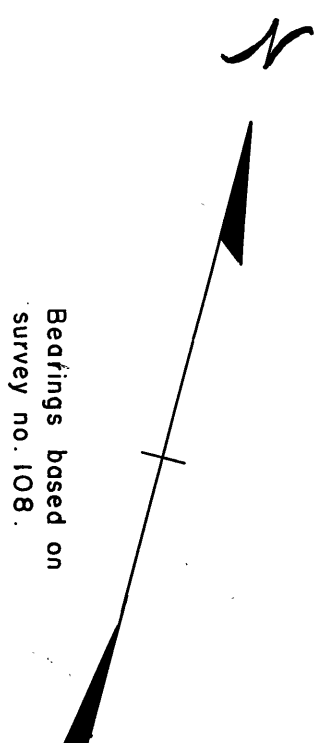

Bearings based on
survey no. 108.

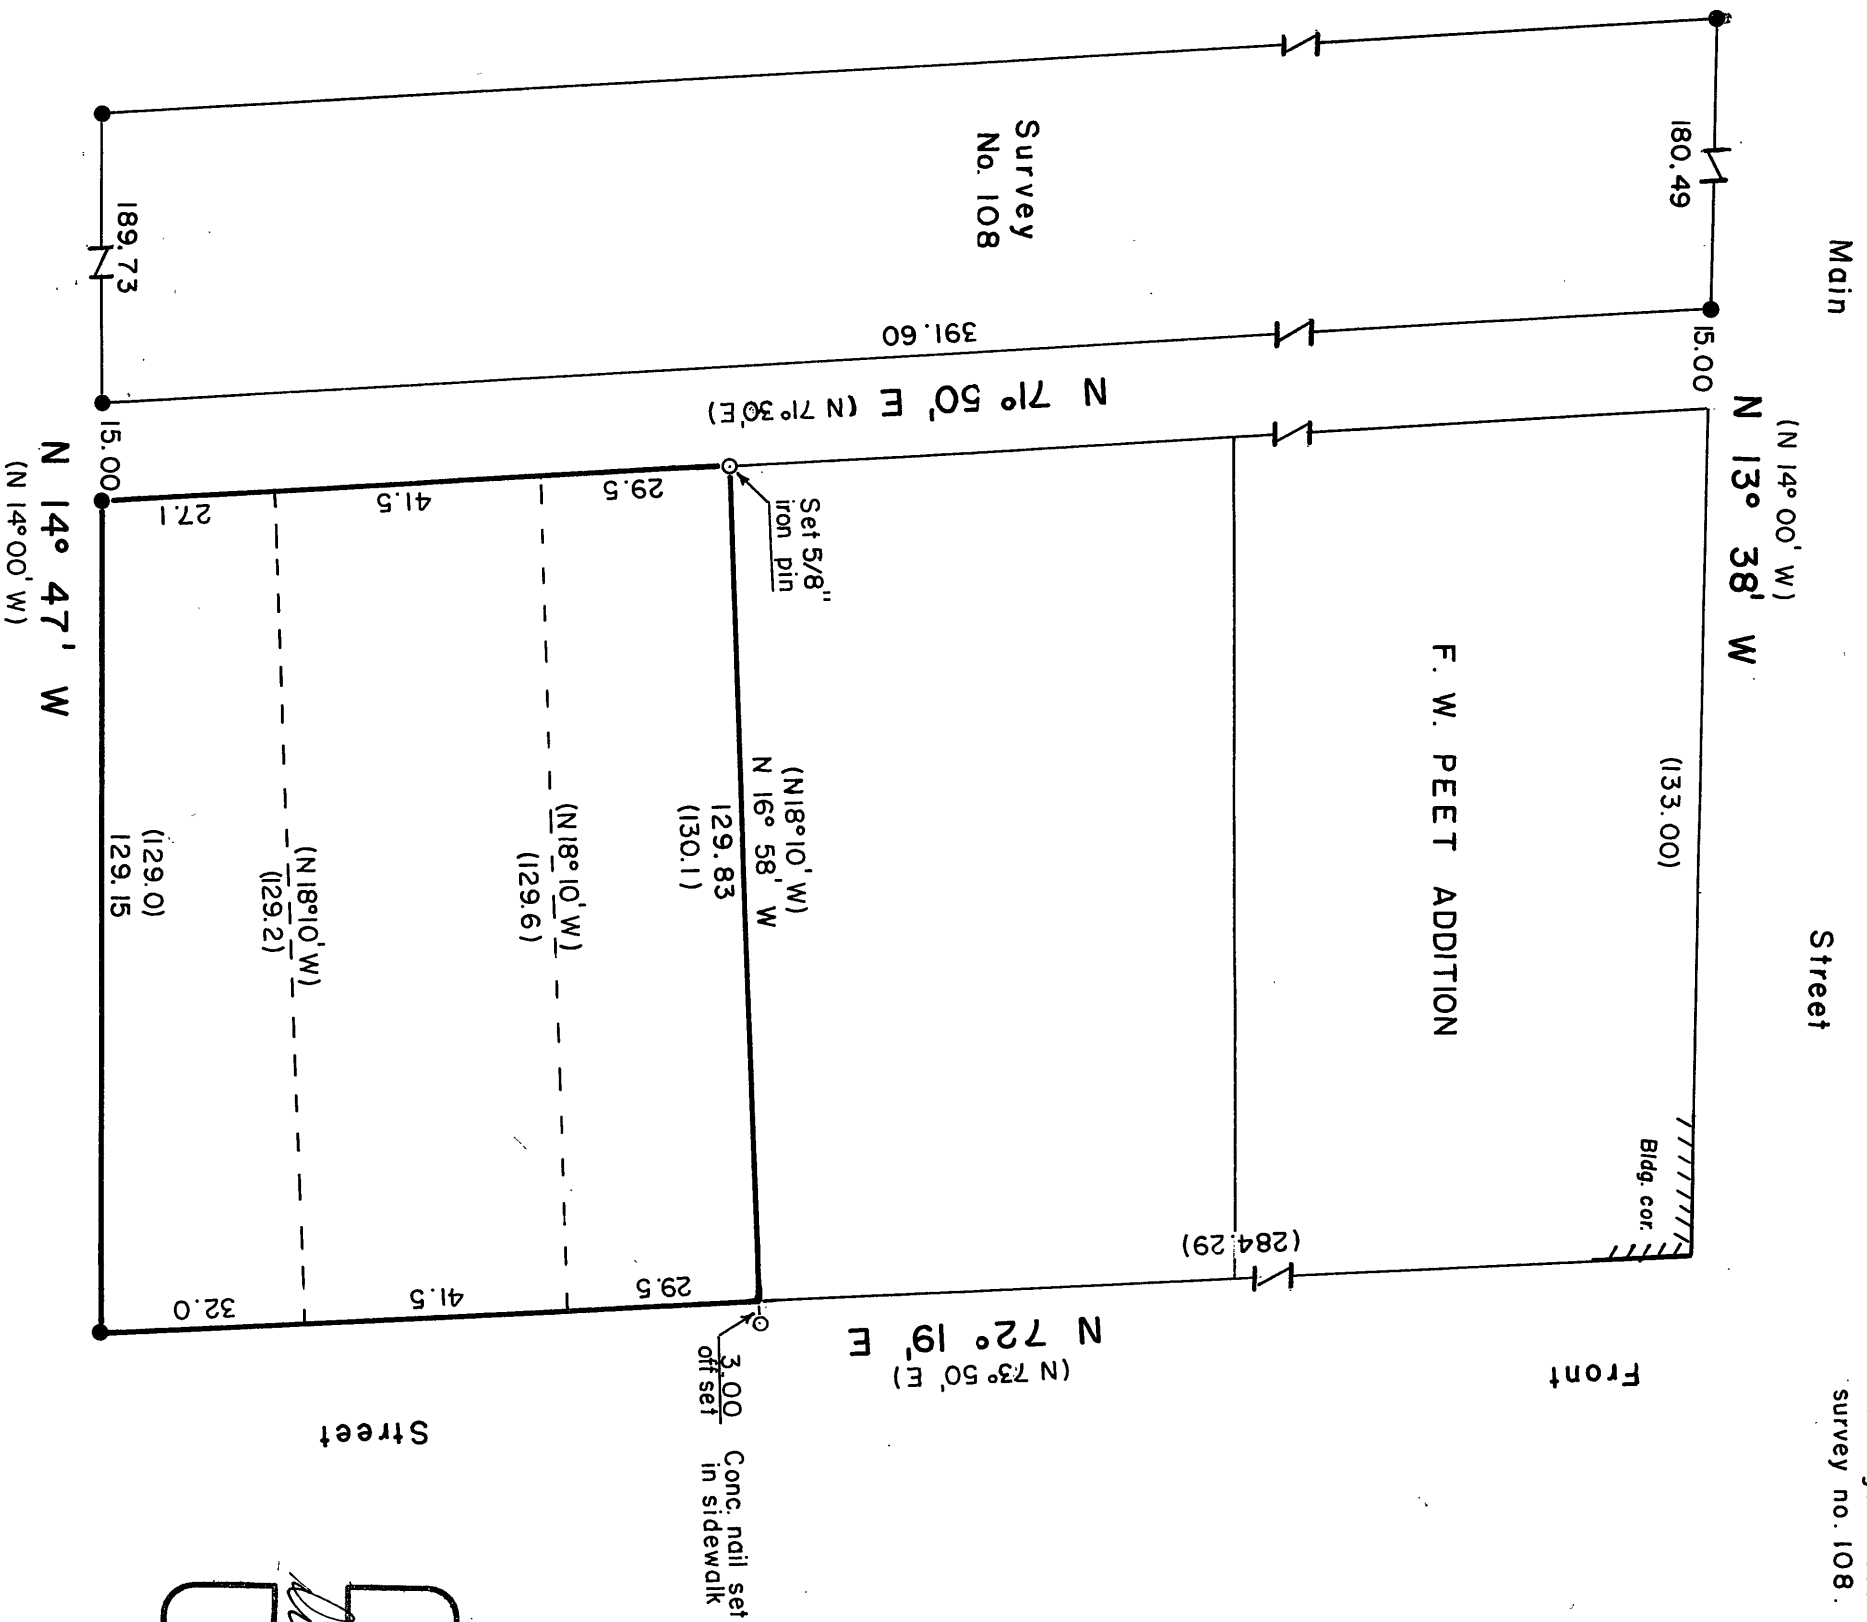

REGISTERED
OREGON
LAND SURVEYOR
John Day
JULY 10, 1964
DUANE I. GRIFFITH
644

BAGETT & GRIFFITH SURVEYING

John Day, Oregon

Map of Survey

Portion of the


PRAIRIE CITY

Grant County, Oregon

Surveyed for **FIRST NATIONAL BANK**

Surveyed by **R.D.B. & D.I.G.** 7/1968

Scale: 1 in. = 30 ft. Drawn by **DIG** 7/1968

**RECEIVED AND
FILED**

AUG 8 1968

JOHN LIVEIRA, County Clerk

By *John Liveira* Deputy

• Fd. monuments

○ Monuments set this survey

Survey Map # 115