

MAP OF SURVEY

BUM CADASTRAL SURVEY No. 53-04KK-8-02421
SECTIONS 15, 21, 22, 27, 28, 33 & 34, T9S, R31E

AND
SECTIONS 4, 9 & 15, T10S, R31E, WM,
GRANT COUNTY, OREGON

NARRATIVE OF SURVEY

difference was less than 0.10 foot, otherwise, the distance was checked to determine the cause of the discrepancy.

The instrument used was an OMNI Total Station with a built-in data collector. Data was transferred to a TRS-90 Model 100 computer with a 20MB disk drive which reduced the data, balanced the traverse, if within the survey standards specified in the contract and Oregon State Board of Surveying rules. Traverse data was entered on an Epson 80 column printer. The data and all necessary bearings and distances were measured with the total station with the control traverse being the basis for bearings.


Survey Evaluation
Rufus Moore is notorious for less than adequate work while performing the original GLO surveys. It has been found by others that he seldom marked the corner stones and I found that to be true in this project area. Only one or two stones were found with two bearing trees at something other than record. Otherwise with the records in the original field notes. After the traverses were run and computed corner locations determined, a careful search usually would turn up a rock of proper size which was usually accepted as the corner stone.

The CERTIFIED RECORDS OF LAND CORNER MONUMENTATION as recorded in the office of the Grant County Surveyor, located on this map and as shown in the Proof of Record, are hereby certified or maintained by this survey as hereby made a part of this narrative to provide detailed corner information. All recorded documents for this project contain the Forest Service contract number as shown in the CERTIFICATION as a cross reference and identifier for this survey.

Respectfully submitted this 26th Day of January, 1990.

CERTIFICATION

I, Leland Lee Myers, a Professional Land Surveyor, registered in the State of Oregon, Office located at 1000 S. 2nd St., Box 86, Sumpter, OR 97877, do hereby certify that I did perform this survey from July 24 to November 25, 1989, at the request of USDA-Forest Service by Bum Cadastal Survey Contract No. 53-04KK-8-02421 and that the information shown hereon is correct to the best of my knowledge.

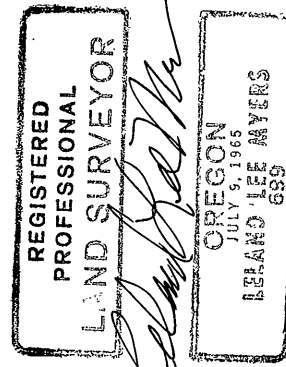

Examined and Accepted for the U.S. Forest Service this 26th Day of February, 1990.

RE Davis COR

I certify that this survey was performed at the request of the Melheur National Forest.

Charles R. Huber Date 2/24/90
Forest Supervisor

PROOF OF RECORDING

The following CERTIFIED RECORDS OF LAND CORNER MONUMENTATION in T9S & T10S, R31E, WM, were received from Leland Lee Myers, PLS 635 with this Map of Survey to be entered into the official county surveyor records.

Corner Index Nos. No. of Corners Monumented

T9S, R31E: J-15, L-13, L-15, L-17, M-16, M-17, N-11, N-13, N-15, N-16, O-16, O-17, P-9, P-11, P-13, P-17, R-9, R-10, R-11, R-13, R-15, R-17, T-9, T-10, T-11, T-13, T-15, T-17, U-9, U-16, V-9, V-10, V-11, V-13, V-15, V-16, V-17, X-9, X-10, X-11, X-13 & X-17 44

T10S, R31E: A-9, A-10, A-11, A-13, C-9, C-10, C-11, C-13, D-10, D-11, E-9, E-11, E-13, G-9, J-9, J-11, J-13, J-15, J-17 & L-13 20


Total Corners Submitted with This Map 64

I hereby certify that the CERTIFIED RECORDS OF LAND CORNER MONUMENTATION listed above have been filed in the office of the Grant County Surveyor this 26th day of July, 1990.

Robert D. Bryant
Grant County Surveyor

LEGEND

- Section & 1/4 Corners Previously Set
- Section & 1/4 Corners Set by Found Evidence
- Section & 1/4 Corners Set by Survey
- C1/4 Corners Set by Survey
- 1/16 Corners Set by Survey
- Posted National Forest Boundary Lines
- NF Boundary Not Posted This Survey
- Section Lines
- Center of Section Lines
- Sixteenth Section Lines
- Projected Lines
- Record GLO Bearing and Distance
- Legal Subdivision of USFS Property
- Certified Corner Record Index No. See Corner Restoration Records
- Monuments Set this Survey are 2" Aluminum Pipes with 2 1/2" Aluminum Cap

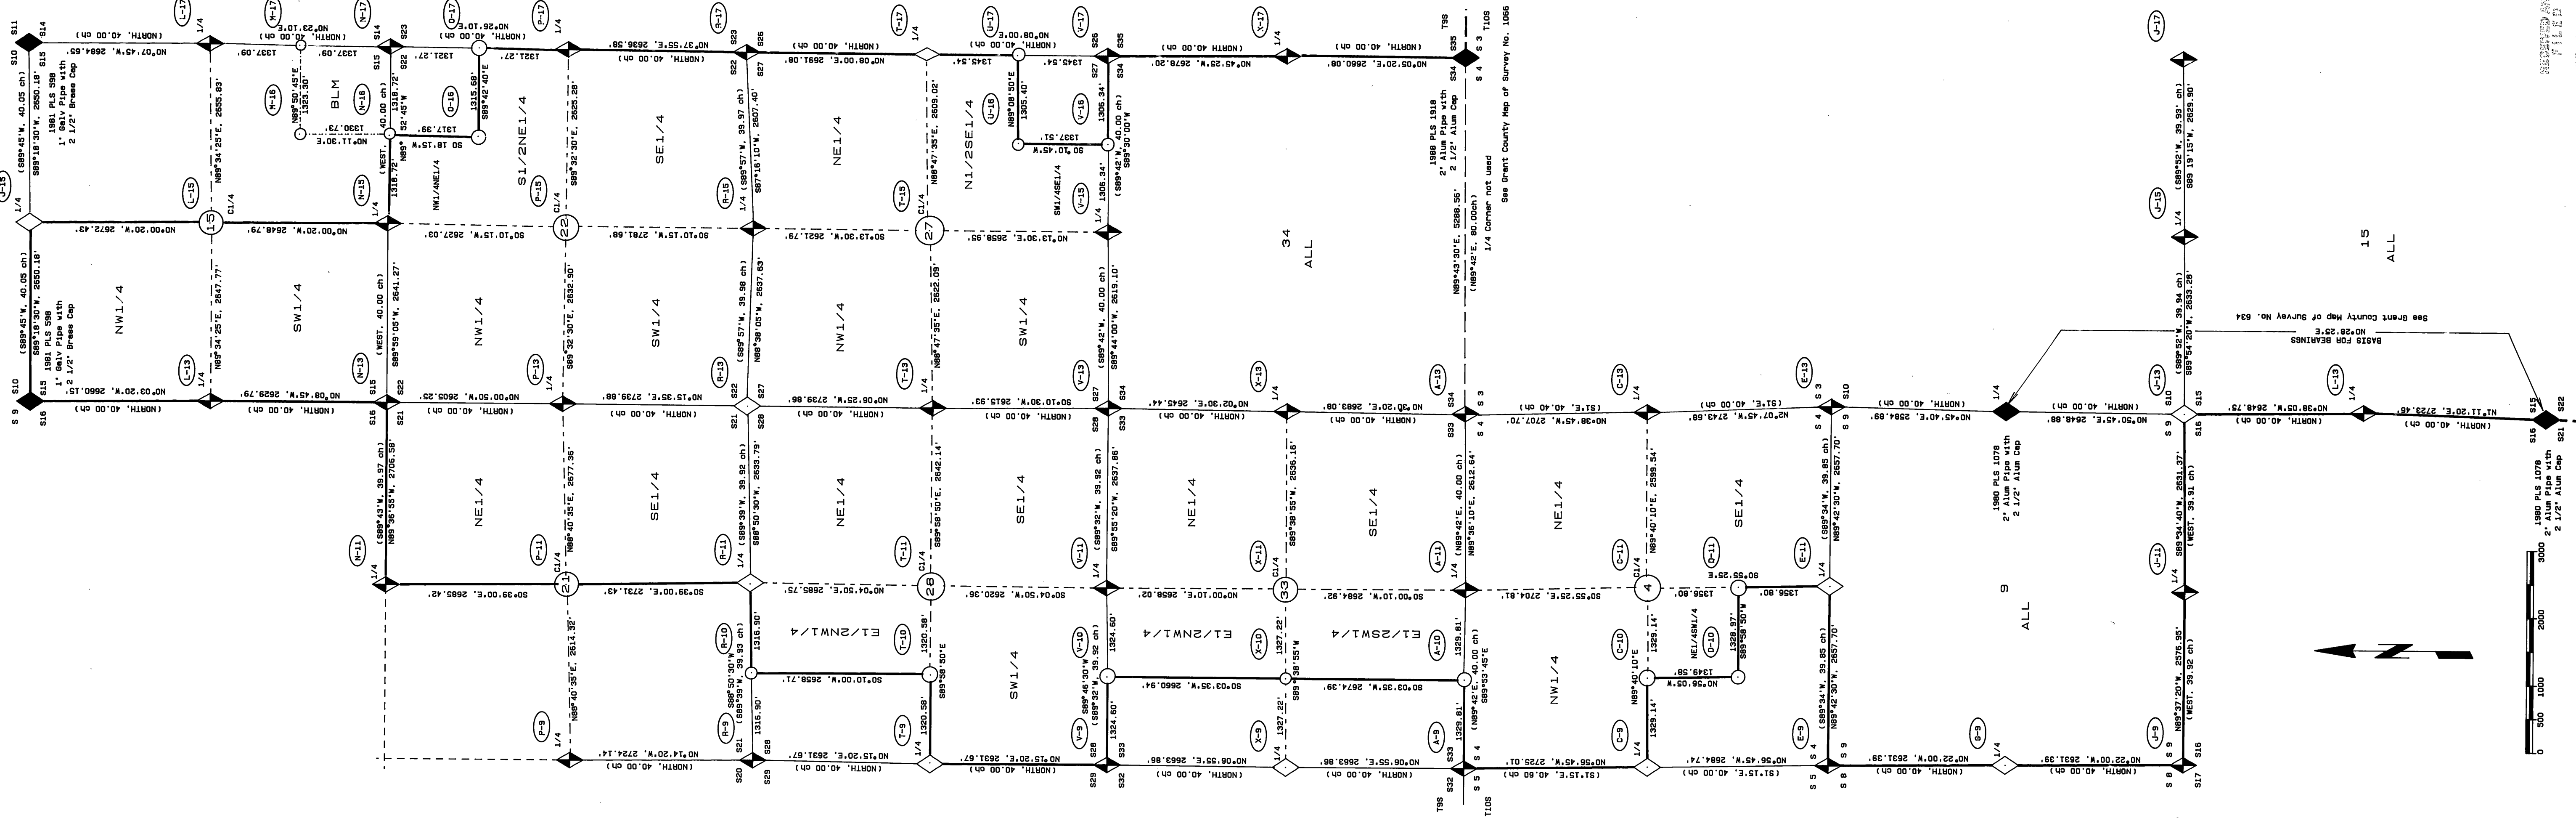

RECORDED AND FILED
JUL 26 1990
Grant County, Oregon