


BASIS OF BEARINGS
Solar Observation

REGISTERED
OREGON
LAND SURVEYOR

Robert D. Bagett

JULY 12, 1963
ROBERT D. BAGETT
598

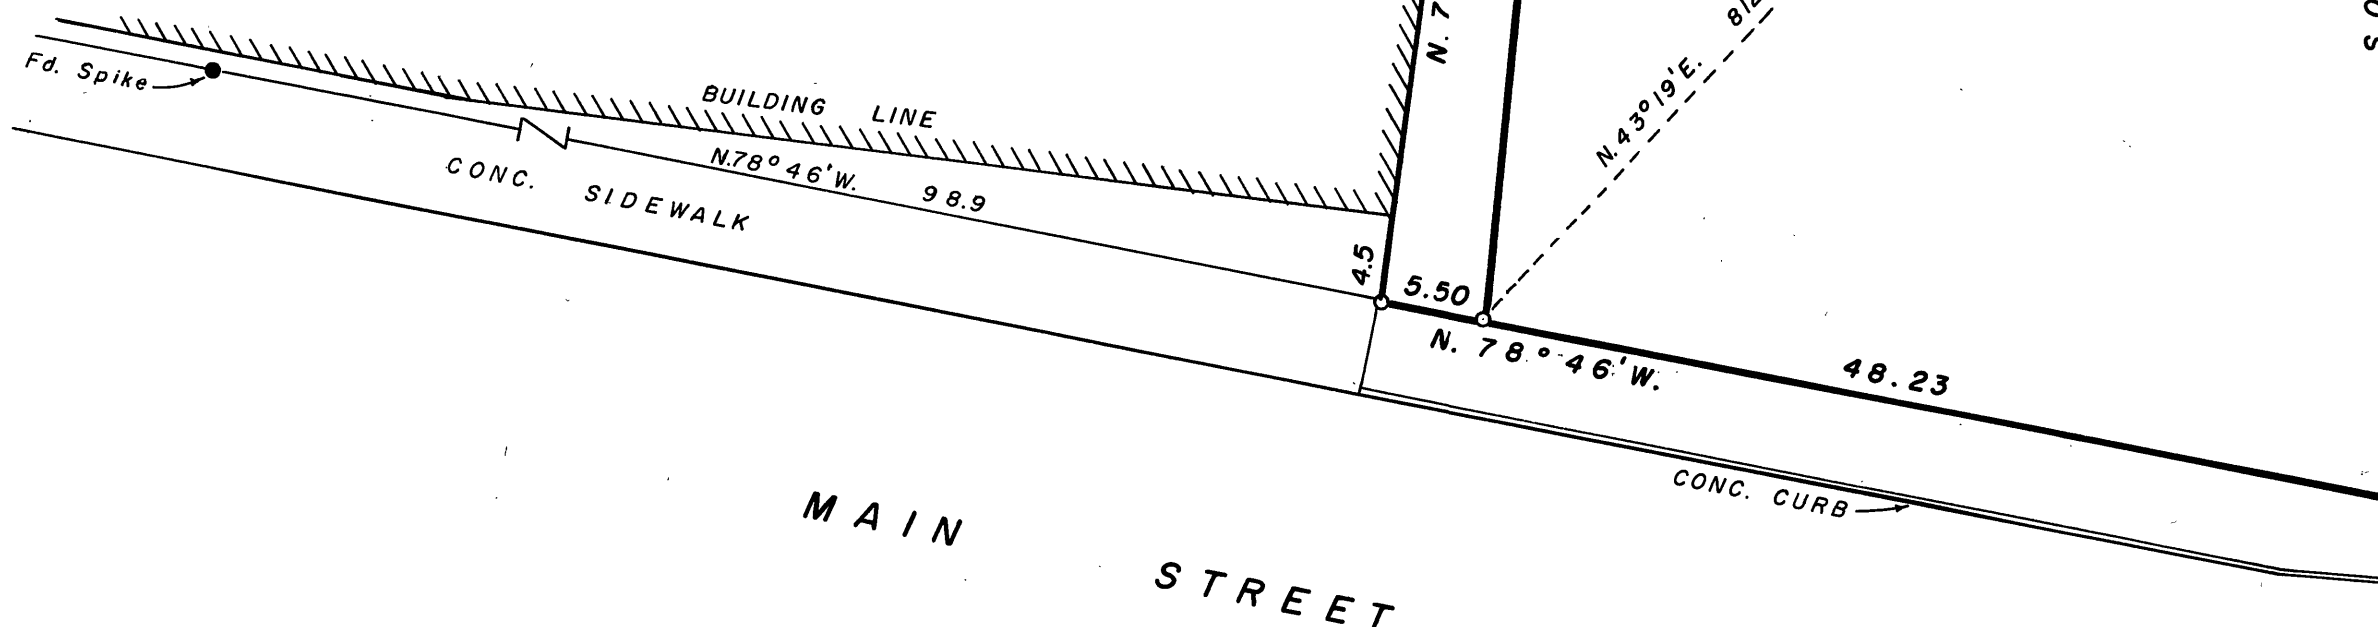

LEGEND

- Monuments found
- Monuments set (5/8" x 24" iron pins)

RECEIVED AND
FILED
JUL 15 1968

JOHN LIVEIRA, County Clerk
By _____ Deputy

BAGETT & GRIFFITH SURVEYING
John Day, Oregon
Map of Survey

2 PARCELS IN BLOCK "E"
JOHN DAY, OREGON

SURVEYED FOR	WALLY MUZZY		
SURVEYED BY	R.D.B. & D.I.G.	8/31/68	
Scale: 1" = 10'	Drawn by R.D.B.	9/4/68	