

By:	Date:
Designed: Chuck Borstad	8-85
CADD: Paul Baker	8-85
Checked:	
Approved:	

RIGHT OF WAY PLANS

PLANS PREPARED BY
U. S. DEPARTMENT OF TRANSPORTATION
FEDERAL HIGHWAY ADMINISTRATION
WESTERN DIRECT FEDERAL DIVISION

FOR


OREGON FOREST HIGHWAY PROJECT 1 15-1 (1) MIDDLE FORK JOHN DAY RIVER HIGHWAY

LENGTH 8.184 MILES

MALHEUR NATIONAL FOREST
GRANT COUNTY
OREGON

STATE	PROJECT	SHEET NO.	TOTAL SHEETS
OR	FH 1 15-1 (1)	1	19

INDEX TO SHEETS	
SHEET NO.	DESCRIPTION
1	TITLE SHEET
2-4	VICINITY MAP
5-19	PLAN SHEETS

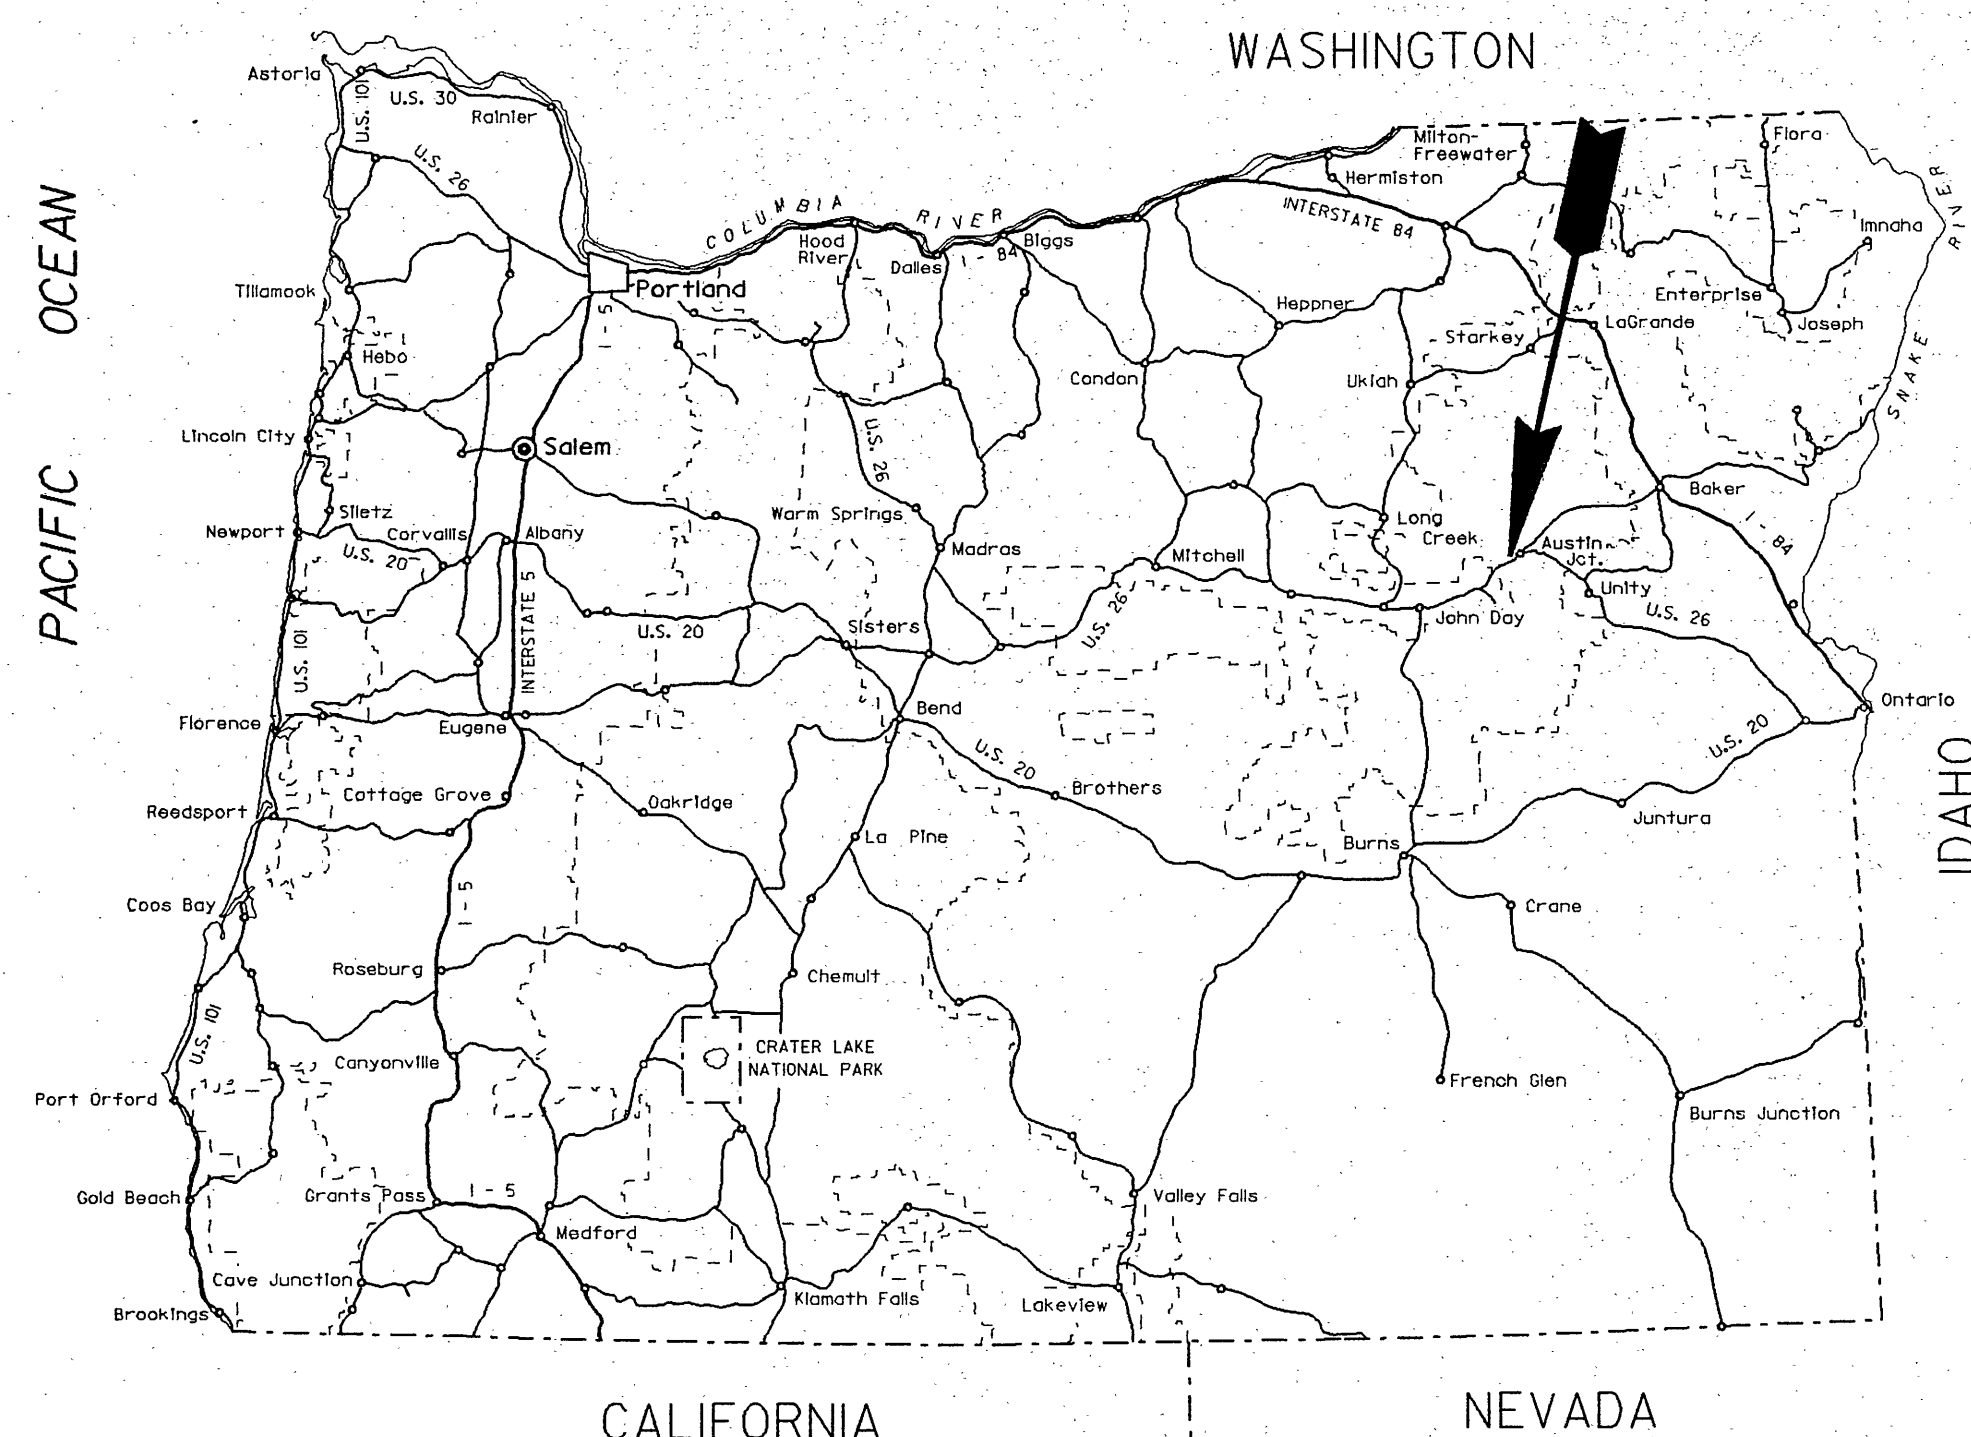


KEY MAP OF OREGON

LEGEND:

CONVENTIONAL SYMBOLS

TOWNSHIP OR RANGE LINE	---
SECTION LINE	----
QUARTER SECTION LINE	-----
SIXTEENTH LINE	-----
NATIONAL PARK OR FOREST BOUNDARY	
PROPERTY LINE with COMMON OWNERSHIP	P/L
RIGHT-OF-WAY LINE	EXISTING PROPOSED
RIGHT-OF-WAY MONUMENT	EXISTING
Reference Monument Set 5/8"x30" Pin w/ Plastic Cap Stamped ORLS-645	TOP OF CUT TOE OF FILL
CONSTRUCTION SLOPE LIMITS	---
PRESENT ROADWAY	---
RAILROAD	---
MARSH LAND	---
DRAINAGE (INTERMITTENT)	---
CREEK	---
MATERIALS SOURCE (small scale map)	---
STOCKPILE SITE (small scale map)	---
SECTION CORNER	FOUND PROJECTED
QUARTER CORNER	---
SIXTEENTH or PROPERTY CORNER	---
CENTER OF SECTION	---
FENCE	EXISTING PROPOSED
GATE	---
GUARDRAIL	---
SIGNS	POST MOUNTED PORTABLE
RETAINING WALL	NS wall face TT
POWER POLE	---
TELEPHONE or TELEGRAPH POLE	---
JOINT USE POLE	---
SUPPORT POLE with ANCHOR	---
UNDERGROUND UTILITIES	---
W(water), E(electrical), G(gas), T(telephone) S(sanitary sewer), S(sanitary sewer), G(gas)	---
ROAD APPROACH	---
BRIDGE	---
CULVERT PIPE	---
CULVERT PIPE with END SECTION	---
NS=No Symbol, *See Standard Drawing	

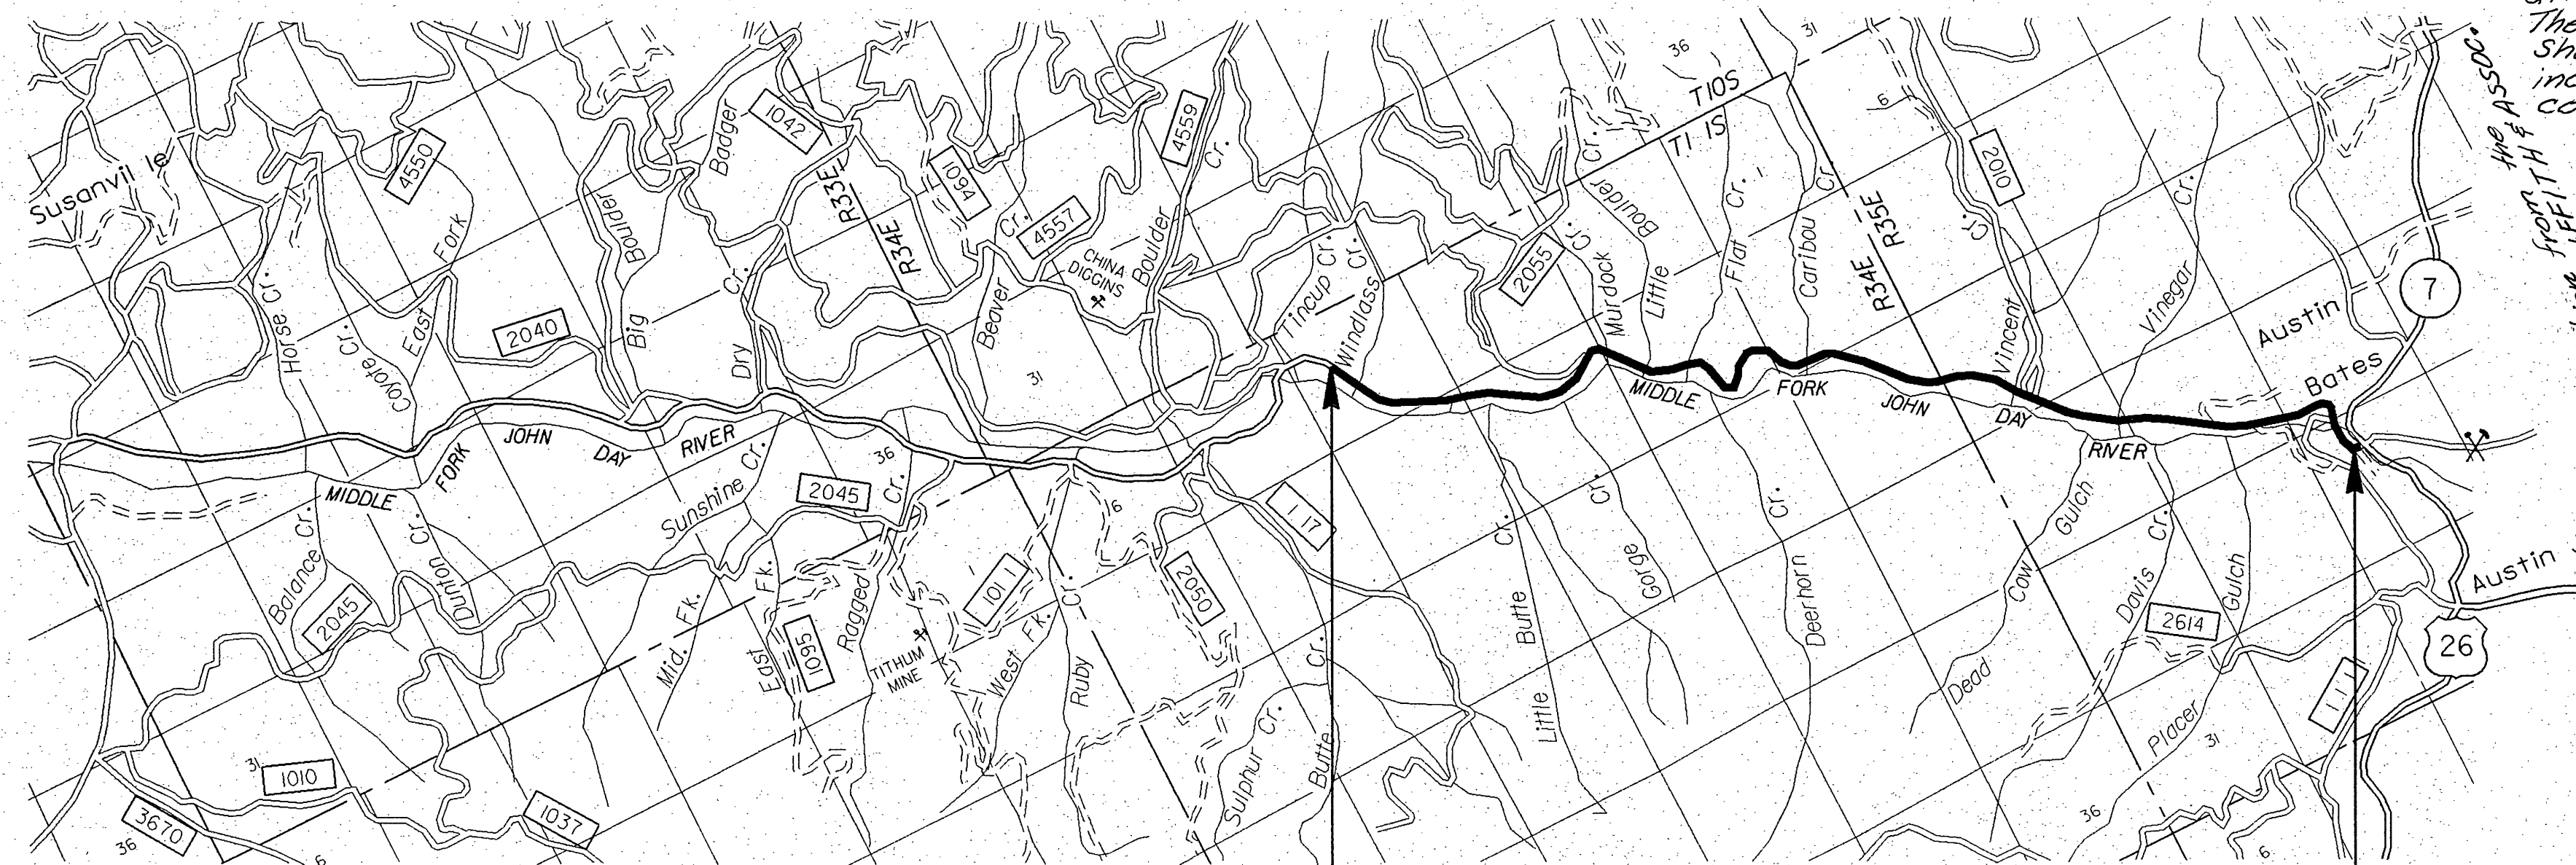

0 1 2 3
SCALE IN MILES

Sta. 389+00
END PROJECT
FH 1 15-1 (1)

30 Miles +
To John Day
Sta. 0+84.96
BEGIN PROJECT
FH 1 15-1 (1)

NARRATIVE:

I, James Hambleton, being a registered Land Surveyor in the State of Oregon, was employed by the Federal Highway Administration, to set REFERENCE MONUMENTS along 8.184 miles of right-of-way Center Line on the Middle Fork John Day River Highway Project No. 1-15-1(1).

I set 5/8"x30" iron pins w/ plastic caps stamped ORLS 645, at designated distances left and right of all PC's & PT's through out the length of this project.

The Reference Monuments as shown are the only part of this map which pertains to my stamp, all other data is from other sources. The Reference Monuments were set during August 1988. Sheets 2-4 do not pertain to my survey, therefore are only included for the County's convenience.

REGISTERED
PROFESSIONAL
LAND SURVEYOR
James H. Hambleton
3-4-91
JULY 10, 1984
JAMES H. HAMBLETON
645

RECEIVED AND
FILED
MAR 12 1991
OFFICE OF COUNTY SURVEYOR
Baker, Oregon

Hambleton Construction
Surveying
Rt. 1 Box 20A
Baker Oregon 97814
503-523-3388