



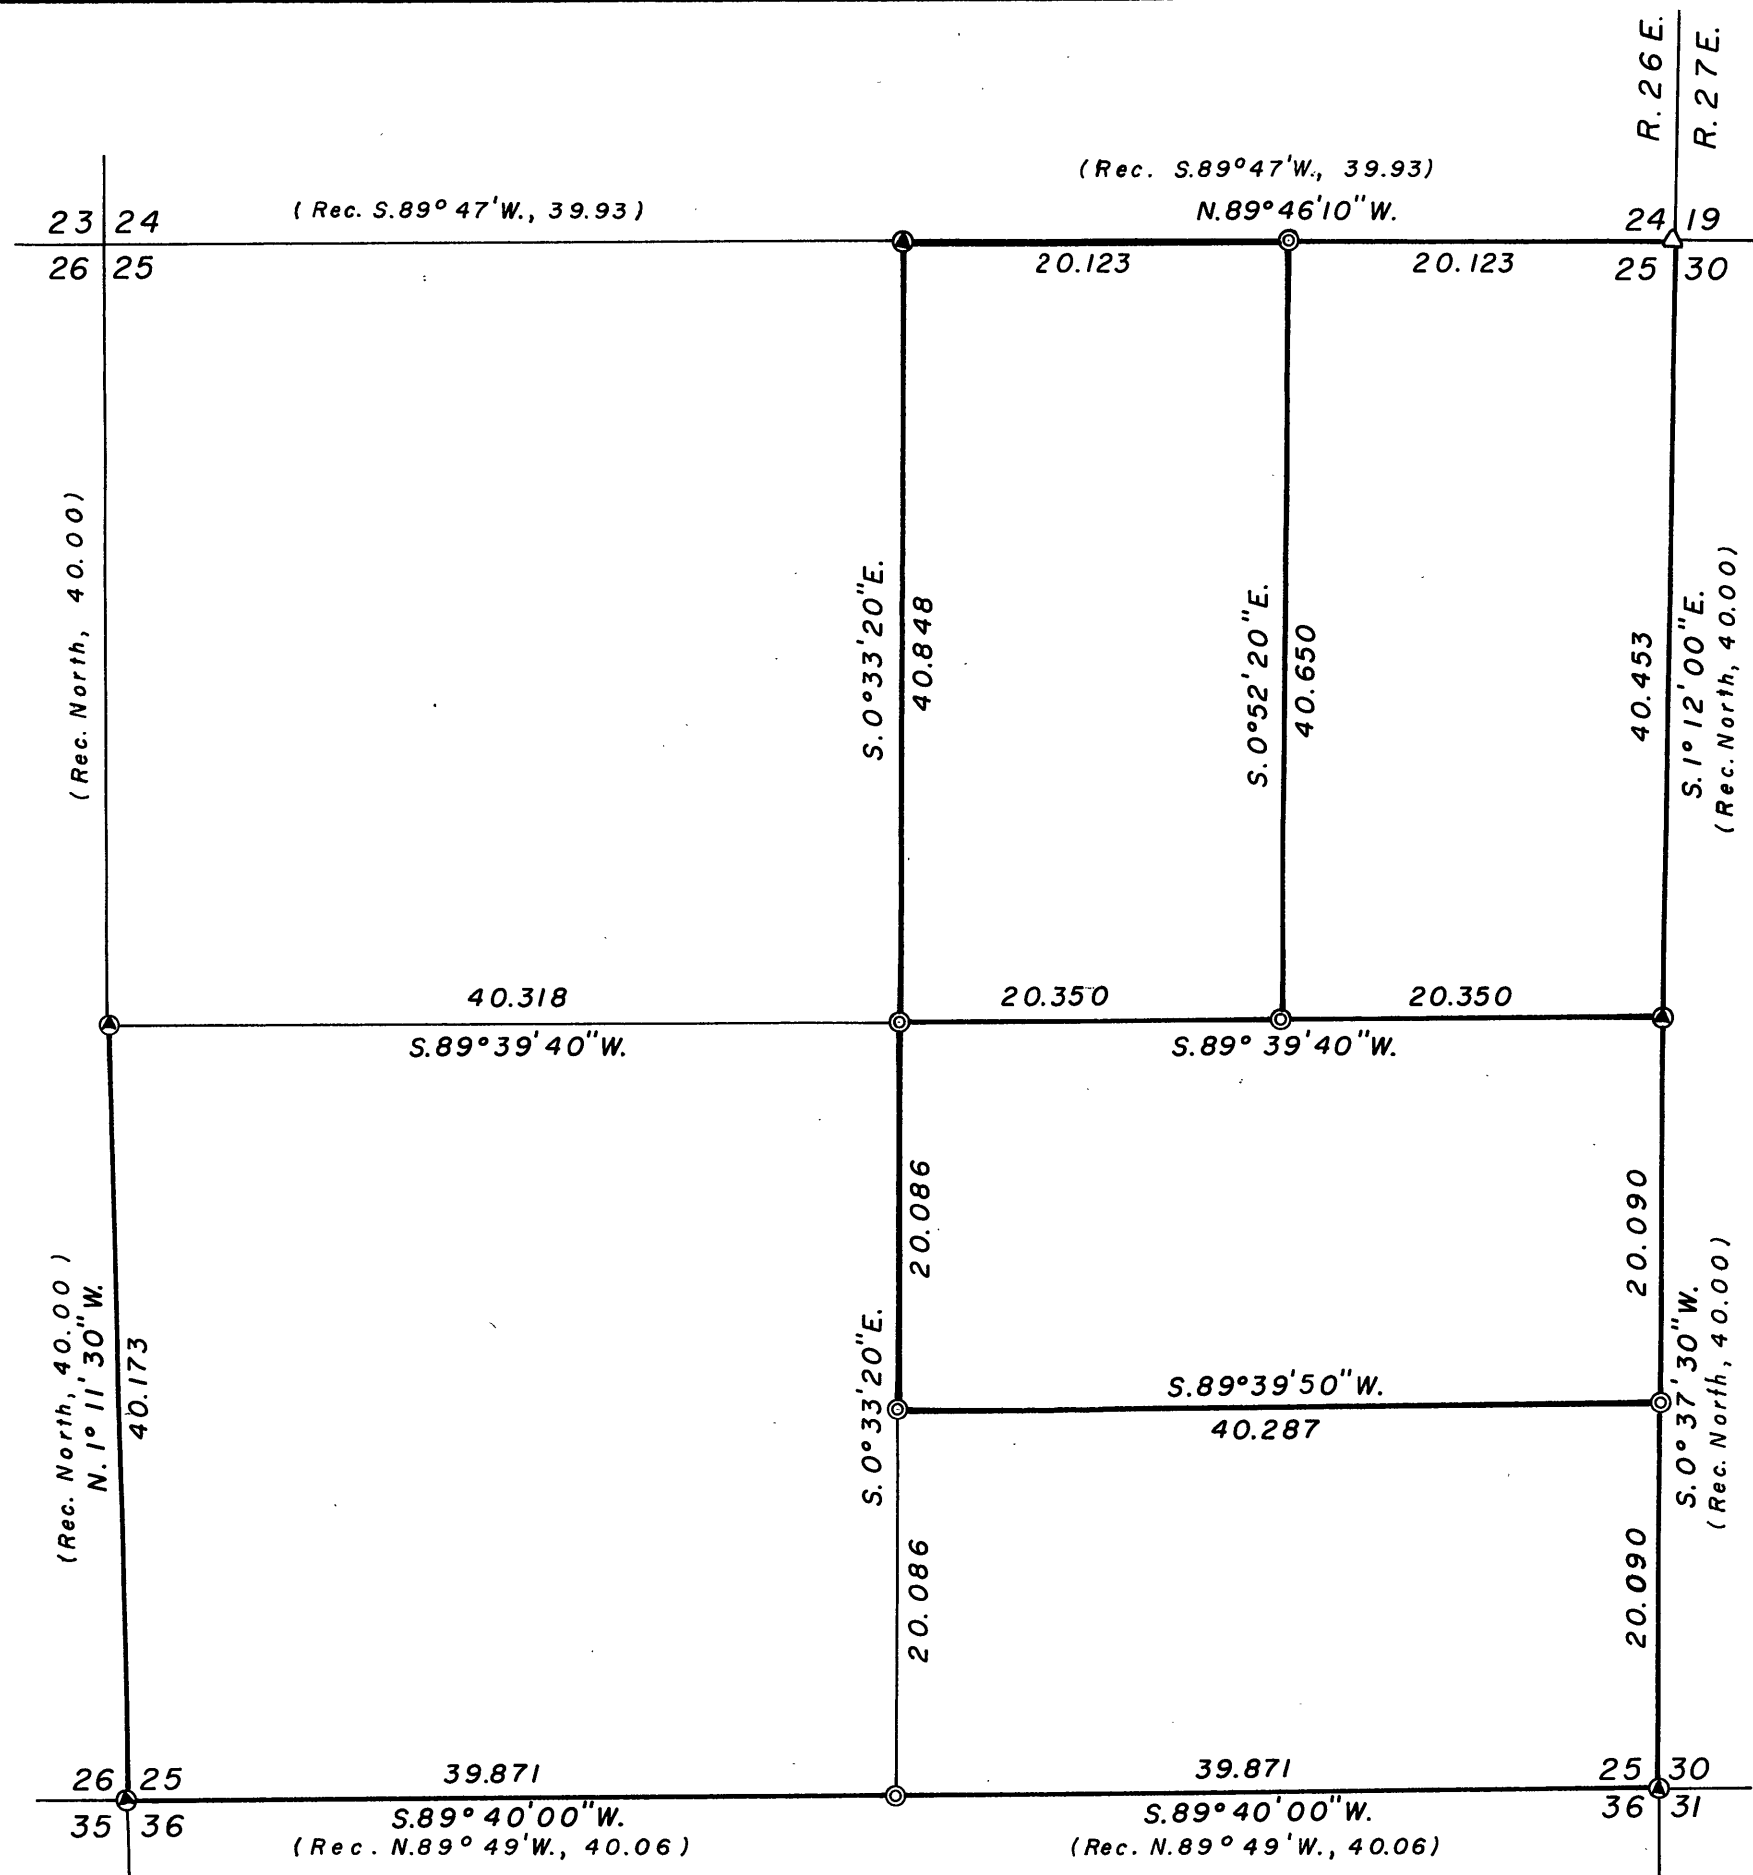

- LEGEND**
- ⊙ Set 1 1/4" x 30" iron pipe
 - △ Found monument
 - Found mon. replaced with iron pipe, this survey.

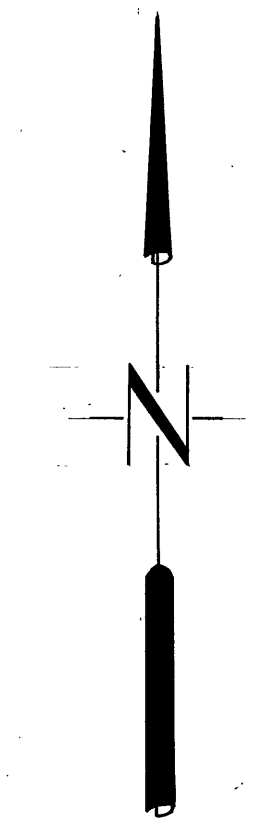

BASIS OF BEARINGS
Solar observation
at NE cor. of section

REGISTERED
OREGON
LAND SURVEYOR

Robert D. Bagett
JULY 12, 1963
ROBERT D. BAGETT
598

RECEIVED AND
FILED
APR 13 1971
John Liveira
JOHN LIVEIRA, County Clerk

Note: Field notes filed By _____ Deputy

BAGETT & GRIFFITH SURVEYING		
John Day, Oregon		
MAP OF SURVEY		
W 1/2 NE 1/4 & N 1/2 SE 1/4		
T. 11 S., R. 26 E., W. M.		
Surveyed for	Mrs. George L. Newell	
Surveyed by	R.D.B. & D.I.G.	7 / 68
Scale: 1" = 10 chains	Drawn by R.D.B.	8 / 68

Survey Map # 117