TOWNSHIP 12 SOUTH, RANGE 30 EAST, OF THE WILLAMETTE MERIDIAN, OREGON

DEPENDENT RESURVEY

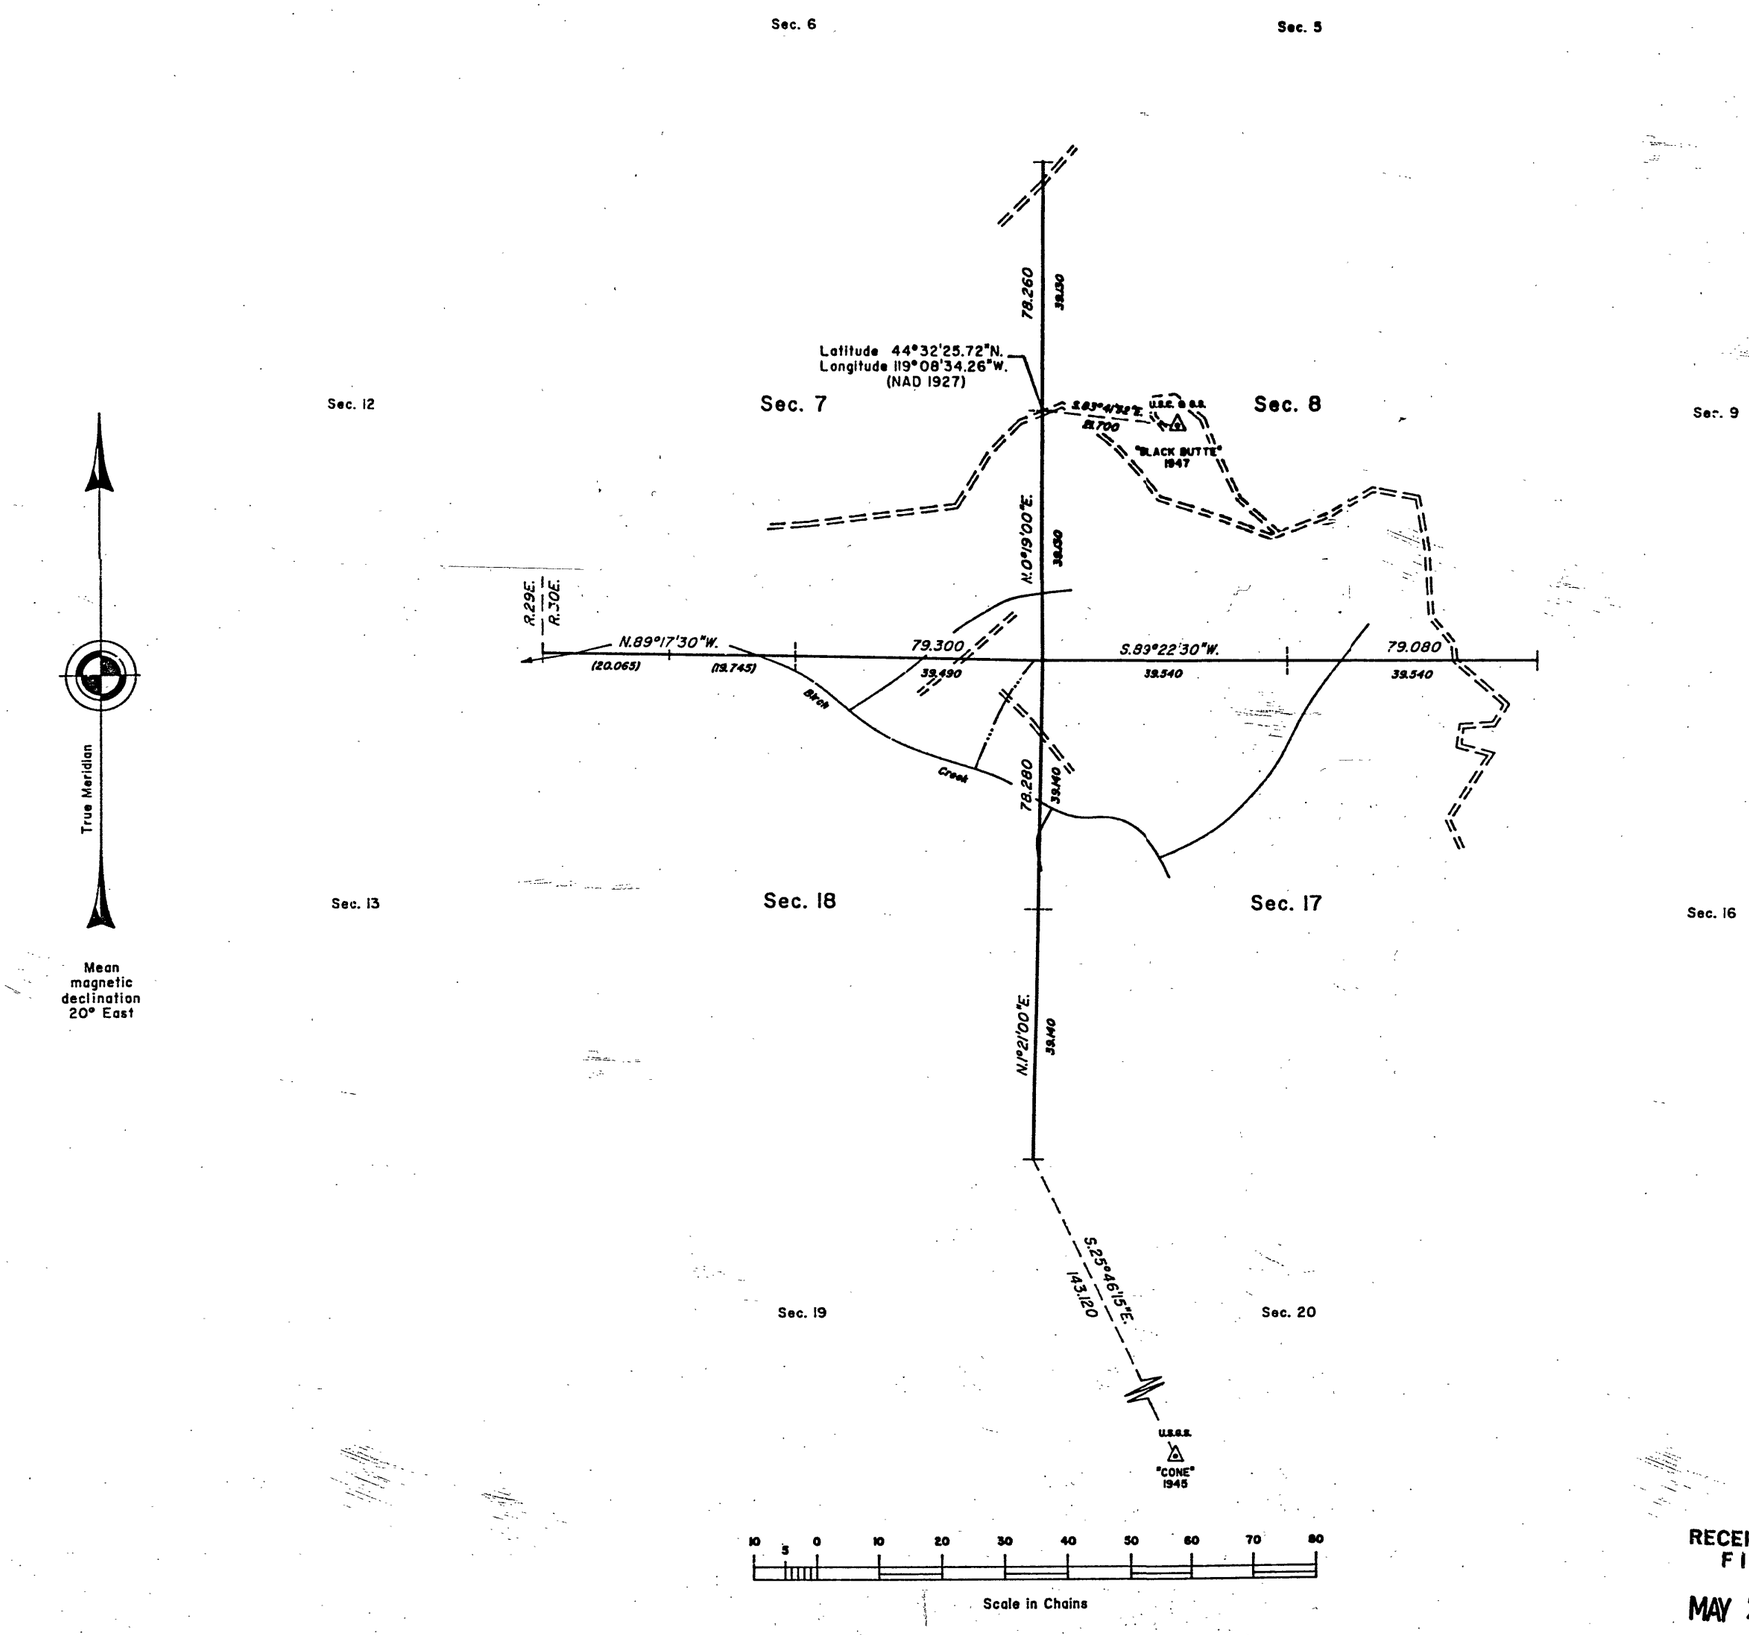

A history of surveys is contained in the field notes.

This plat represents a dependent resurvey of a portion of the subdivisional lines, T. 12 S., R. 30 E., Willamette Meridian, Oregon, designed to restore the corners in their true original locations according to the best available evidence.

The survey was executed by Philip G. Griffin, Cadastral Surveyor, beginning May 18, 1987, and completed May 24, 1990, pursuant to Special Instructions dated March 4, 1987, and Supplemental Special Instructions dated July 24, 1987, under Group Number 1366, Oregon.

Timber in this area consists of ponderosa pine, lodgepole pine, western larch and fir.

UNITED STATES DEPARTMENT OF THE INTERIOR
BUREAU OF LAND MANAGEMENT

Portland, Oregon — January 25, 1991

This plat is strictly conformable to the approved field notes, and the survey, having been correctly executed in accordance with the requirements of law and the regulations of this Bureau, is hereby accepted.

For the Director

Wayne M. Gardner

Chief Cadastral Surveyor of Oregon

RECEIVED AND FILED

MAY 22 1991

OFFICE OF COUNTY SURVEYOR

Attest: (copy)

MAP OF SURVEY NO. 1170

RFB