


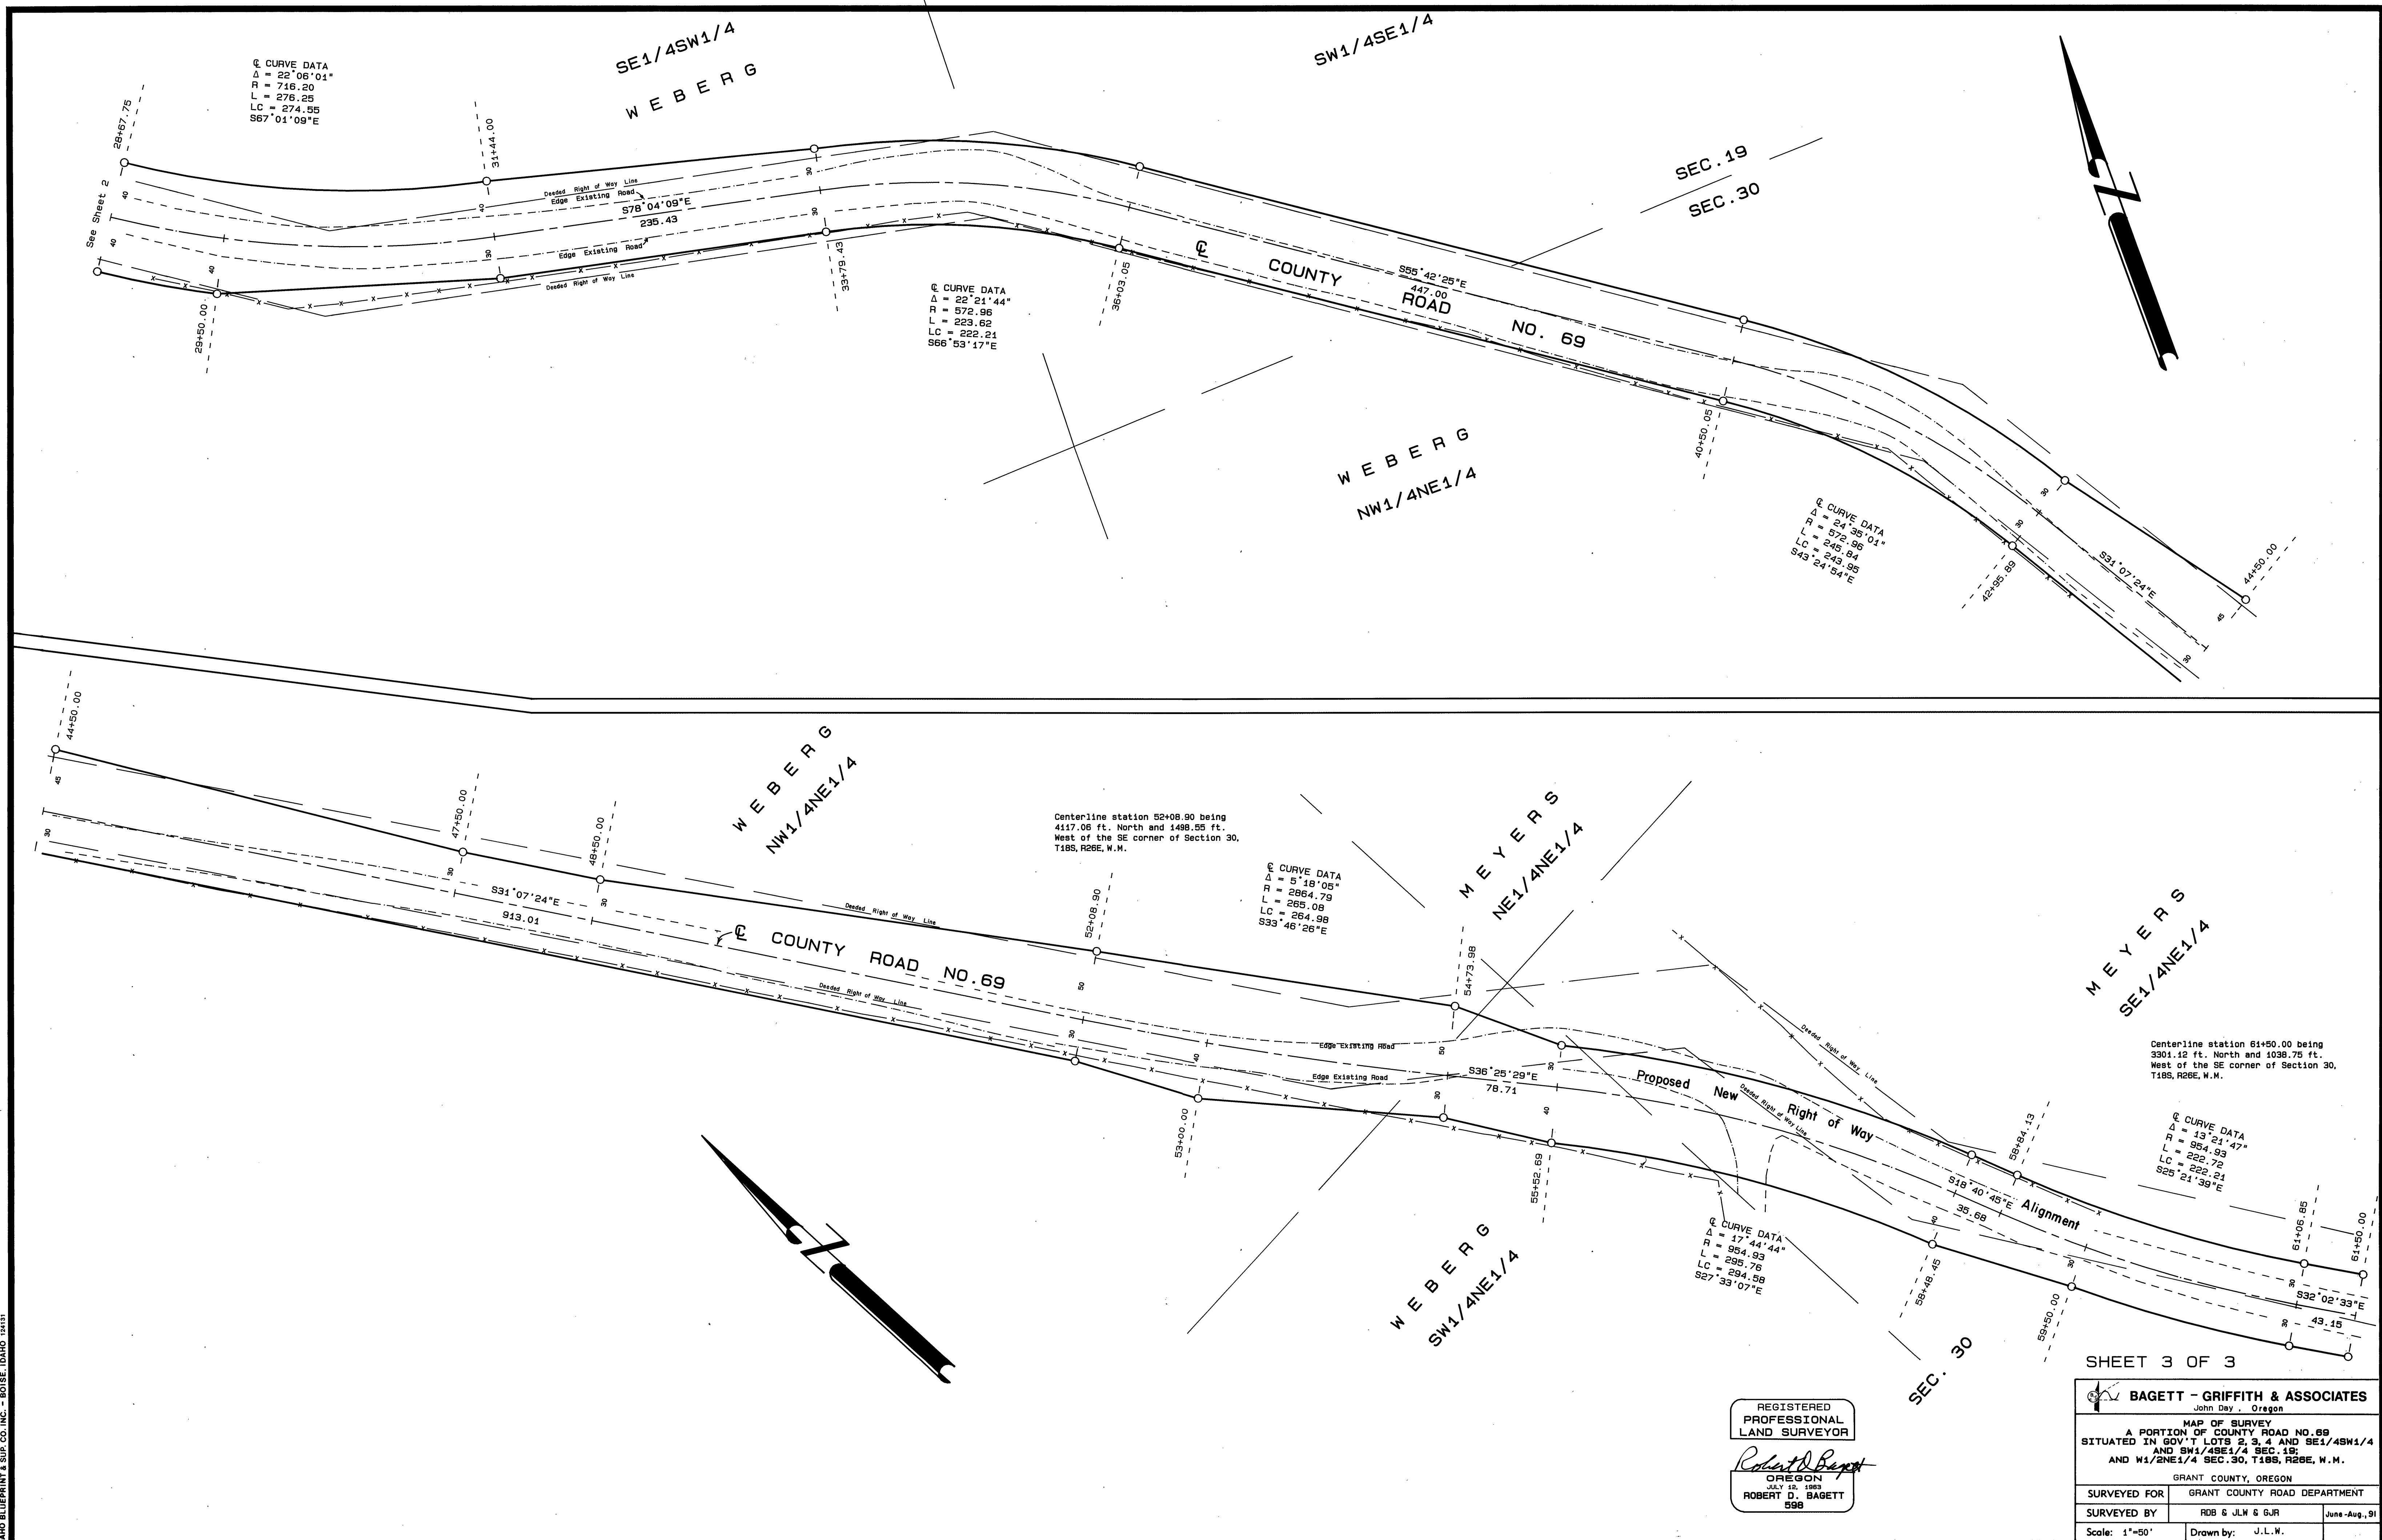

REGISTERED
PROFESSIONAL
LAND SURVEYOR

Robert D. Baggett

OREGON
JULY 12, 1989
ROBERT D. BAGGETT
599

BAGETT - GRIFFITH & ASSOCIATES		
John Day, Oregon		
MAP OF SURVEY		
A PORTION OF COUNTY ROAD NO. 69		
SITUATED IN GOV'T LOTS 2, 3, 4 AND SE1/4SW1/4		
AND SW1/4SE1/4 SEC. 19;		
AND W1/2NE1/4 SEC. 30, T18S, R26E, W.M.		
GRANT COUNTY, OREGON		
SURVEYED FOR	GRANT COUNTY ROAD DEPARTMENT	
SURVEYED BY	RDB & JLW & GJR	June-Aug., 91
Scale: 1"=50'	Drawn by: J.L.W.	