

Basis of Bearing:
Survey No. 679
Mid-section line
Section 8 = N. 0° 14' 26" E

T. 13 S., R. 34 E., W. 1 M.

NARRATIVE:

Survey was made for Joe Lane, ordered by Dave Kline, for the purpose of determining acreage in the 5/8 NE 1/4 and that part of the SE 1/4 of Section 8 lying North of the Grant County road.

Recovery was made of those monuments of record which govern this survey. Searches for the East quarter corner and the Northeast section corner were unsuccessful in identifying either original stone. The searches for these stones were extensive, due to the natural stony area in which they fall, and because the land has not been obviously disturbed, except for fence construction. The missing corners were then deemed "lost" and the survey was then extended North and East. Proportionate methods were then employed to position the missing corner locations, and the section was subdivided as shown herein.

RECEIVED AND
FILED


JUL 31 1991

OFFICE OF COUNTY SURVEYOR
Robert D. Bassett
Attorney: James E. Smith

REGISTERED
PROFESSIONAL
LAND SURVEYOR

James D. Hanley
OREGON
SEPTEMBER 21, 1977
JAMES D. HANLEY
1206

2043 Main St.
Baker, Oregon

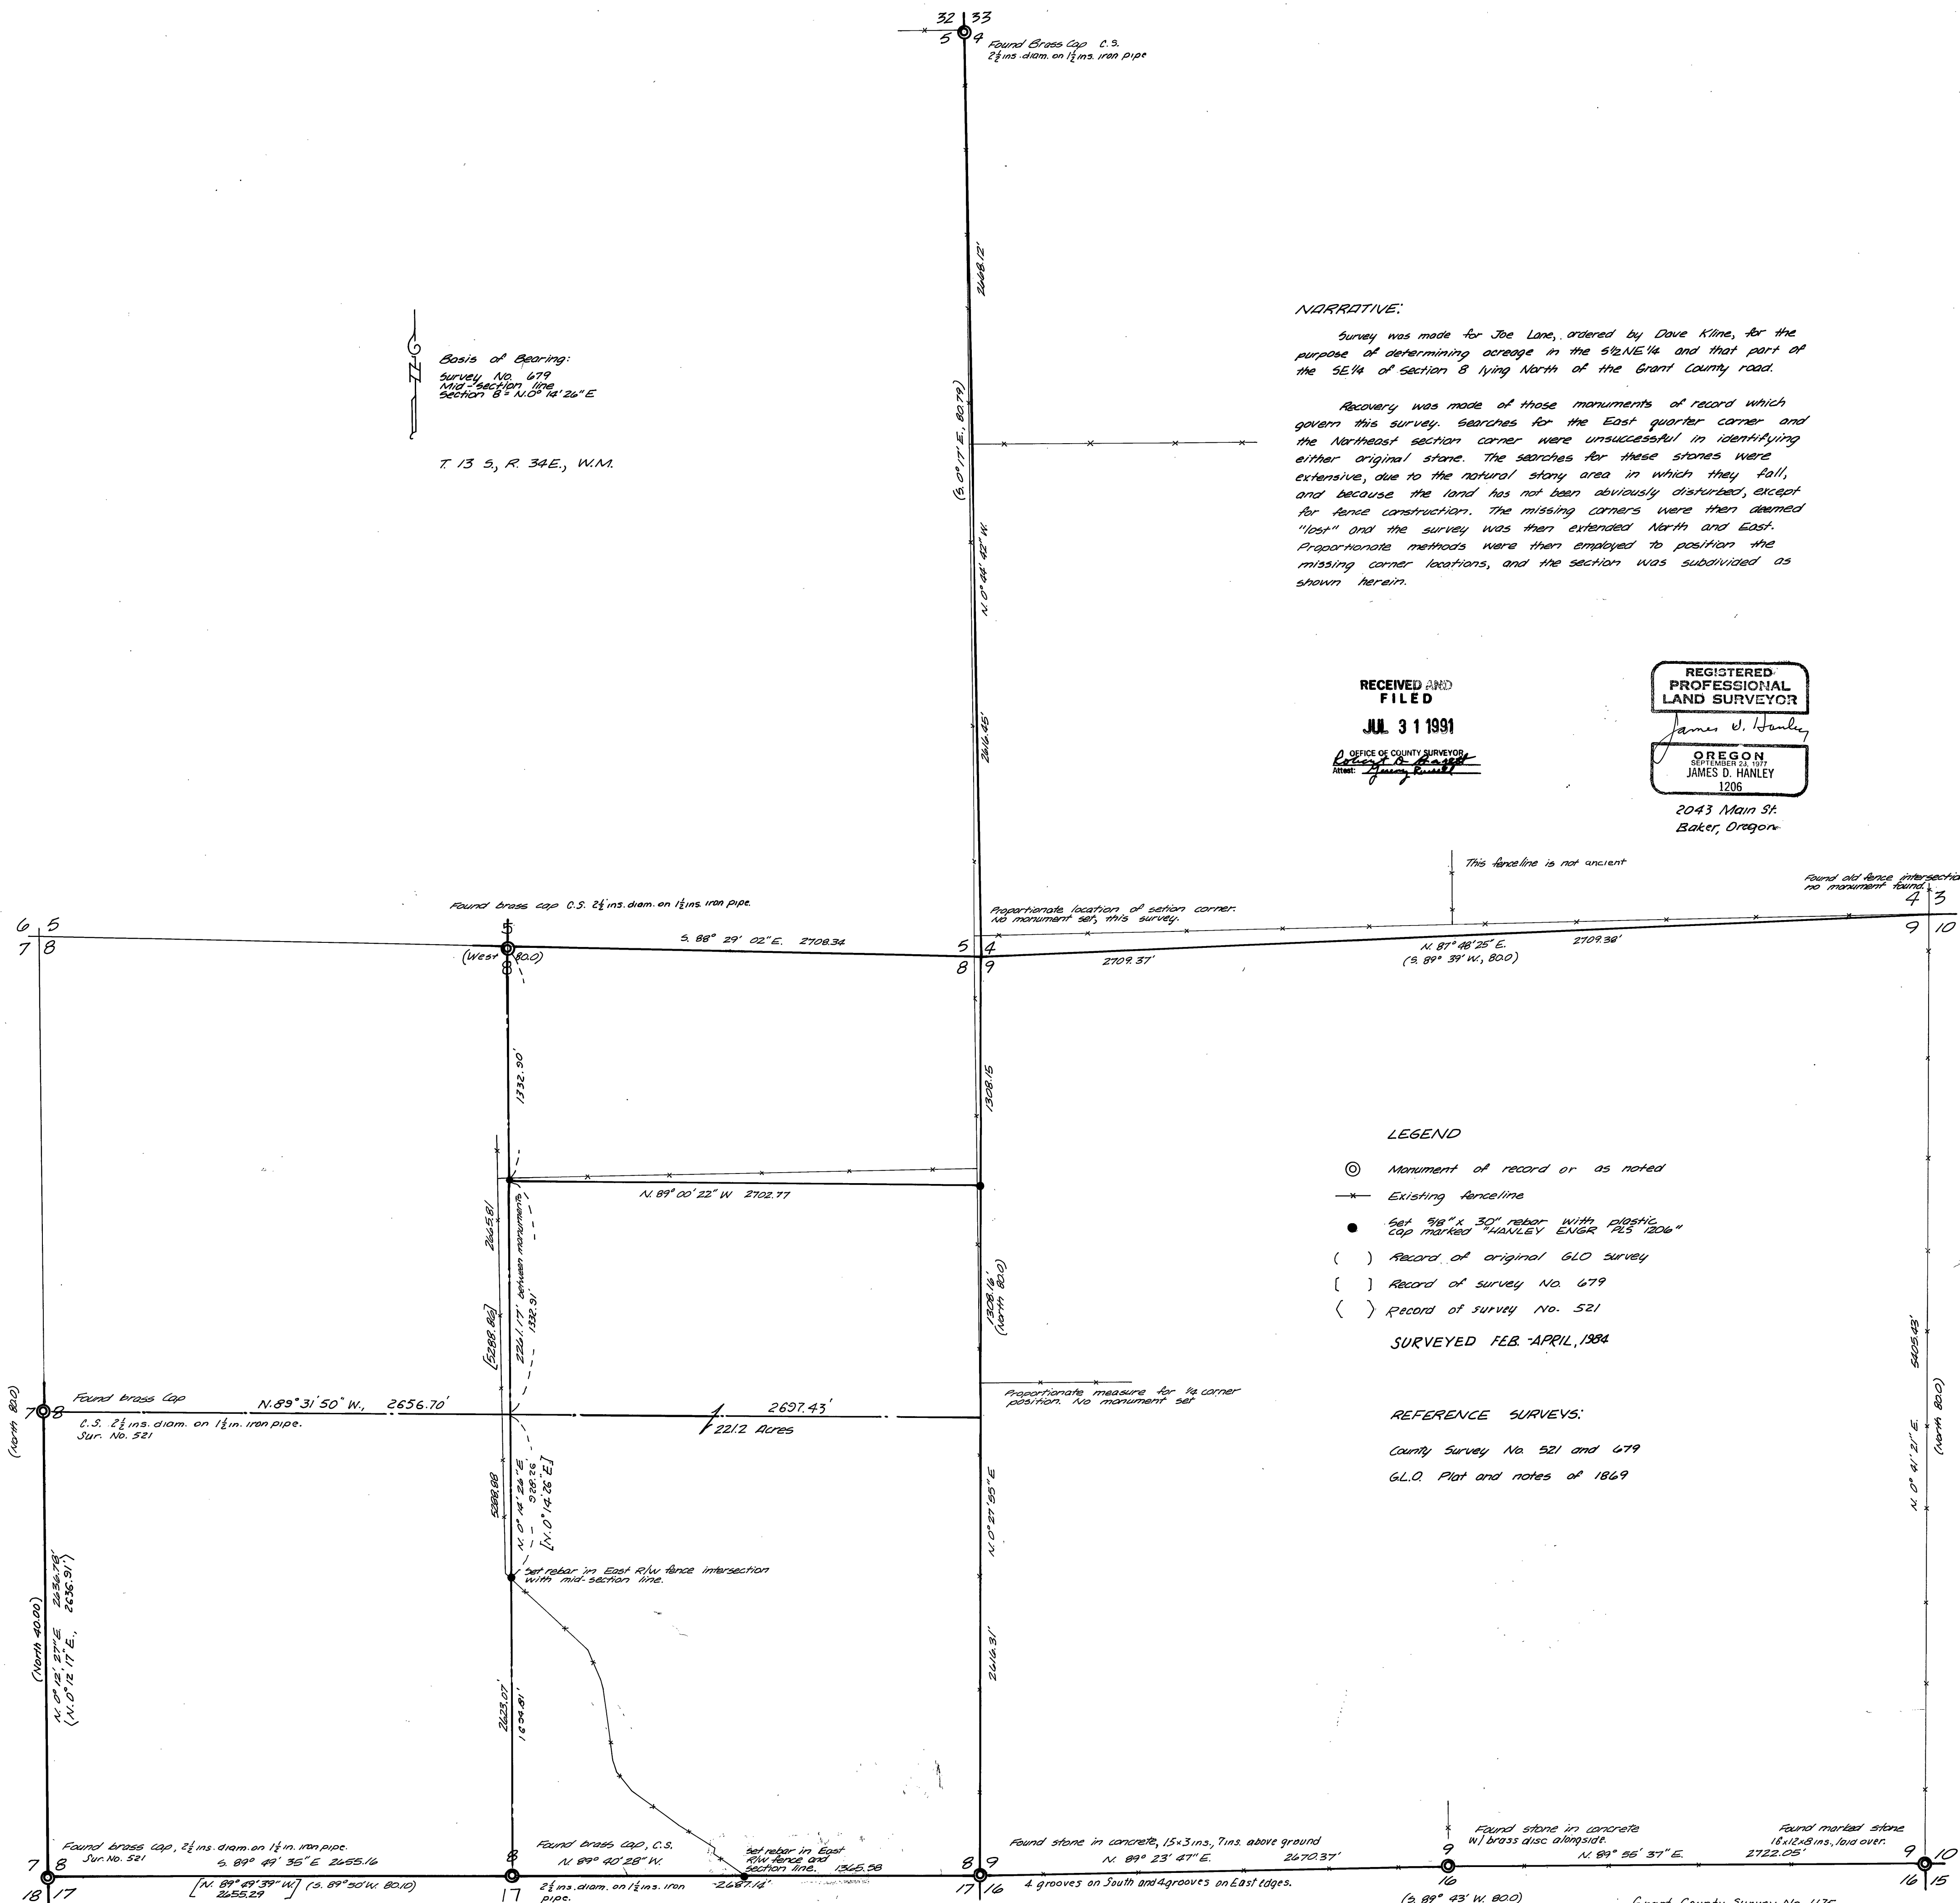

LEGEND

- ⊙ Monument of record or as noted
- Existing fence line
- Set 5/8" x 30" rebar with plastic cap marked "HANLEY ENGR 1206"
- () Record of original GLO survey
- [] Record of survey No. 679
- { } Record of survey No. 521

SURVEYED FEB.-APRIL, 1984

REFERENCE SURVEYS:

County Survey No. 521 and 679
G.L.O. Plat and notes of 1869

Grant County Survey No. 1175