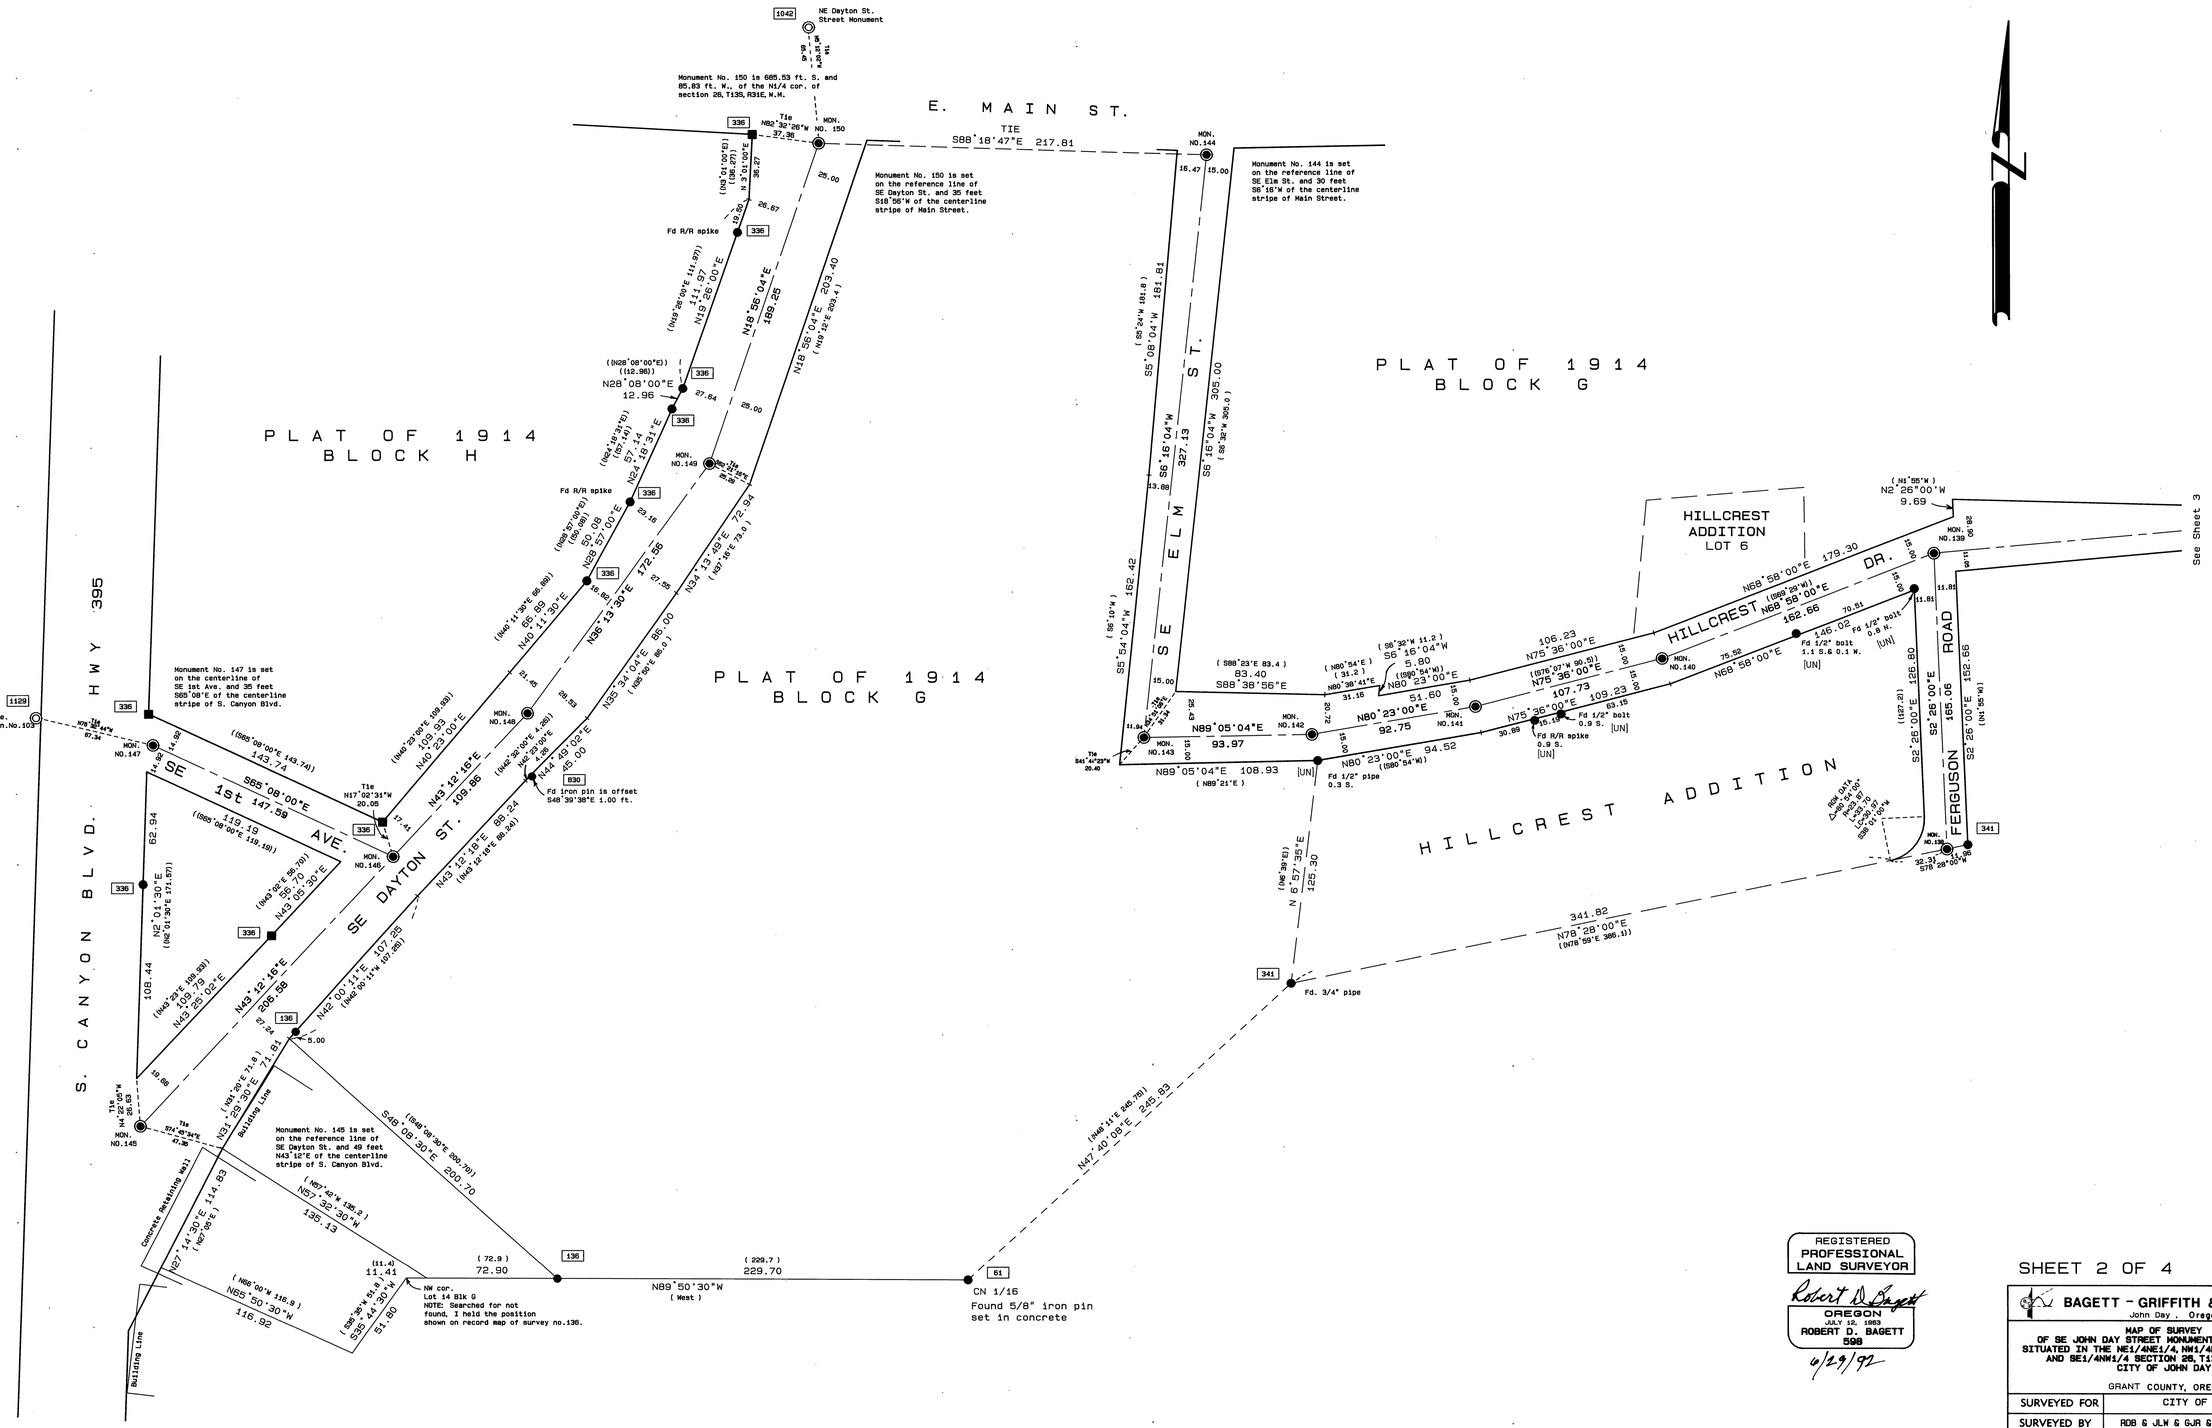


SHEET 2 OF 4

**BAGETT - GRIFFITH & ASSOCIATES**
John Day, Oregon

MAP OF SURVEY
OF SE JOHN DAY STREET MONUMENTATION PROJECT
SITUATED IN THE NE1/4NE1/4, NW1/4NE1/4, NE1/4NW1/4 AND SE1/4NW1/4 SECTION 26, T13S, R31E, W.M.
CITY OF JOHN DAY

GRANT COUNTY, OREGON

| | | | |
|---|---|---|---|
| SURVEYED FOR | CITY OF JOHN DAY | | |
| SURVEYED BY | RDB & JLW & GJR & SDF & NF | | MARCH 1991 To JUNE 1992 |
| Scale: 1"=40' | Drawn by: J.L.W. | | |

RECORD MAP OF SURVEY NO.1211

IDAHO BLUEPRINT & SUP. CO. INC. - BOISE, IDAHO 124131