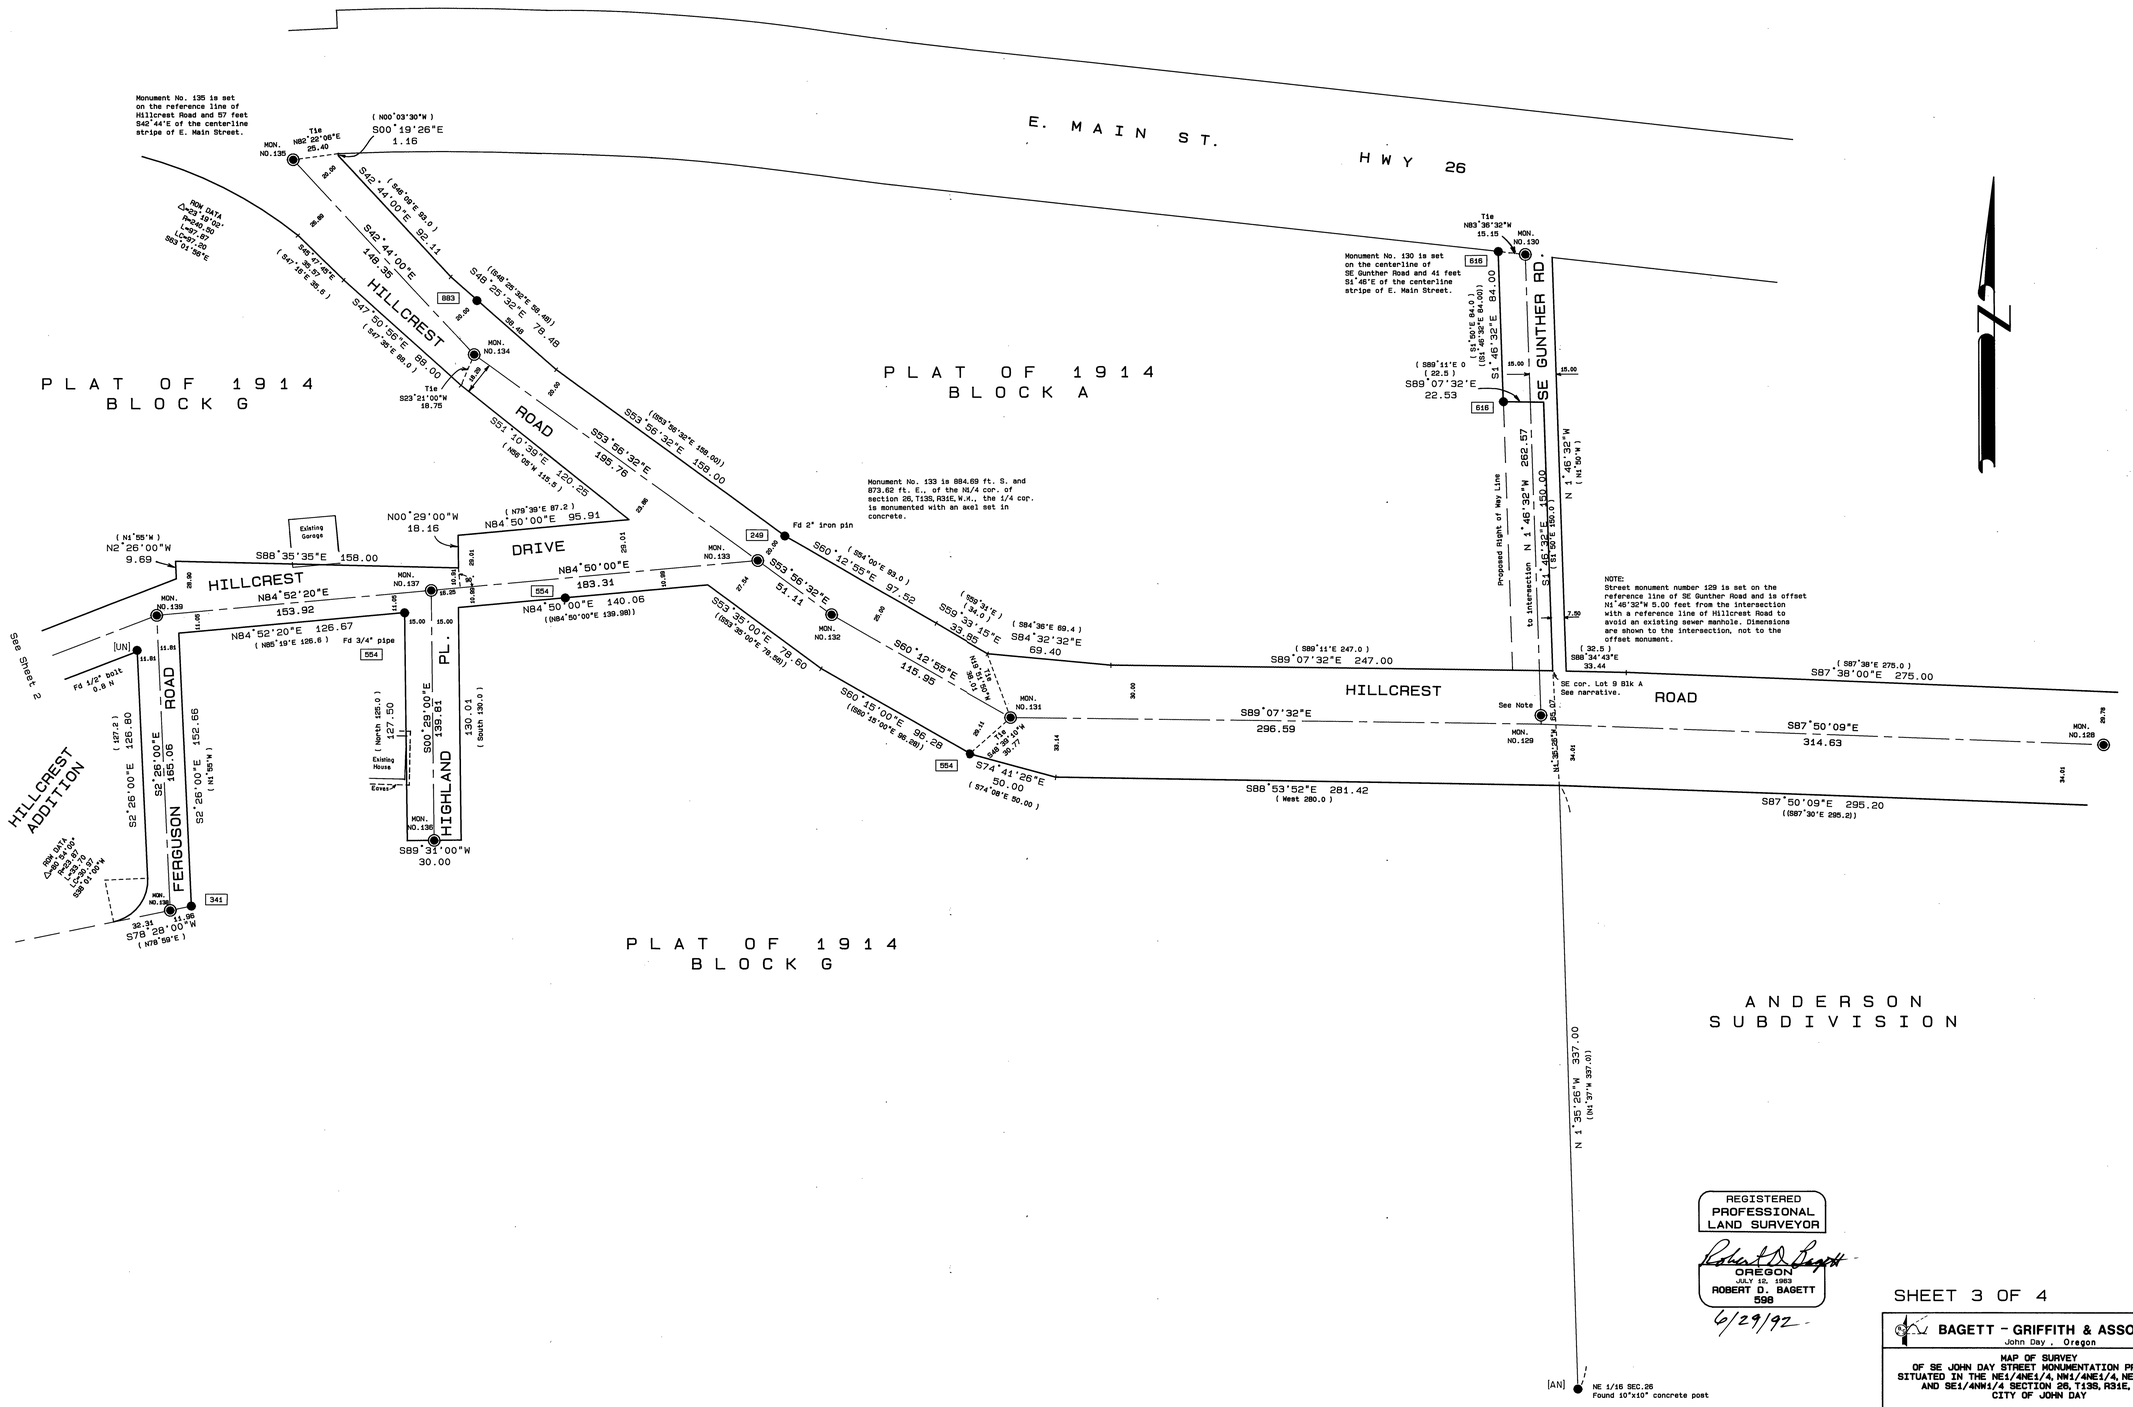

REGISTERED
PROFESSIONAL
LAND SURVEYOR
OREGON
ROBERT D. BAGETT
598
6/29/92

SHEET 3 OF 4

BAGETT - GRIFFITH & ASSOCIATES
John Day , Oregon

MAP OF SURVEY
OF SE JOHN DAY STREET MONUMENTATION PROJECT
SITUATED IN THE NE1/4NE1/4, NW1/4NE1/4, NE1/4NW1/4
AND SE1/4NW1/4 SECTION 26, T13S, R31E, W.M.
CITY OF JOHN DAY

GRANT COUNTY, OREGON

SURVEYED FOR	CITY OF JOHN DAY	
SURVEYED BY	RDB & JLW & GJR & SDF & NF	MARCH 1991 TO JUNE 1992
Scale: 1"=40'	Drawn by: J.L.M.	

RECORD MAP OF SURVEY NO.1211

IDAHO BLUEPRINT & SUP. CO. INC. - BOISE, IDAHO 124131