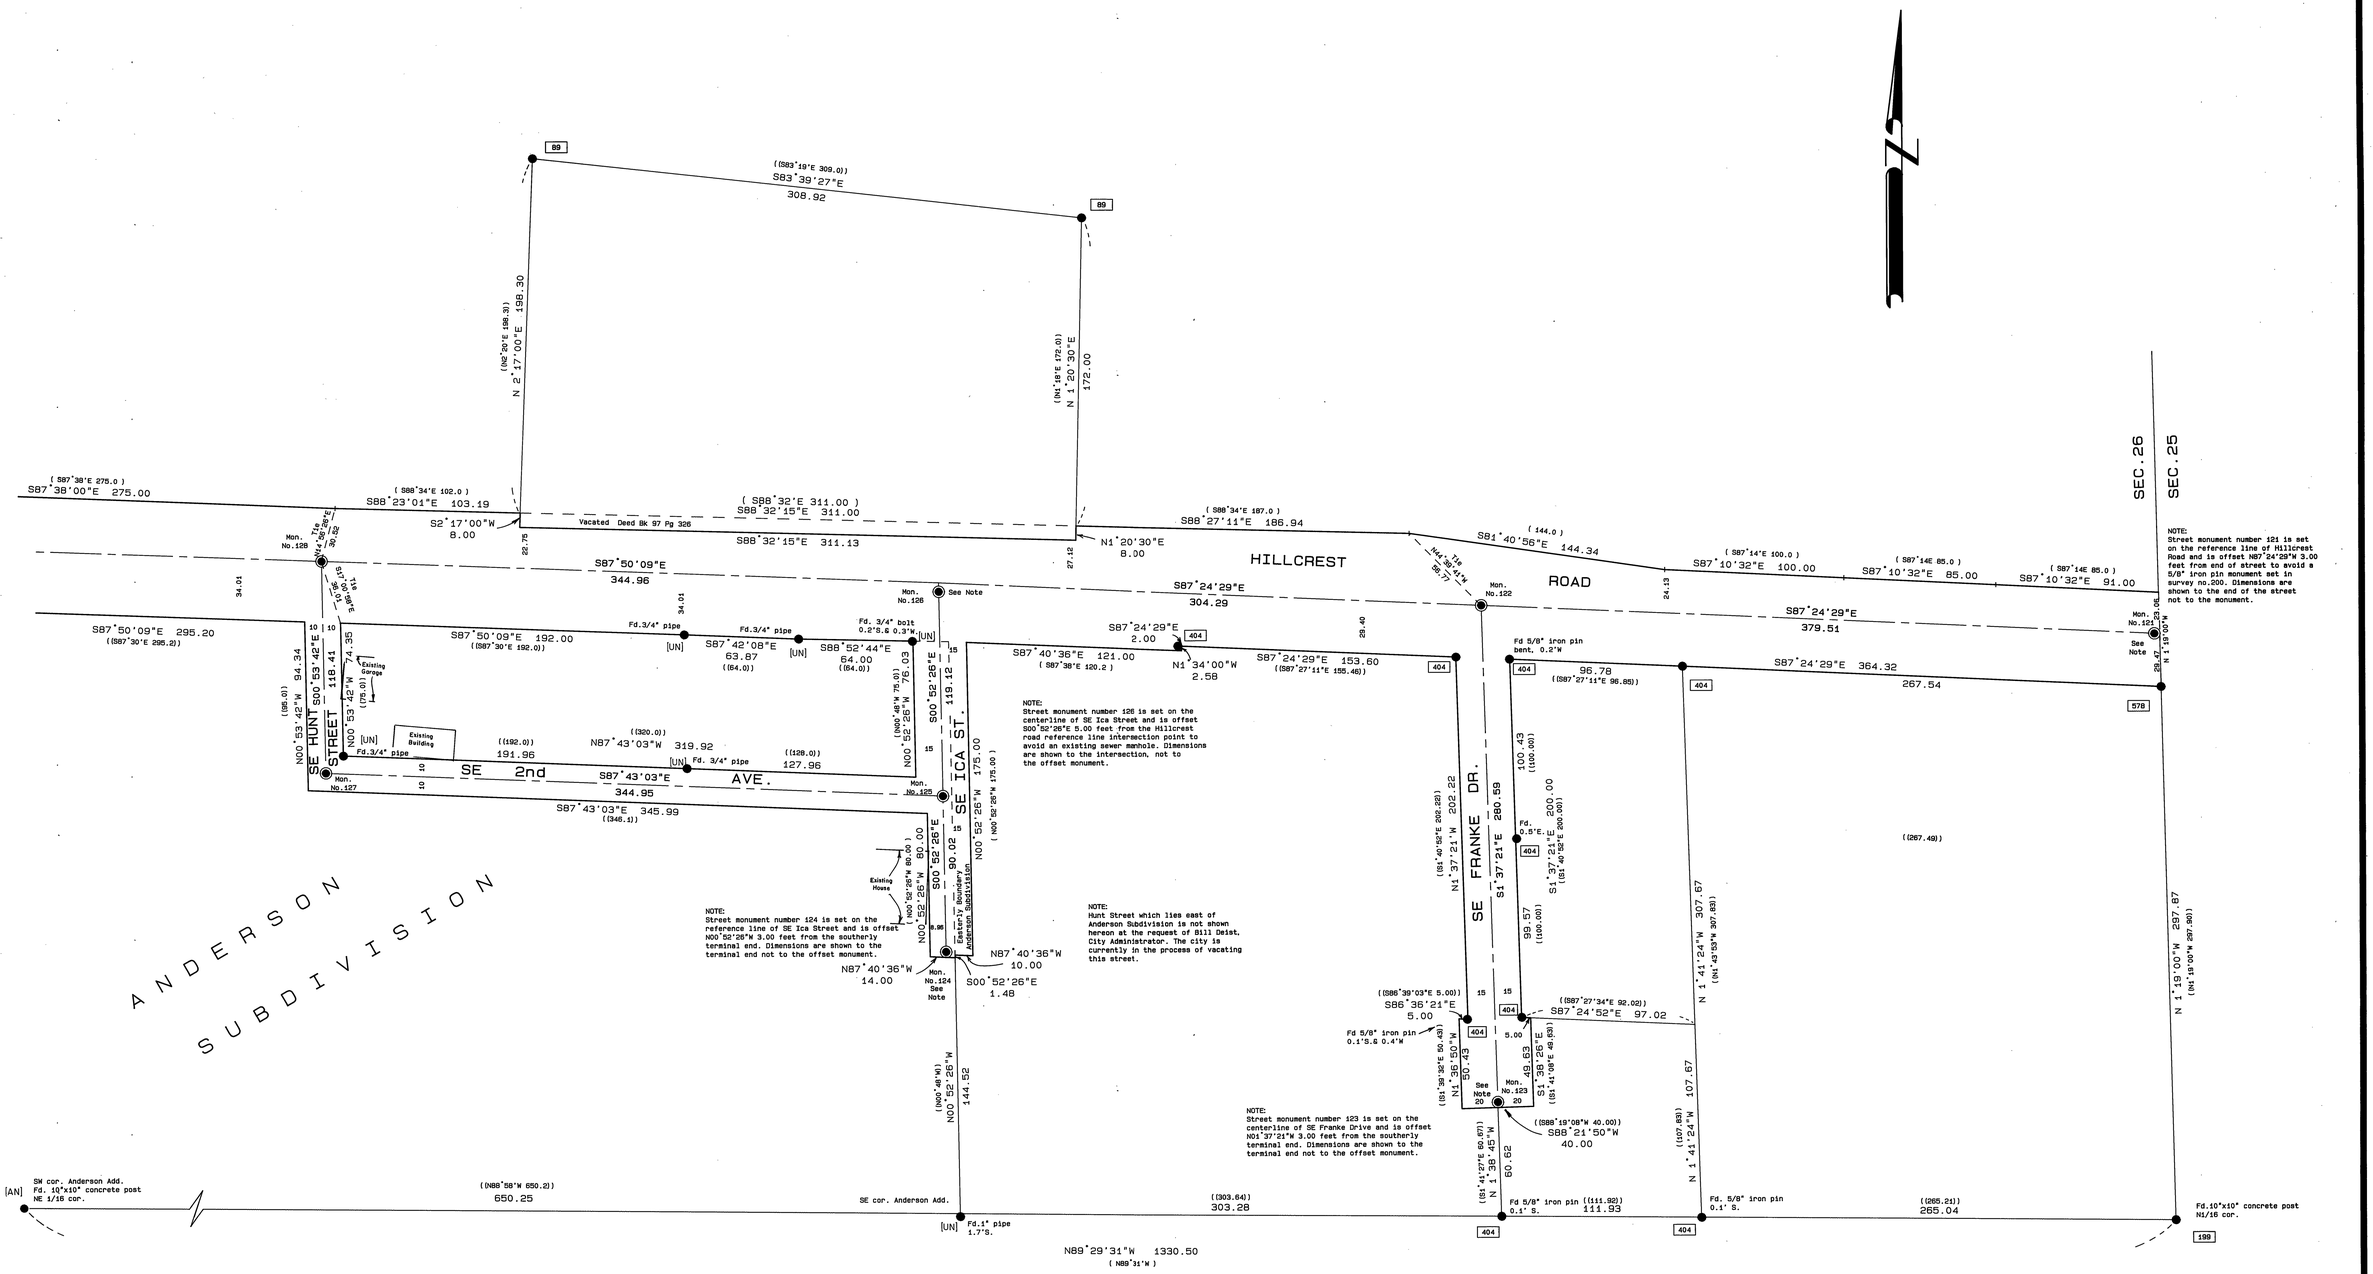

NOTE:
Street monument number 126 is set on the centerline of SE Ica Street and is offset S00°52'26"E 5.00 feet from the Hillcrest road reference line intersection point to avoid an existing sewer manhole. Dimensions are shown to the intersection, not to the offset monument.

NOTE:
Street monument number 124 is set on the reference line of SE Ica Street and is offset N00°52'26"W 3.00 feet from the southerly terminal end. Dimensions are shown to the terminal end not to the offset monument.

NOTE:
Hunt Street which lies east of Anderson Subdivision is not shown hereon at the request of Bill Deist, City Administrator. The city is currently in the process of vacating this street.

NOTE:
Street monument number 123 is set on the centerline of SE Franke Drive and is offset N01°37'21"W 3.00 feet from the southerly terminal end. Dimensions are shown to the terminal end not to the offset monument.

NOTE:
Street monument number 121 is set on the reference line of Hillcrest Road and is offset N87°24'29"W 3.00 feet from end of street to avoid a 5/8" iron pin monument set in survey no.200. Dimensions are shown to the end of the street not to the monument.

REGISTERED
PROFESSIONAL
LAND SURVEYOR

Robert D. Bagett

OREGON
JULY 13, 1983
ROBERT D. BAGETT
598

6/29/92

SHEET 4 OF 4

BAGETT - GRIFFITH & ASSOCIATES
John Day , Oregon

MAP OF SURVEY
OF SE JOHN DAY STREET MONUMENTATION PROJECT
SITUATED IN THE NE1/4NE1/4, NW1/4NE1/4, NE1/4NW1/4
AND SE1/4NW1/4 SECTION 26, T13S, R31E, W.M.
CITY OF JOHN DAY
GRANT COUNTY, OREGON

SURVEYED FOR	CITY OF JOHN DAY	
SURVEYED BY	RDB & JLW & GJR & SDF & NF	MARCH 1991 TO
Scale: 1"=40'	Drawn by: J.L.W.	JUNE 1992

RECORD MAP OF SURVEY NO.1211

IDAHO BLUEPRINT & SUP. CO. INC. - BOISE, IDAHO 134131