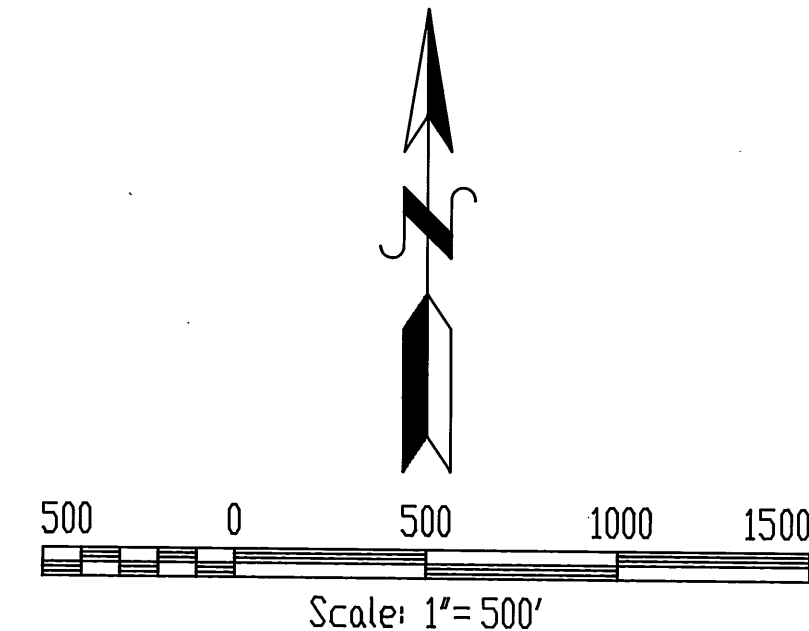


LEGEND


- (O) Monumented from original evidence. Set 2-1/2" x 30" aluminum pipe with 3-1/4" aluminum cap, stamped as shown in the "Monumentation" Section
 (O) Set 2-1/2" x 30" aluminum pipe with 3-1/4" aluminum cap, stamped as shown in the "Monumentation" Section
 (●) Found monument of record, as described in the "History" and notes at each corner.
 *() Record bearing and distance as reported by Bamford Robb, in 1880 under G.L.O. Contract No. 357
 (()) Record bearing and distance as reported by Henry W. Cooke in 1883 under G.L.O. Contract No. 470
 () Record bearing and distance as reported by Henry W. Cooke in 1883 under G.L.O. Contract No. 488
 [] Record bearing and distance as reported by Duanne Griffith, PLS 644, in 1981. See Grant County Map of Survey No. 710.
 { } Record bearing and distance as reported by George W. Colvin, PLS 1020, in 1986. See Grant County Map of Survey No. 981
 ——— Exterior Section Lines
 ——— Center Section Lines
 - - - Subdivisional Lines
 N.F.S.L. National Forest System Lands
 PVT. Private Land
 PVT. Marked Forest boundary with steel fence posts and Forest boundary signs at Maximum Intervals of 250 feet.
 N.F.S.L.
 Existing road

HORNET T.17S., R.31E. SECTION 1

MAGNETIC DECLINATION 20' EAST


 BASIS OF BEARING SOLAR OBSERVATION
 WITH THE TRUE MERIDIAN THRU
 THE CENTER OF THE SECTION

Ferguson Surveying

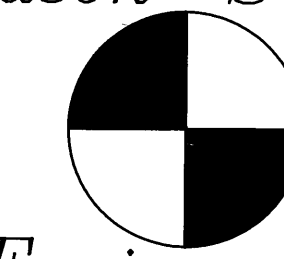

Engineering

 MT. VERNON, OREGON
 PHONE (503)932-4520
 FAX (503)932-4430

 REGISTERED
 PROFESSIONAL
 LAND SURVEYOR

 OREGON
 JULY 12, 1988
 DOUGLAS M. FERGUSON
 848

MONUMENTATION

See standard U.S.F.S. "INDEX No." in the circle on the map. Monuments are stamped as shown below. On each Bearing tree, nailed a brass washer stamped "PLS 848" blaze above the BT scribe and nailed warning signs on the back. Set steel posts with warning and boundary signs, on line within 5 ft. of property corners, or a single post with a warning sign within 5 ft. of controlling corners.

See "CERTIFIED RECORD OF LAND CORNER MONUMENTATION" forms on file in the office of the Grant County Surveyor for a complete history, description of evidence found, monument set, and accessories established at all corners set.

