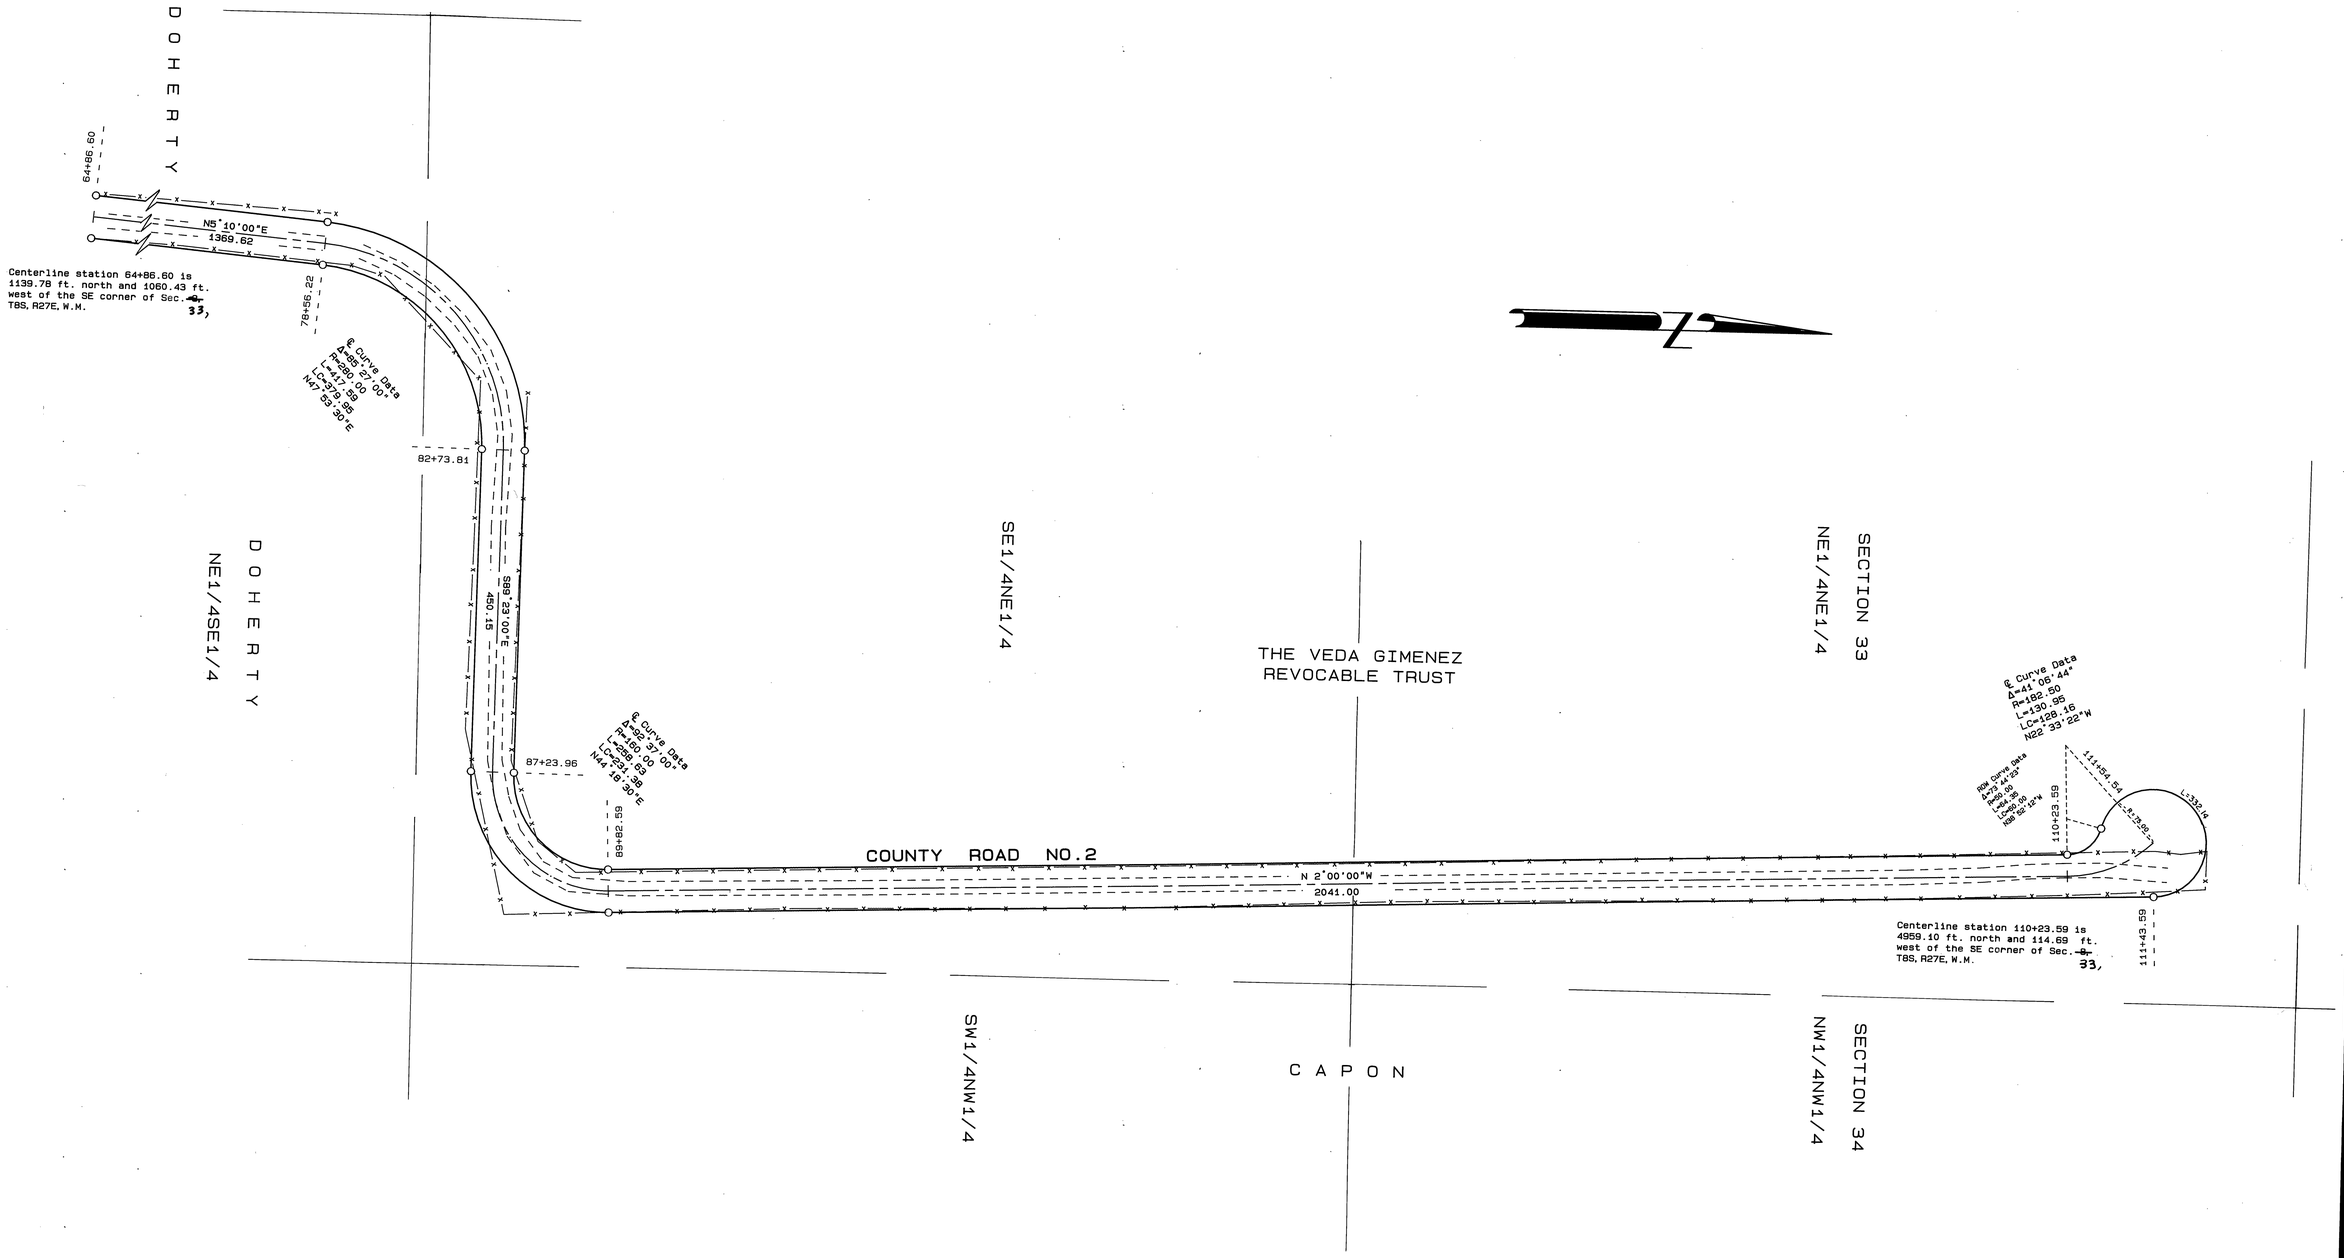

CORRECTIONS MADE APRIL 12, 2005
SEE INSTRUMENT NO. 20050034
Robert D. Bagett, COUNTY SURVEYOR

REGISTERED
PROFESSIONAL
LAND SURVEYOR
Robert D. Bagett
OREGON
JULY 12, 1983
ROBERT D. BAGETT
598

SHEET 4 OF 4

BAGETT - GRIFFITH & ASSOCIATES
John Day, Oregon

MAP OF SURVEY
A PORTION OF COUNTY ROAD NO.2 SITUATED IN THE E1/2NE1/4, SE1/4 SEC.33; AND W1/2NW1/4 SEC.34 T8S, R27E; AND GOV'T LOT2, SW1/4NE1/4, W1/2SE1/4 E1/2SW1/4, SE1/4NW1/4, SEC.5; AND NW1/4NE1/4, NW1/4 SEC.8, T9S, R27E, W.M.
GRANT COUNTY, OREGON

SURVEYED FOR	GRANT COUNTY ROAD DEPARTMENT	
SURVEYED BY	RDB & GJR & SDF & NF	3/27/92 TO 7/14/92
Scale: 1"=100'	Drawn by: J.L.W.	

RECORD MAP OF SURVEY NO.1219

IDAHO BLUEPRINT & SUP. CO. INC. - BOISE, IDAHO 124131