


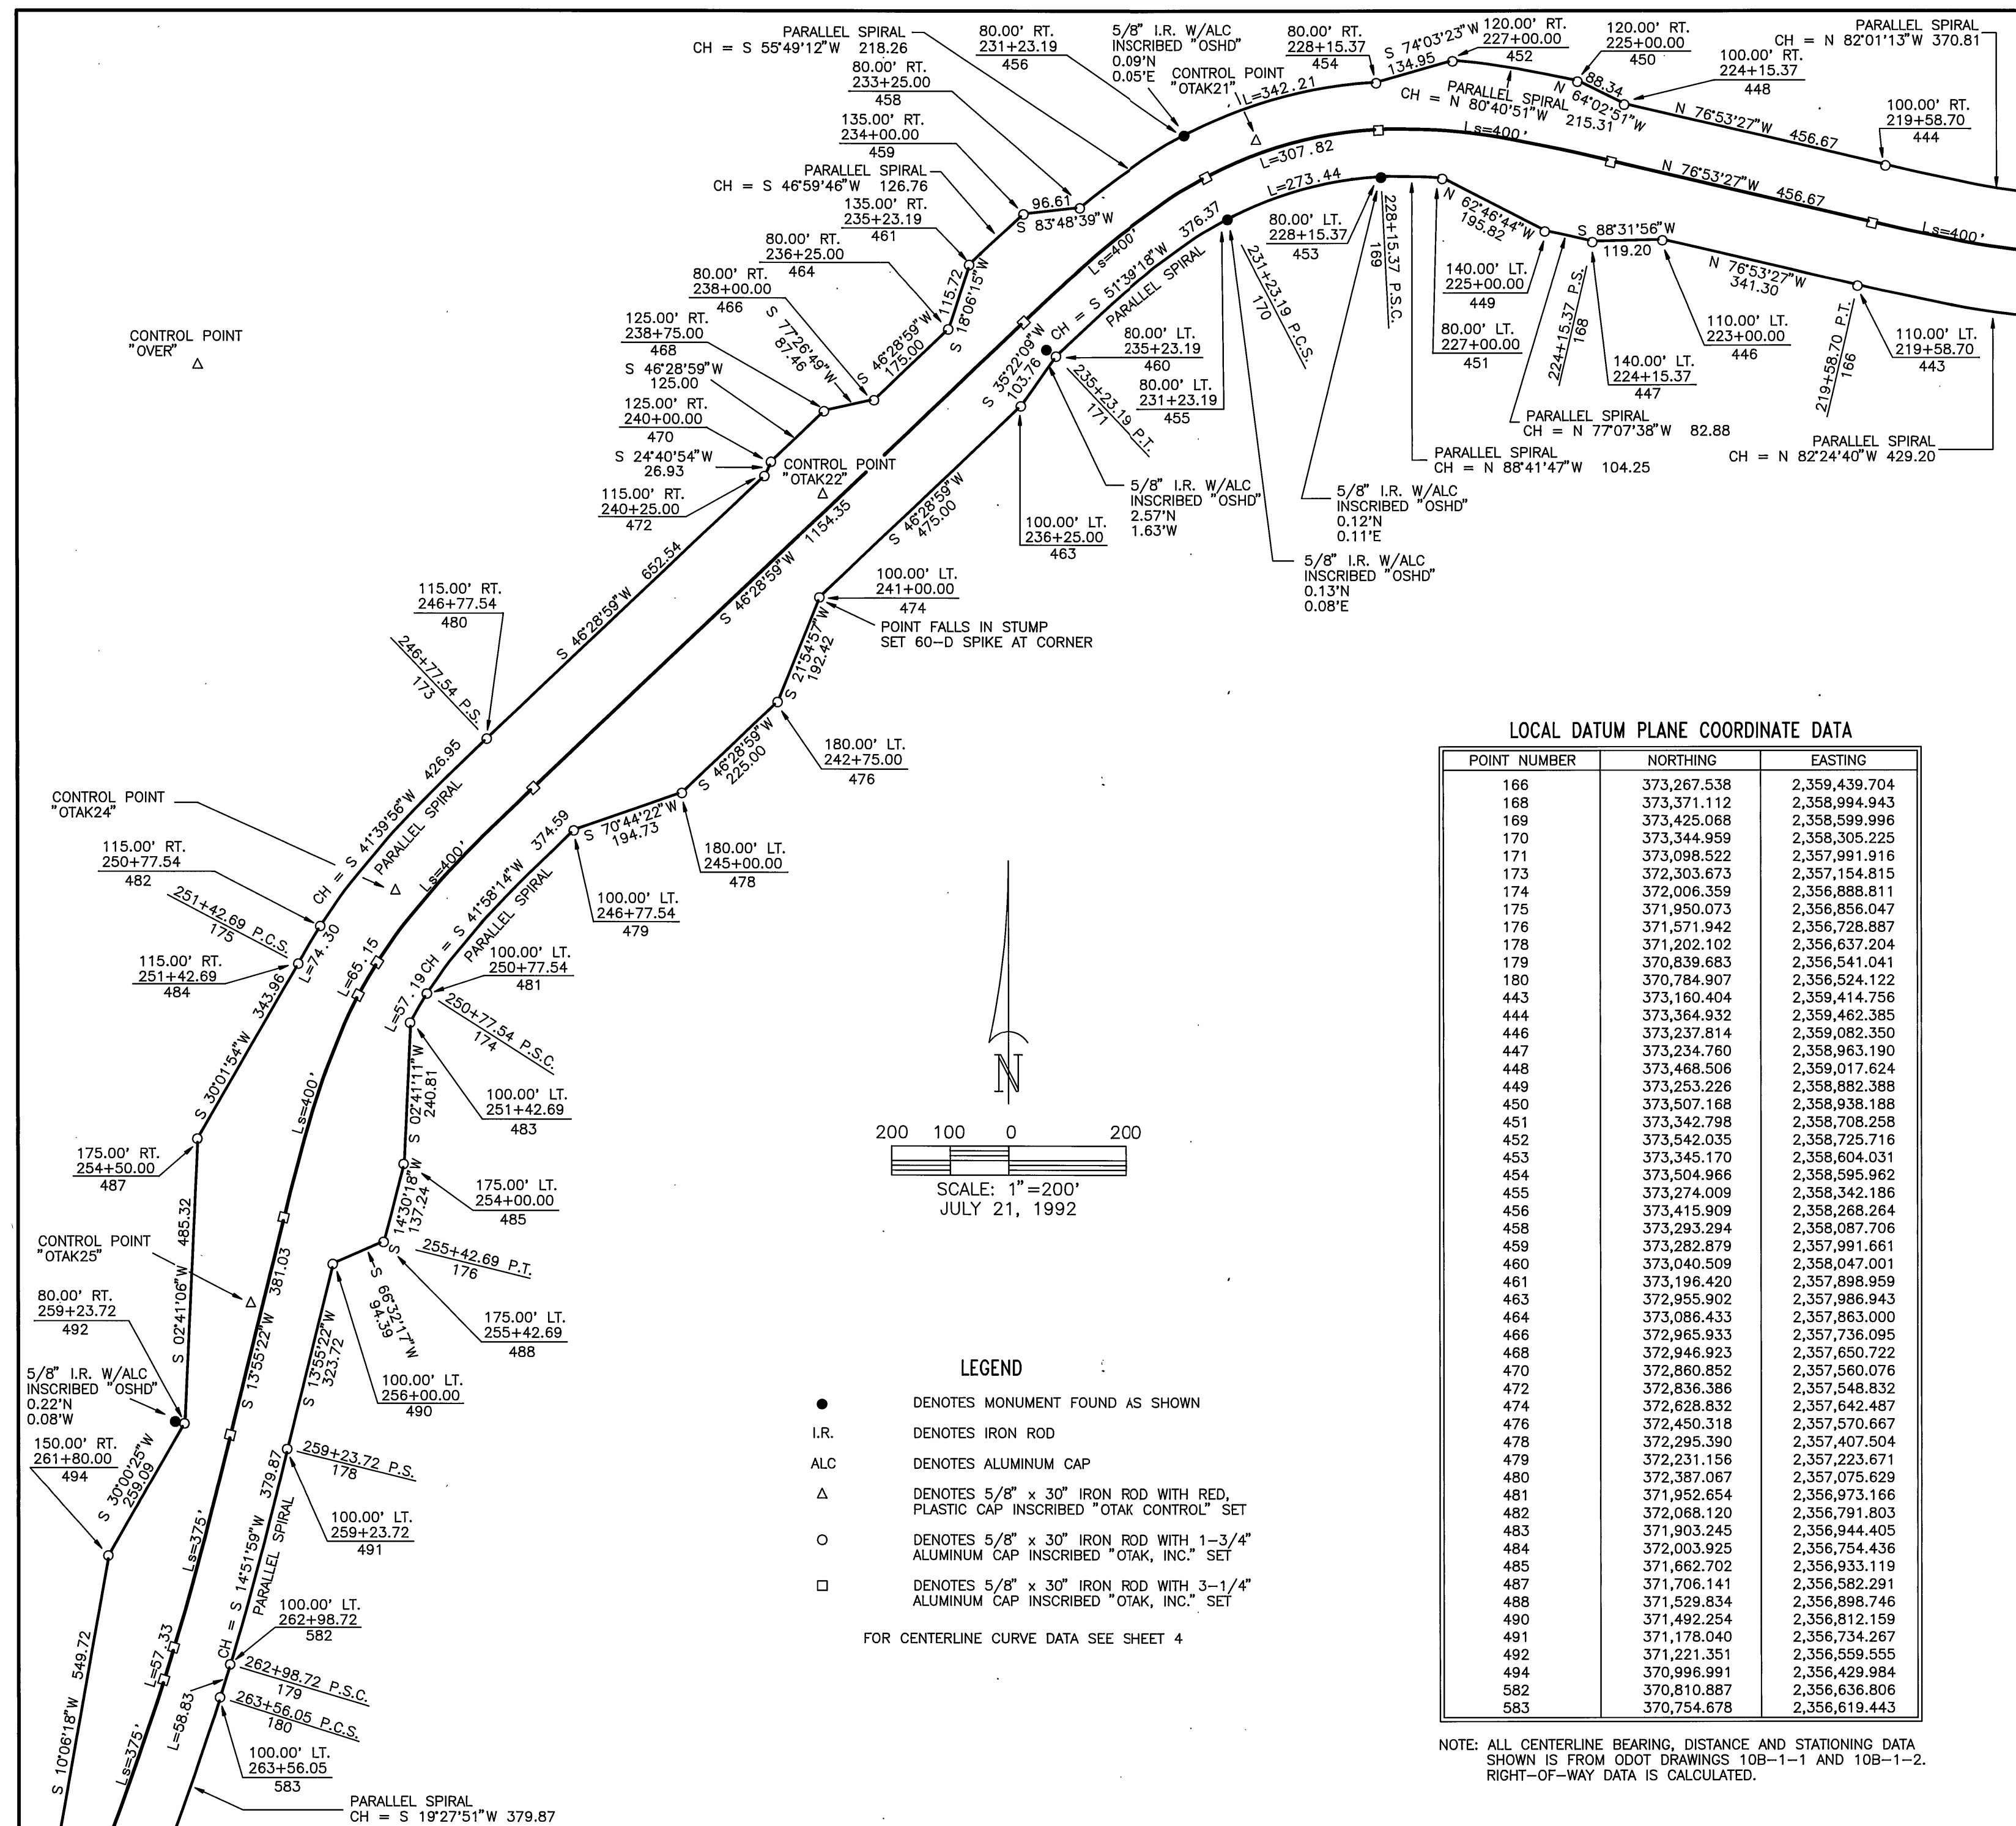

JAC2/1992

CalculatedDTD2/1992

DrawnDLL2/1992

CheckedDate

REVISIONS

REGISTERED
PROFESSIONAL
LAND SURVEYOR

JOHN A. CARLSON
JULY 15, 1983
2044

MONUMENTATION SURVEY

PENDING-JOHN DAY HIGHWAY
LONG CREEK - FOX SECTION
SECTIONS 9, 10, 15, 16, 20, 21, 22, 29, 31, 32, T.10S., R.30E., W.M.
GRANT COUNTY, OREGON

FOR: OREGON STATE DEPARTMENT OF TRANSPORTATION - HIGHWAY DIVISION

otak
Incorporated

17355 S.W. BOONES FERRY ROAD
LAKE OSWEGO, OREGON 97035
(503) 635-3618 FAX (503) 635-5395

10 OF 13

Sheet No.

3659

Project No.

LOCAL DATUM PLANE COORDINATE DATA		
POINT NUMBER	NORTHING	EASTING
166	373,267.538	2,359,439.704
168	373,371.112	2,358,994.943
169	373,425.068	2,358,599.996
170	373,344.959	2,358,305.225
171	373,098.522	2,357,991.916
173	372,303.673	2,357,154.815
174	372,006.359	2,356,888.811
175	371,950.073	2,356,856.047
176	371,571.942	2,356,728.887
178	371,202.102	2,356,637.204
179	370,839.683	2,356,541.041
180	370,784.907	2,356,524.122
443	373,160.404	2,359,414.756
444	373,364.932	2,359,462.385
446	373,237.814	2,359,082.350
447	373,234.760	2,358,963.190
448	373,468.506	2,359,017.624
449	373,253.226	2,358,882.388
450	373,507.168	2,358,938.188
451	373,342.798	2,358,708.258
452	373,542.035	2,358,725.716
453	373,345.170	2,358,604.031
454	373,504.966	2,358,595.962
455	373,274.009	2,358,342.186
456	373,415.909	2,358,268.264
458	373,293.294	2,358,087.706
459	373,282.879	2,357,991.661
460	373,040.509	2,358,047.001
461	373,196.420	2,357,898.959
463	372,955.902	2,357,986.943
464	373,086.433	2,357,863.000
466	372,965.933	2,357,736.095
468	372,946.923	2,357,650.722
470	372,860.852	2,357,560.076
472	372,836.386	2,357,548.832
474	372,628.832	2,357,642.487
476	372,450.318	2,357,570.667
478	372,295.390	2,357,407.504
479	372,231.156	2,357,223.671
480	372,387.067	2,357,075.629
481	371,952.654	2,356,973.166
482	372,068.120	2,356,791.803
483	371,903.245	2,356,944.405
484	372,003.925	2,356,754.436
485	371,662.702	2,356,933.119
487	371,706.141	2,356,582.291
488	371,529.834	2,356,898.746
490	371,492.254	2,356,812.159
491	371,178.040	2,356,734.267
492	371,221.351	2,356,559.555
494	370,996.991	2,356,429.984
582	370,810.887	2,356,636.806
583	370,754.678	2,356,619.443

NOTE: ALL CENTERLINE BEARING, DISTANCE AND STATIONING DATA SHOWN IS FROM ODOT DRAWINGS 10B-1-1 AND 10B-1-2. RIGHT-OF-WAY DATA IS CALCULATED.