
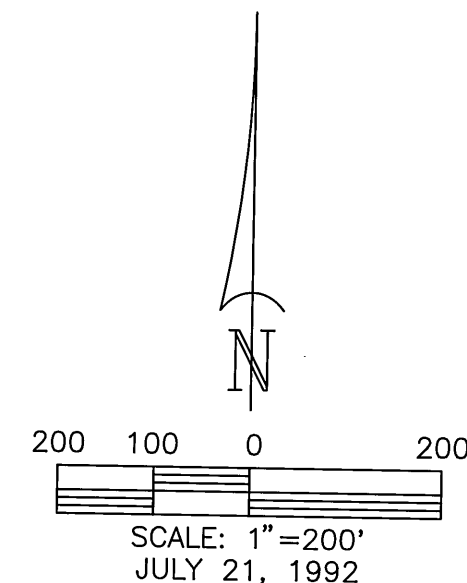


LOCAL DATUM PLANE COORDINATE DATA

POINT NUMBER	NORTHING	EASTING
181	370,431.389	2,356,399.141
183	368,562.157	2,355,703.691
184	368,083.963	2,355,560.599
185	368,015.107	2,355,551.419
186	367,516.127	2,355,564.222
495	370,396.519	2,356,492.864
496	370,455.798	2,356,333.534
498	370,190.334	2,356,490.840
500	370,262.140	2,356,197.466
502	369,910.141	2,356,311.907
504	369,738.598	2,356,056.030
506	369,019.766	2,355,980.642
508	368,912.095	2,355,983.262
509	368,988.808	2,355,777.070
511	368,902.059	2,355,723.455
513	368,724.648	2,355,913.522
514	368,808.335	2,355,688.585
515	368,534.261	2,355,778.670
516	368,590.052	2,355,628.712
517	368,071.230	2,355,639.580
518	368,096.695	2,355,481.619
519	368,006.701	2,355,630.976
520	368,023.513	2,355,471.861
521	367,523.403	2,355,643.890
522	367,508.850	2,355,484.554

NOTE: ALL CENTERLINE BEARING, DISTANCE AND STATIONING DATA SHOWN IS FROM ODOT DRAWINGS 10B-1-1 AND 10B-1-2. RIGHT-OF-WAY DATA IS CALCULATED.

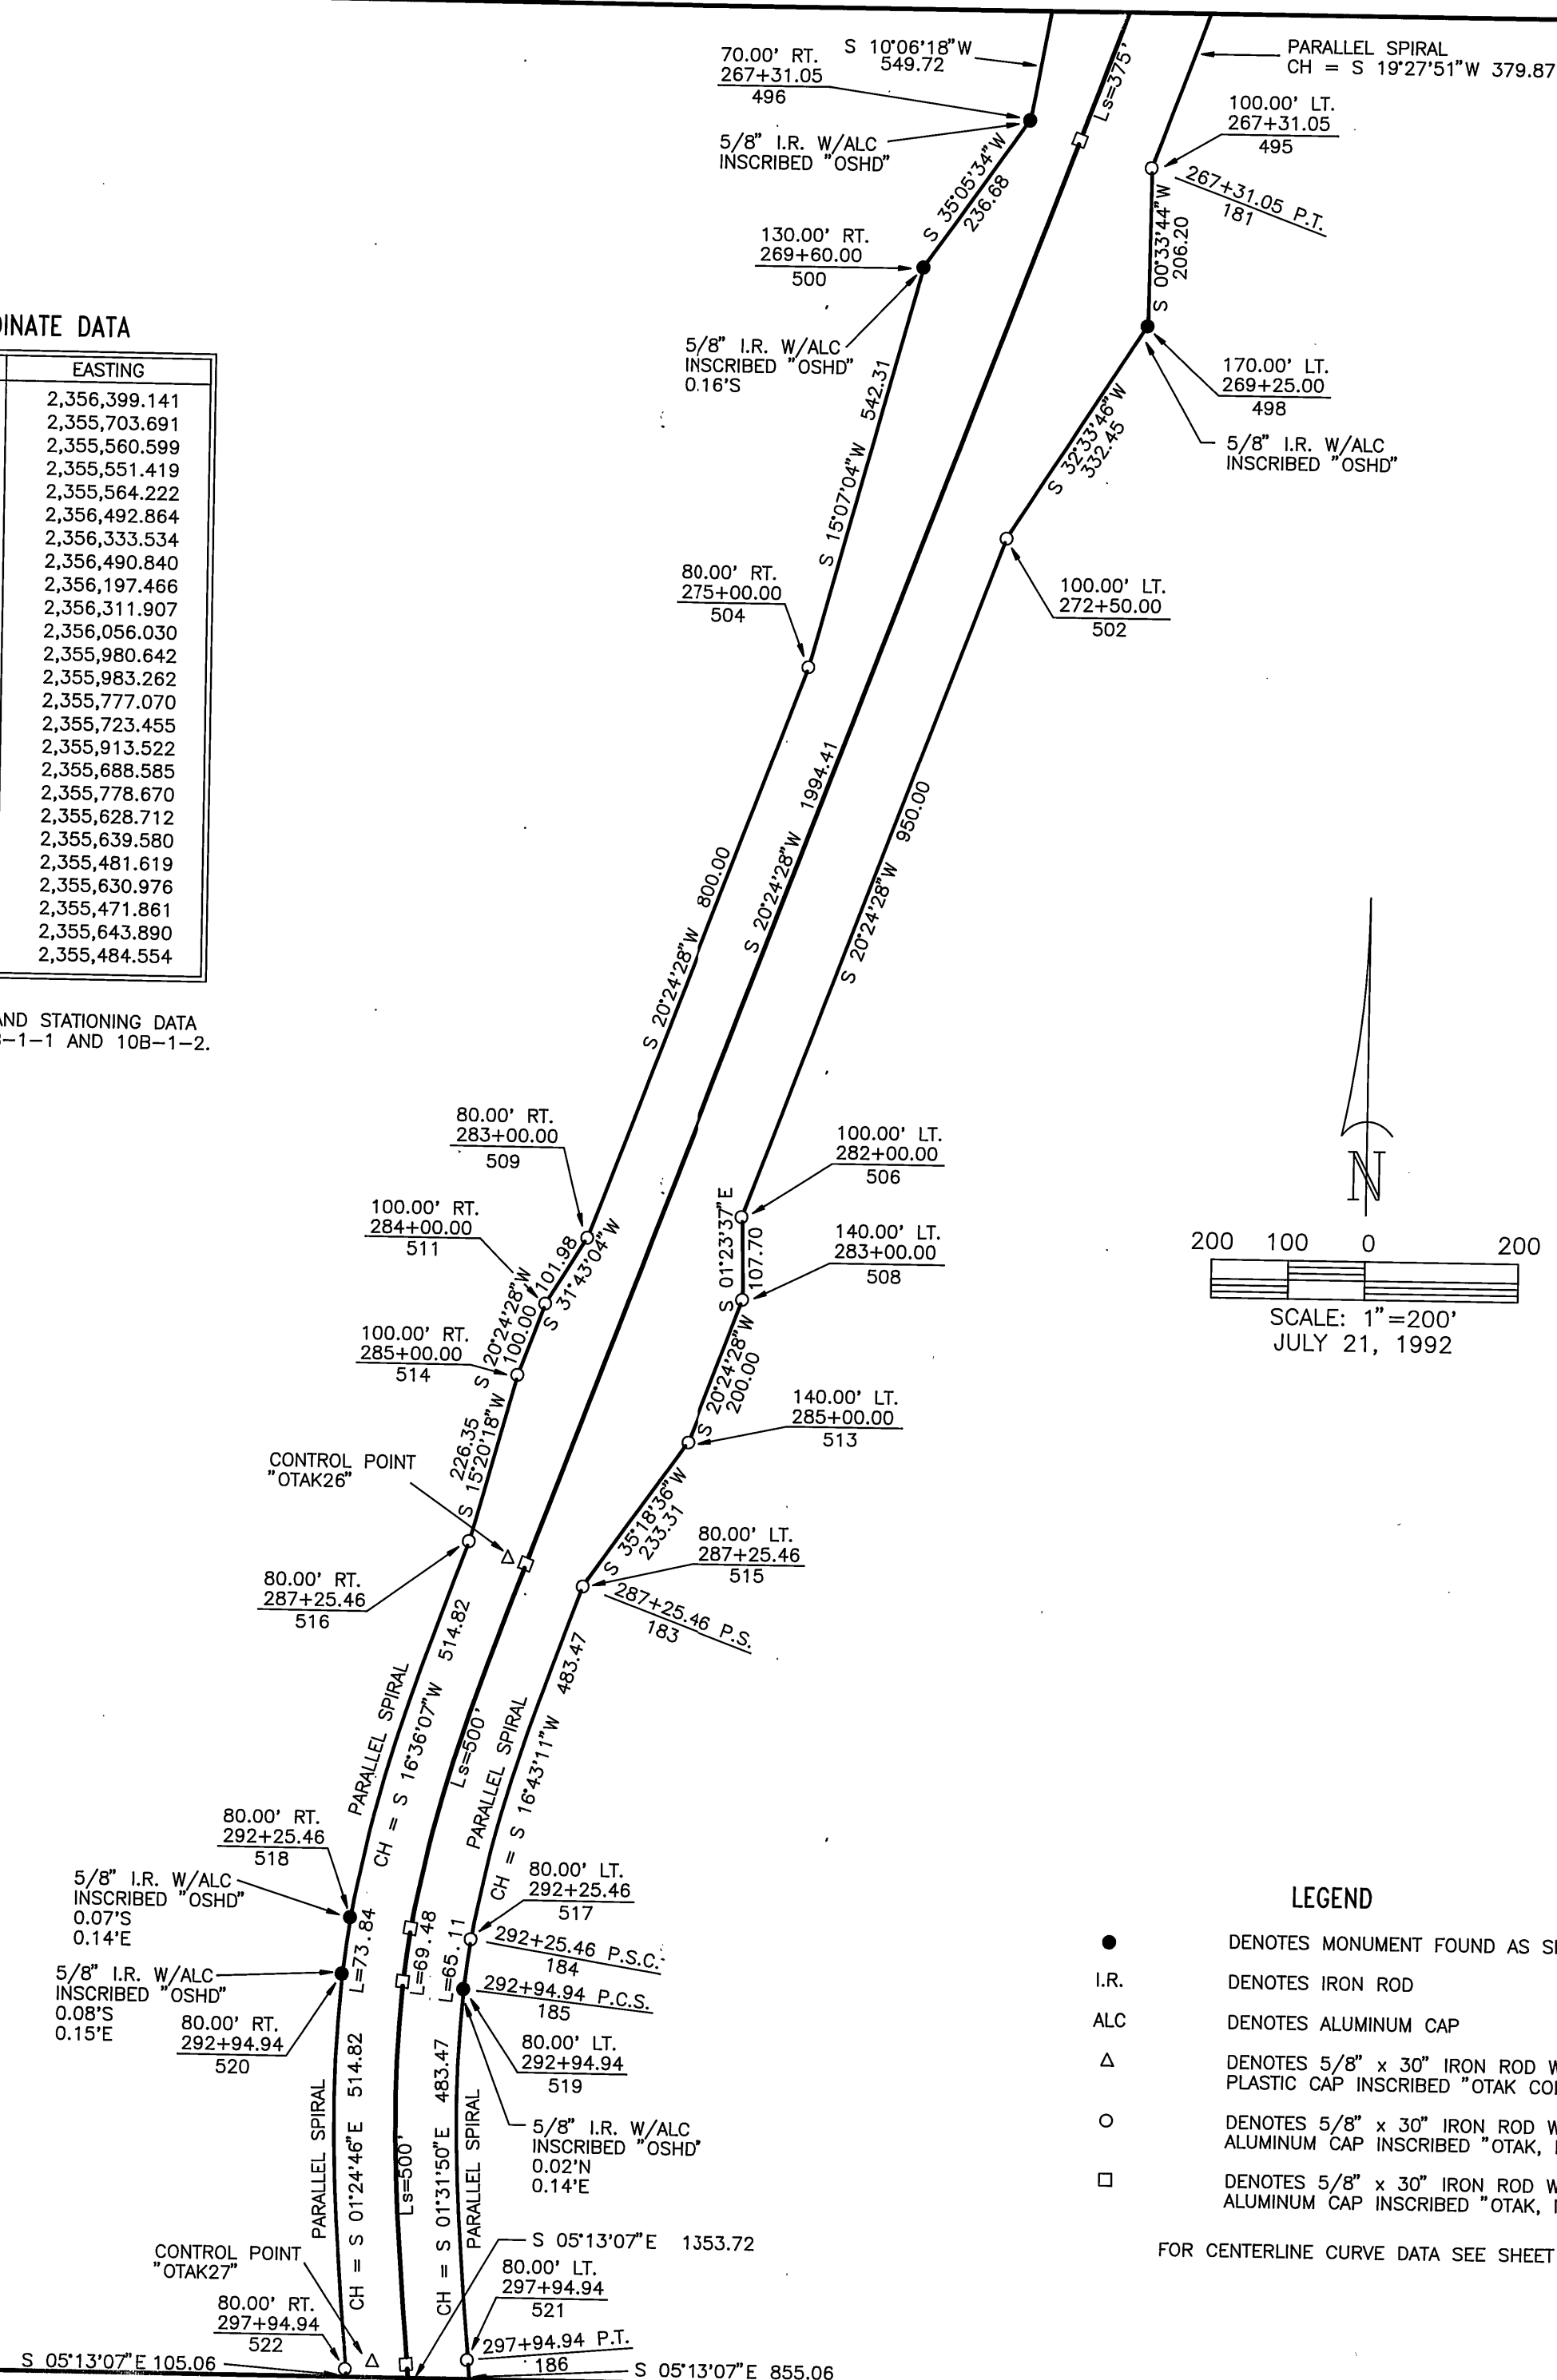

- LEGEND**
- DENOTES MONUMENT FOUND AS SHOWN
 - I.R. DENOTES IRON ROD
 - ALC DENOTES ALUMINUM CAP
 - △ DENOTES 5/8" x 30" IRON ROD WITH RED, PLASTIC CAP INSCRIBED "OTAK CONTROL" SET
 - DENOTES 5/8" x 30" IRON ROD WITH 1-3/4" ALUMINUM CAP INSCRIBED "OTAK, INC." SET
 - DENOTES 5/8" x 30" IRON ROD WITH 3-1/4" ALUMINUM CAP INSCRIBED "OTAK, INC." SET
- FOR CENTERLINE CURVE DATA SEE SHEET 4

JAC	2/1992
Calculated	Date
DTD	2/1992
Drawn	Date
DLL	2/1992
Checked	Date

REVISIONS

**REGISTERED
PROFESSIONAL
LAND SURVEYOR**

John A. Carlson

OREGON
JULY 15, 1983
JOHN A. CARLSON
2044

MONUMENTATION SURVEY

PENDLETON-JOHN DAY HIGHWAY
LONG CREEK - FOX SECTION
SECTIONS 9,10,15,16,20,21,22,29,31,32, T.10S., R.30E., W.M.
GRANT COUNTY, OREGON

FOR: OREGON STATE DEPARTMENT OF TRANSPORTATION - HIGHWAY DIVISION

otak
Incorporated

surveyors
engineers
planners

17355 S.W. BOONES FERRY ROAD
LAKE OSWEGO, OREGON 97035
(503)635-3618 FAX (503)635-5395

11 OF 13

Sheet No.

3659

Project No.