



- LEGEND**
- DENOTES MONUMENT FOUND AS SHOWN
 - I.R. DENOTES IRON ROD
 - ALC DENOTES ALUMINUM CAP
 - △ DENOTES 5/8" x 30" IRON ROD WITH RED, PLASTIC CAP INSCRIBED "OTAK CONTROL" SET
 - DENOTES 5/8" x 30" IRON ROD WITH 1-3/4" ALUMINUM CAP INSCRIBED "OTAK, INC." SET
 - DENOTES 5/8" x 30" IRON ROD WITH 3-1/4" ALUMINUM CAP INSCRIBED "OTAK, INC." SET
- FOR CENTERLINE CURVE DATA SEE SHEET 4

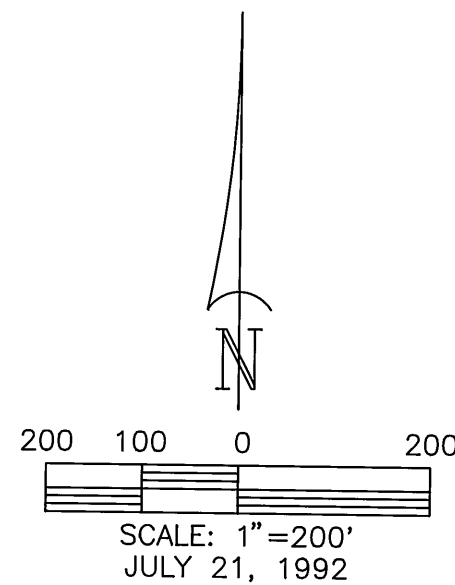

LOCAL DATUM PLANE COORDINATE DATA

POINT NUMBER	NORTHING	EASTING
186	367,516.127	2,355,564.222
188	366,168.015	2,355,687.351
189	365,770.302	2,355,677.346
190	365,448.940	2,355,454.537
191	365,300.088	2,355,085.595
193	364,998.216	2,353,983.061
194	364,849.363	2,353,614.119
521	367,523.403	2,355,643.890
522	367,508.850	2,355,484.554
524	367,404.226	2,355,494.109
526	367,301.912	2,355,473.329
528	366,704.399	2,355,527.903
530	366,671.888	2,355,721.663
532	366,607.542	2,355,566.874
534	366,325.154	2,355,773.415
535	366,177.110	2,355,786.937
536	366,160.738	2,355,607.683
537	365,744.789	2,355,774.036
538	365,790.713	2,355,599.993
539	365,795.816	2,355,580.655
540	365,367.339	2,355,512.340
541	365,530.542	2,355,396.734
542	365,203.638	2,355,112.003
543	365,396.538	2,355,059.187
545	365,179.271	2,355,023.008
547	365,329.919	2,354,815.872
549	365,351.736	2,354,706.218
551	365,285.716	2,354,465.093
553	365,211.083	2,354,381.847
555	364,798.648	2,354,162.993
556	365,094.666	2,353,956.653
557	364,891.893	2,353,901.156
558	364,784.082	2,353,660.362
559	364,930.965	2,353,556.316

NOTE: ALL CENTERLINE BEARING, DISTANCE AND STATIONING DATA SHOWN IS FROM ODOT DRAWINGS 10B-1-1 AND 10B-1-2. RIGHT-OF-WAY DATA IS CALCULATED.

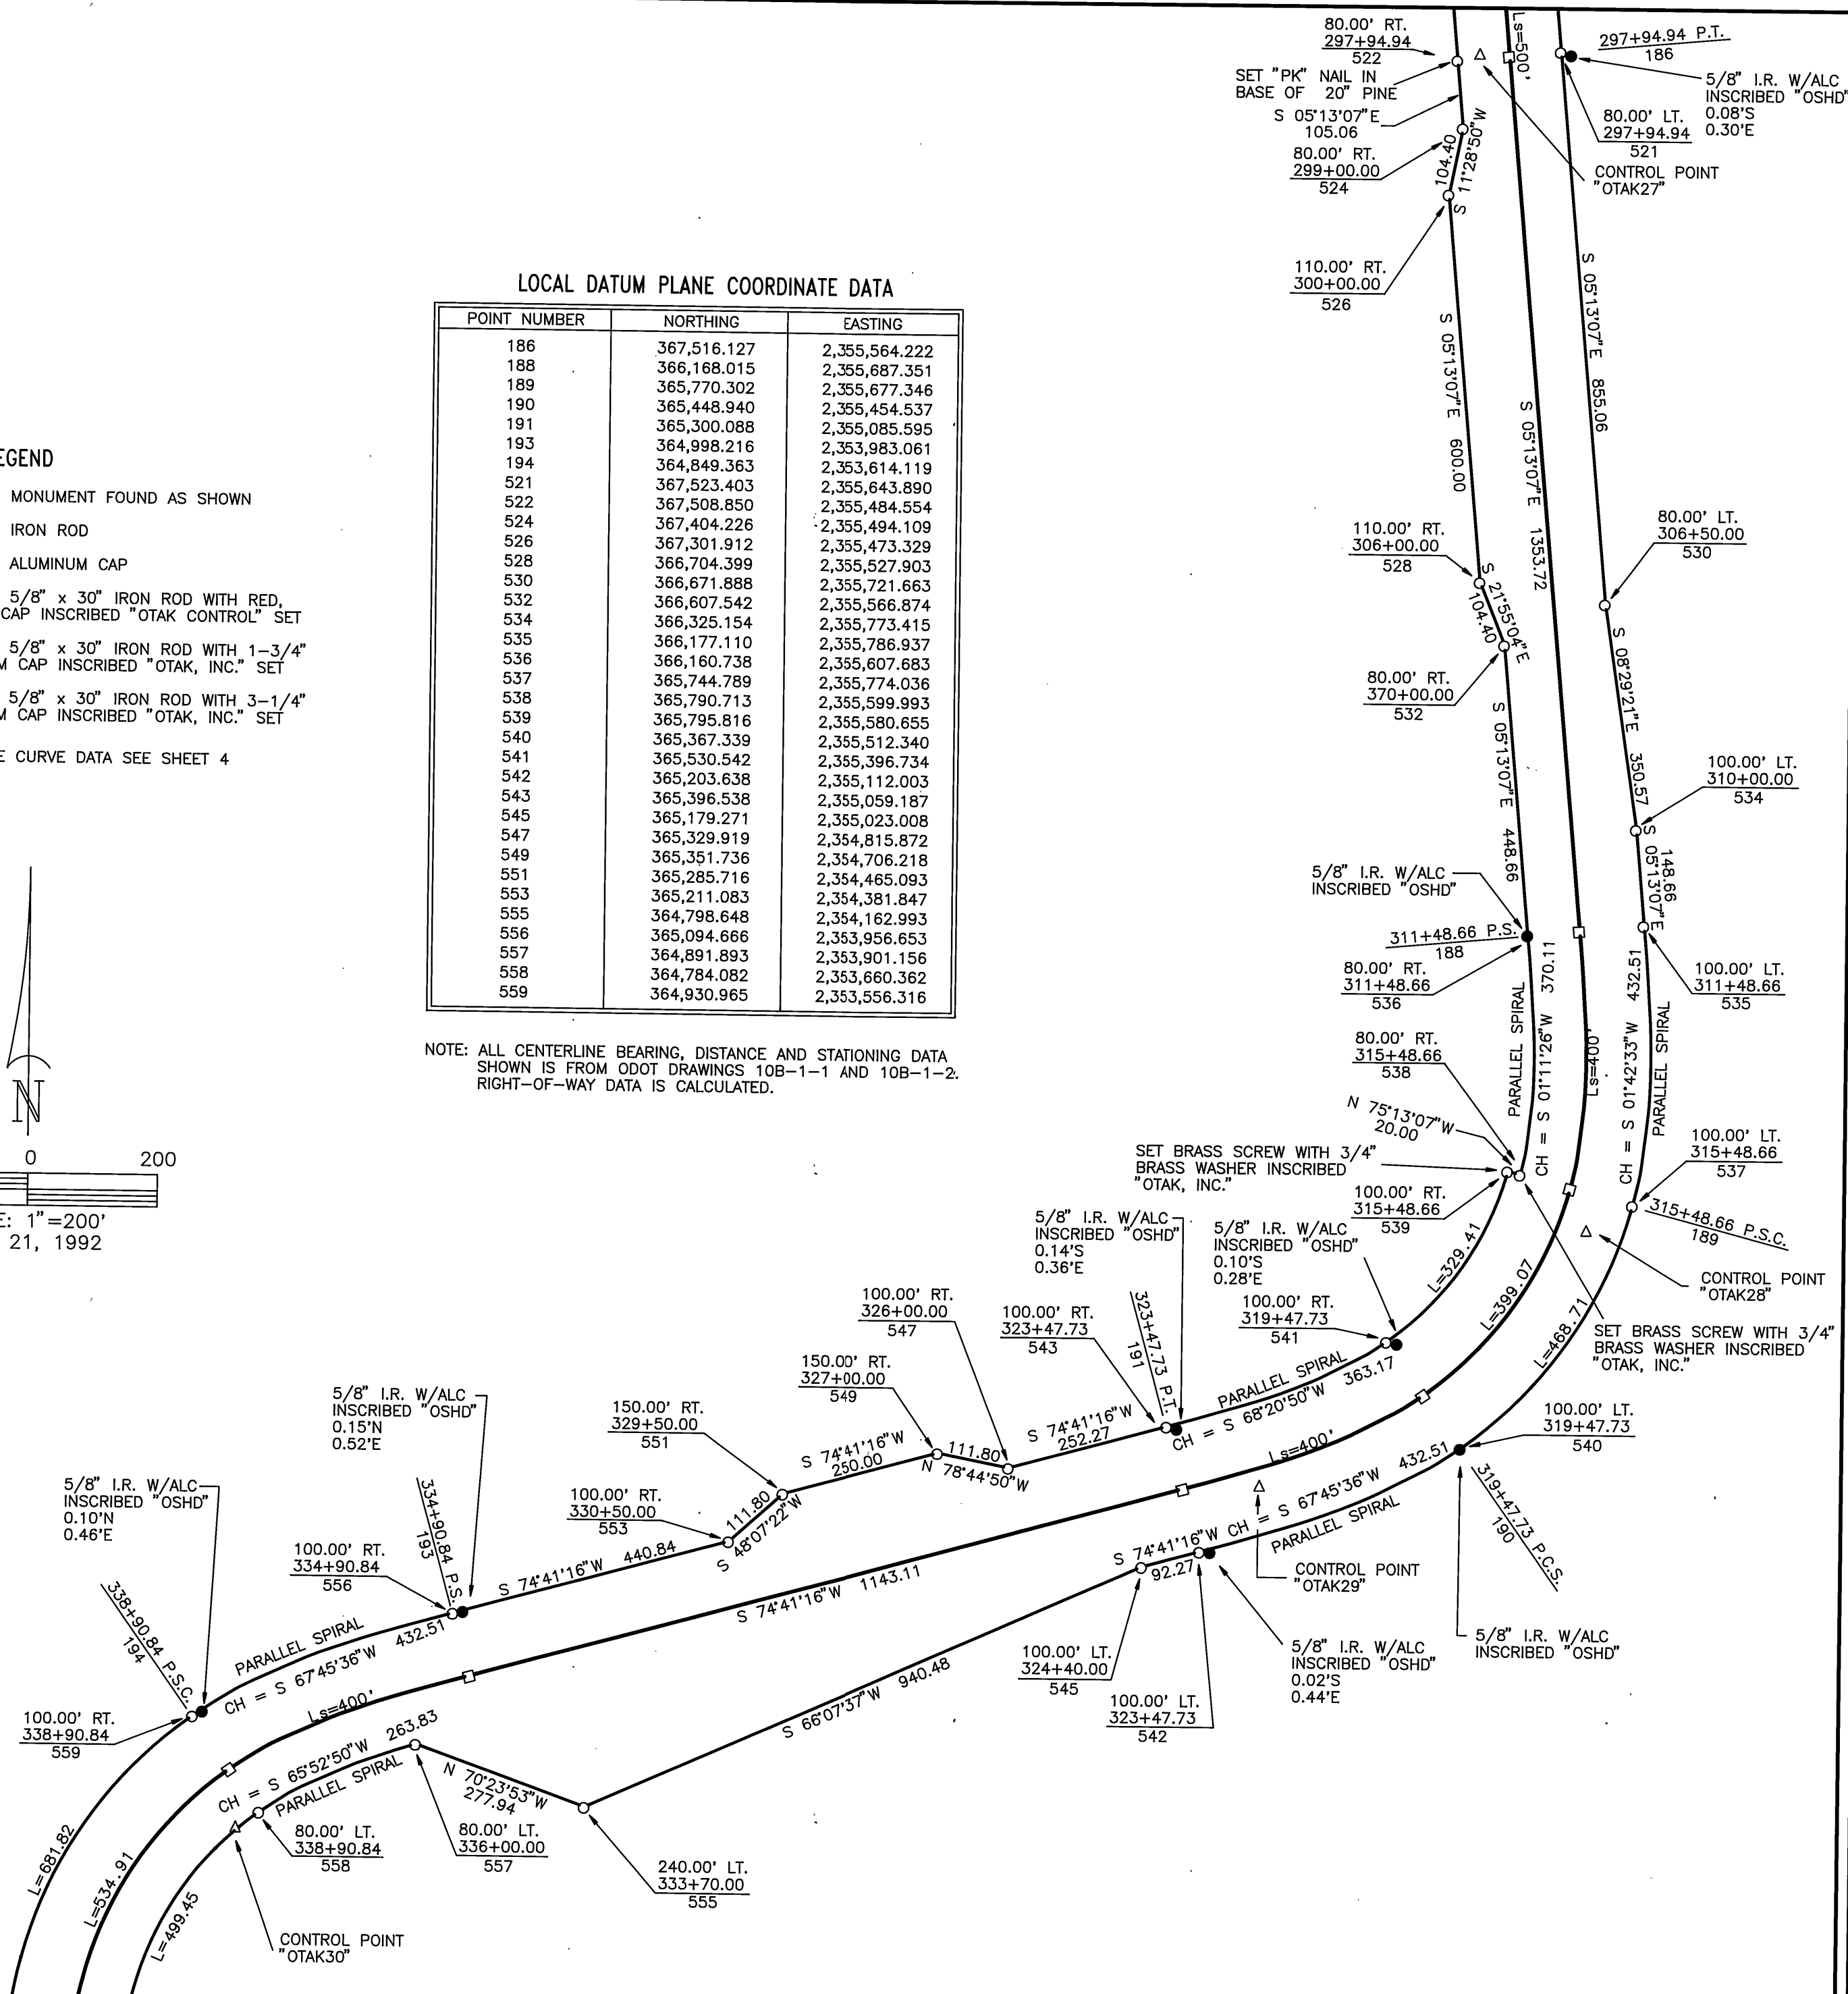

JAC	2/1992
Calculated DTD	Date 2/1992
Drawn DLL	Date 2/1992
Checked	Date

REVISIONS

**REGISTERED
PROFESSIONAL
LAND SURVEYOR**

John A. Carlson
OREGON
JULY 15, 1983
JOHN A. CARLSON
2044

MONUMENTATION SURVEY

PENDLETON-JOHN DAY HIGHWAY
LONG CREEK - FOX SECTION
SECTIONS 9,10,15,16,20,21,22,29,31,32, T.10S., R.30E., W.M.
GRANT COUNTY, OREGON
FOR: OREGON STATE DEPARTMENT OF TRANSPORTATION - HIGHWAY DIVISION

otak
incorporated
17355 S.W. BOONES FERRY ROAD
LAKE OSWEGO, OREGON 97035
(503)635-3618 FAX (503)635-5395

12 OF 13
Sheet No.

3659
Project No.