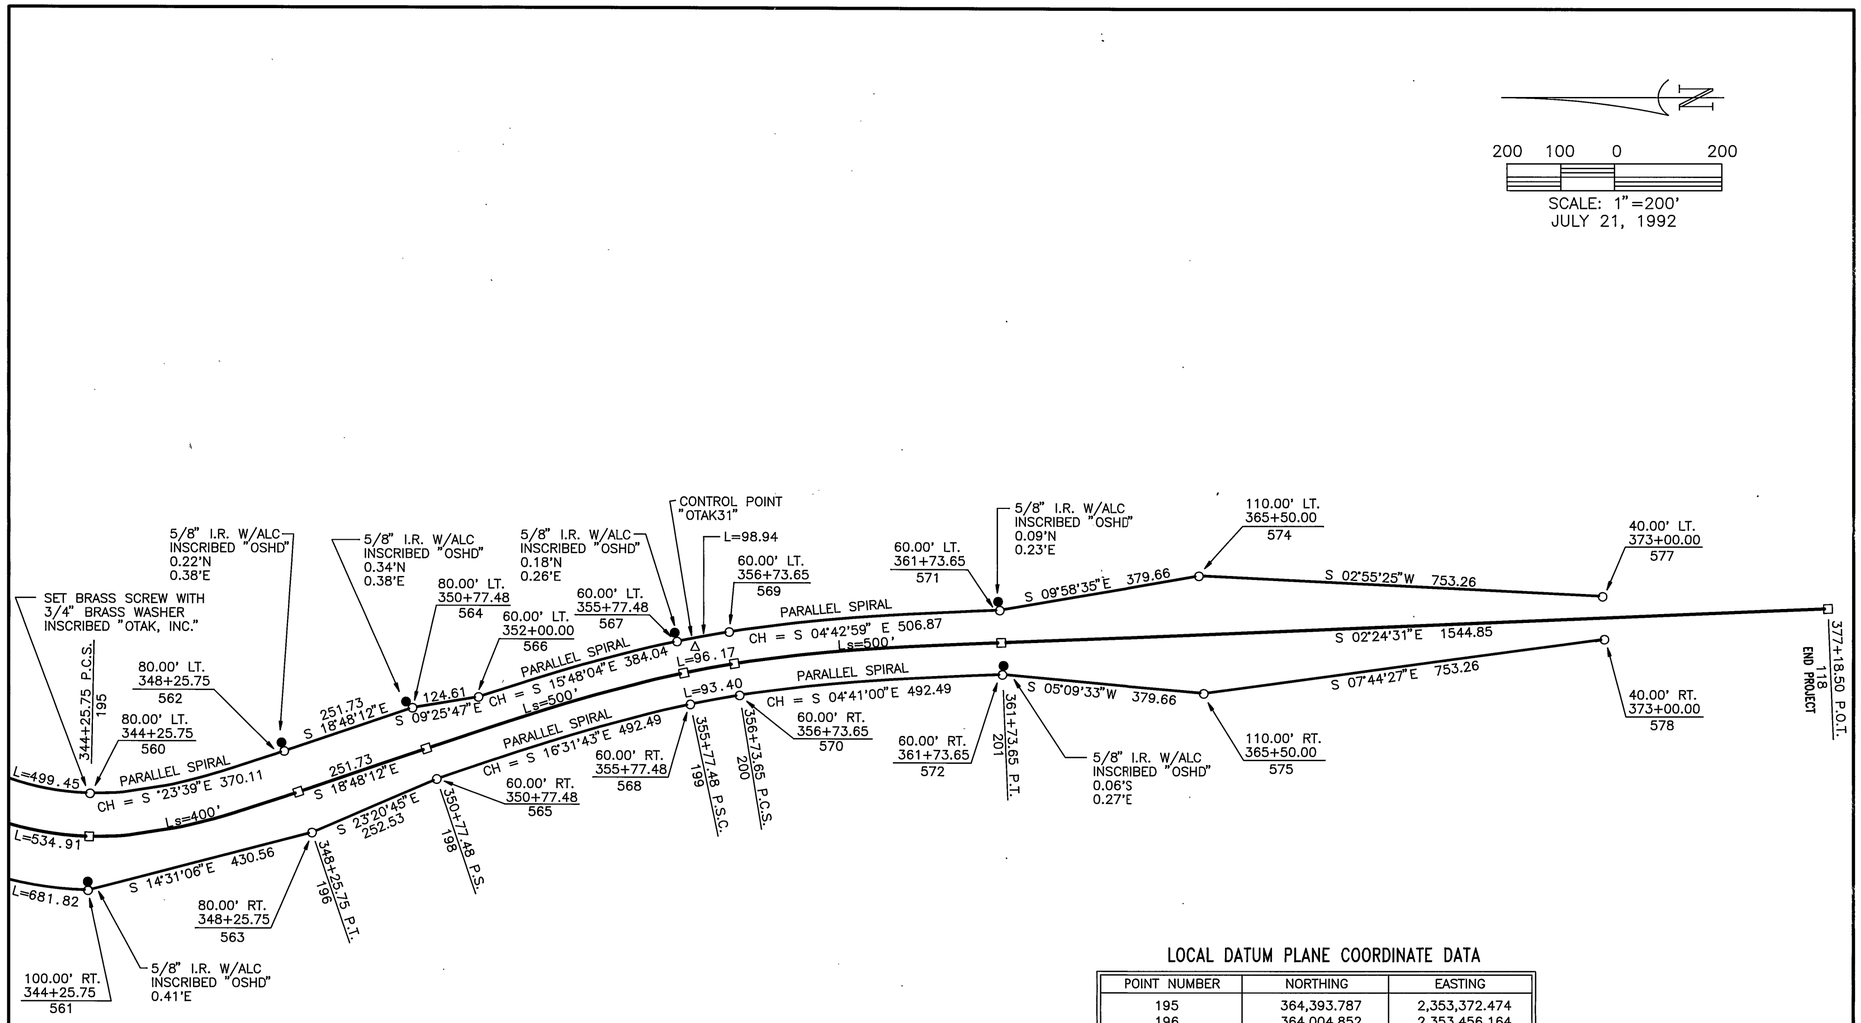

LEGEND

●	DENOTES MONUMENT FOUND AS SHOWN
I.R.	DENOTES IRON ROD
ALC	DENOTES ALUMINUM CAP
△	DENOTES 5/8" x 30" IRON ROD WITH RED, PLASTIC CAP INSCRIBED "OTAK CONTROL" SET
○	DENOTES 5/8" x 30" IRON ROD WITH 1-3/4" ALUMINUM CAP INSCRIBED "OTAK, INC." SET
□	DENOTES 5/8" x 30" IRON ROD WITH 3-1/4" ALUMINUM CAP INSCRIBED "OTAK, INC." SET

FOR CENTERLINE CURVE DATA SEE SHEET 4

LOCAL DATUM PLANE COORDINATE DATA

POINT NUMBER	NORTHING	EASTING
195	364,393.787	2,353,372.474
196	364,004.852	2,353,456.164
198	363,766.554	2,353,537.302
199	363,287.481	2,353,679.319
200	363,192.961	2,353,697.018
201	362,694.962	2,353,737.961
118	361,151.475	2,353,802.885
560	364,392.117	2,353,452.457
561	364,395.876	2,353,272.496
562	364,030.637	2,353,531.894
563	363,979.066	2,353,380.434
564	363,792.340	2,353,613.033
565	363,747.215	2,353,480.505
566	363,669.412	2,353,633.449
567	363,299.882	2,353,738.023
568	363,275.080	2,353,620.615
569	363,202.641	2,353,756.232
570	363,183.282	2,353,637.804
571	362,697.483	2,353,797.908
572	362,692.440	2,353,678.014
574	362,323.567	2,353,863.680
575	362,314.321	2,353,643.875
577	361,571.288	2,353,825.262
578	361,567.926	2,353,745.332

NOTE: ALL CENTERLINE BEARING, DISTANCE AND STATIONING DATA SHOWN IS FROM ODOT DRAWINGS 10B-1-1 AND 10B-1-2. RIGHT-OF-WAY DATA IS CALCULATED.

JAC	2/1992
Calculated	Date
DTD	2/1992
Drawn	Date
DLL	2/1992
Checked	Date

REVISIONS

REGISTERED PROFESSIONAL LAND SURVEYOR
John A. Carlson
OREGON JULY 15, 1983
JOHN A. CARLSON 2044

MONUMENTATION SURVEY

PENDLETON-JOHN DAY HIGHWAY
LONG CREEK - FOX SECTION
SECTIONS 9,10,15,16,20,21,22,29,31,32, T.10S., R.30E., W.M.
GRANT COUNTY, OREGON

FOR: OREGON STATE DEPARTMENT OF TRANSPORTATION - HIGHWAY DIVISION

otak Incorporated
surveyors engineers planners
17355 S.W. BOONES FERRY ROAD
LAKE OSWEGO, OREGON 97035
(503)635-3618 FAX (503)635-5395

3659
Project No.

RECORD MAP OF SURVEY NO. 1221