


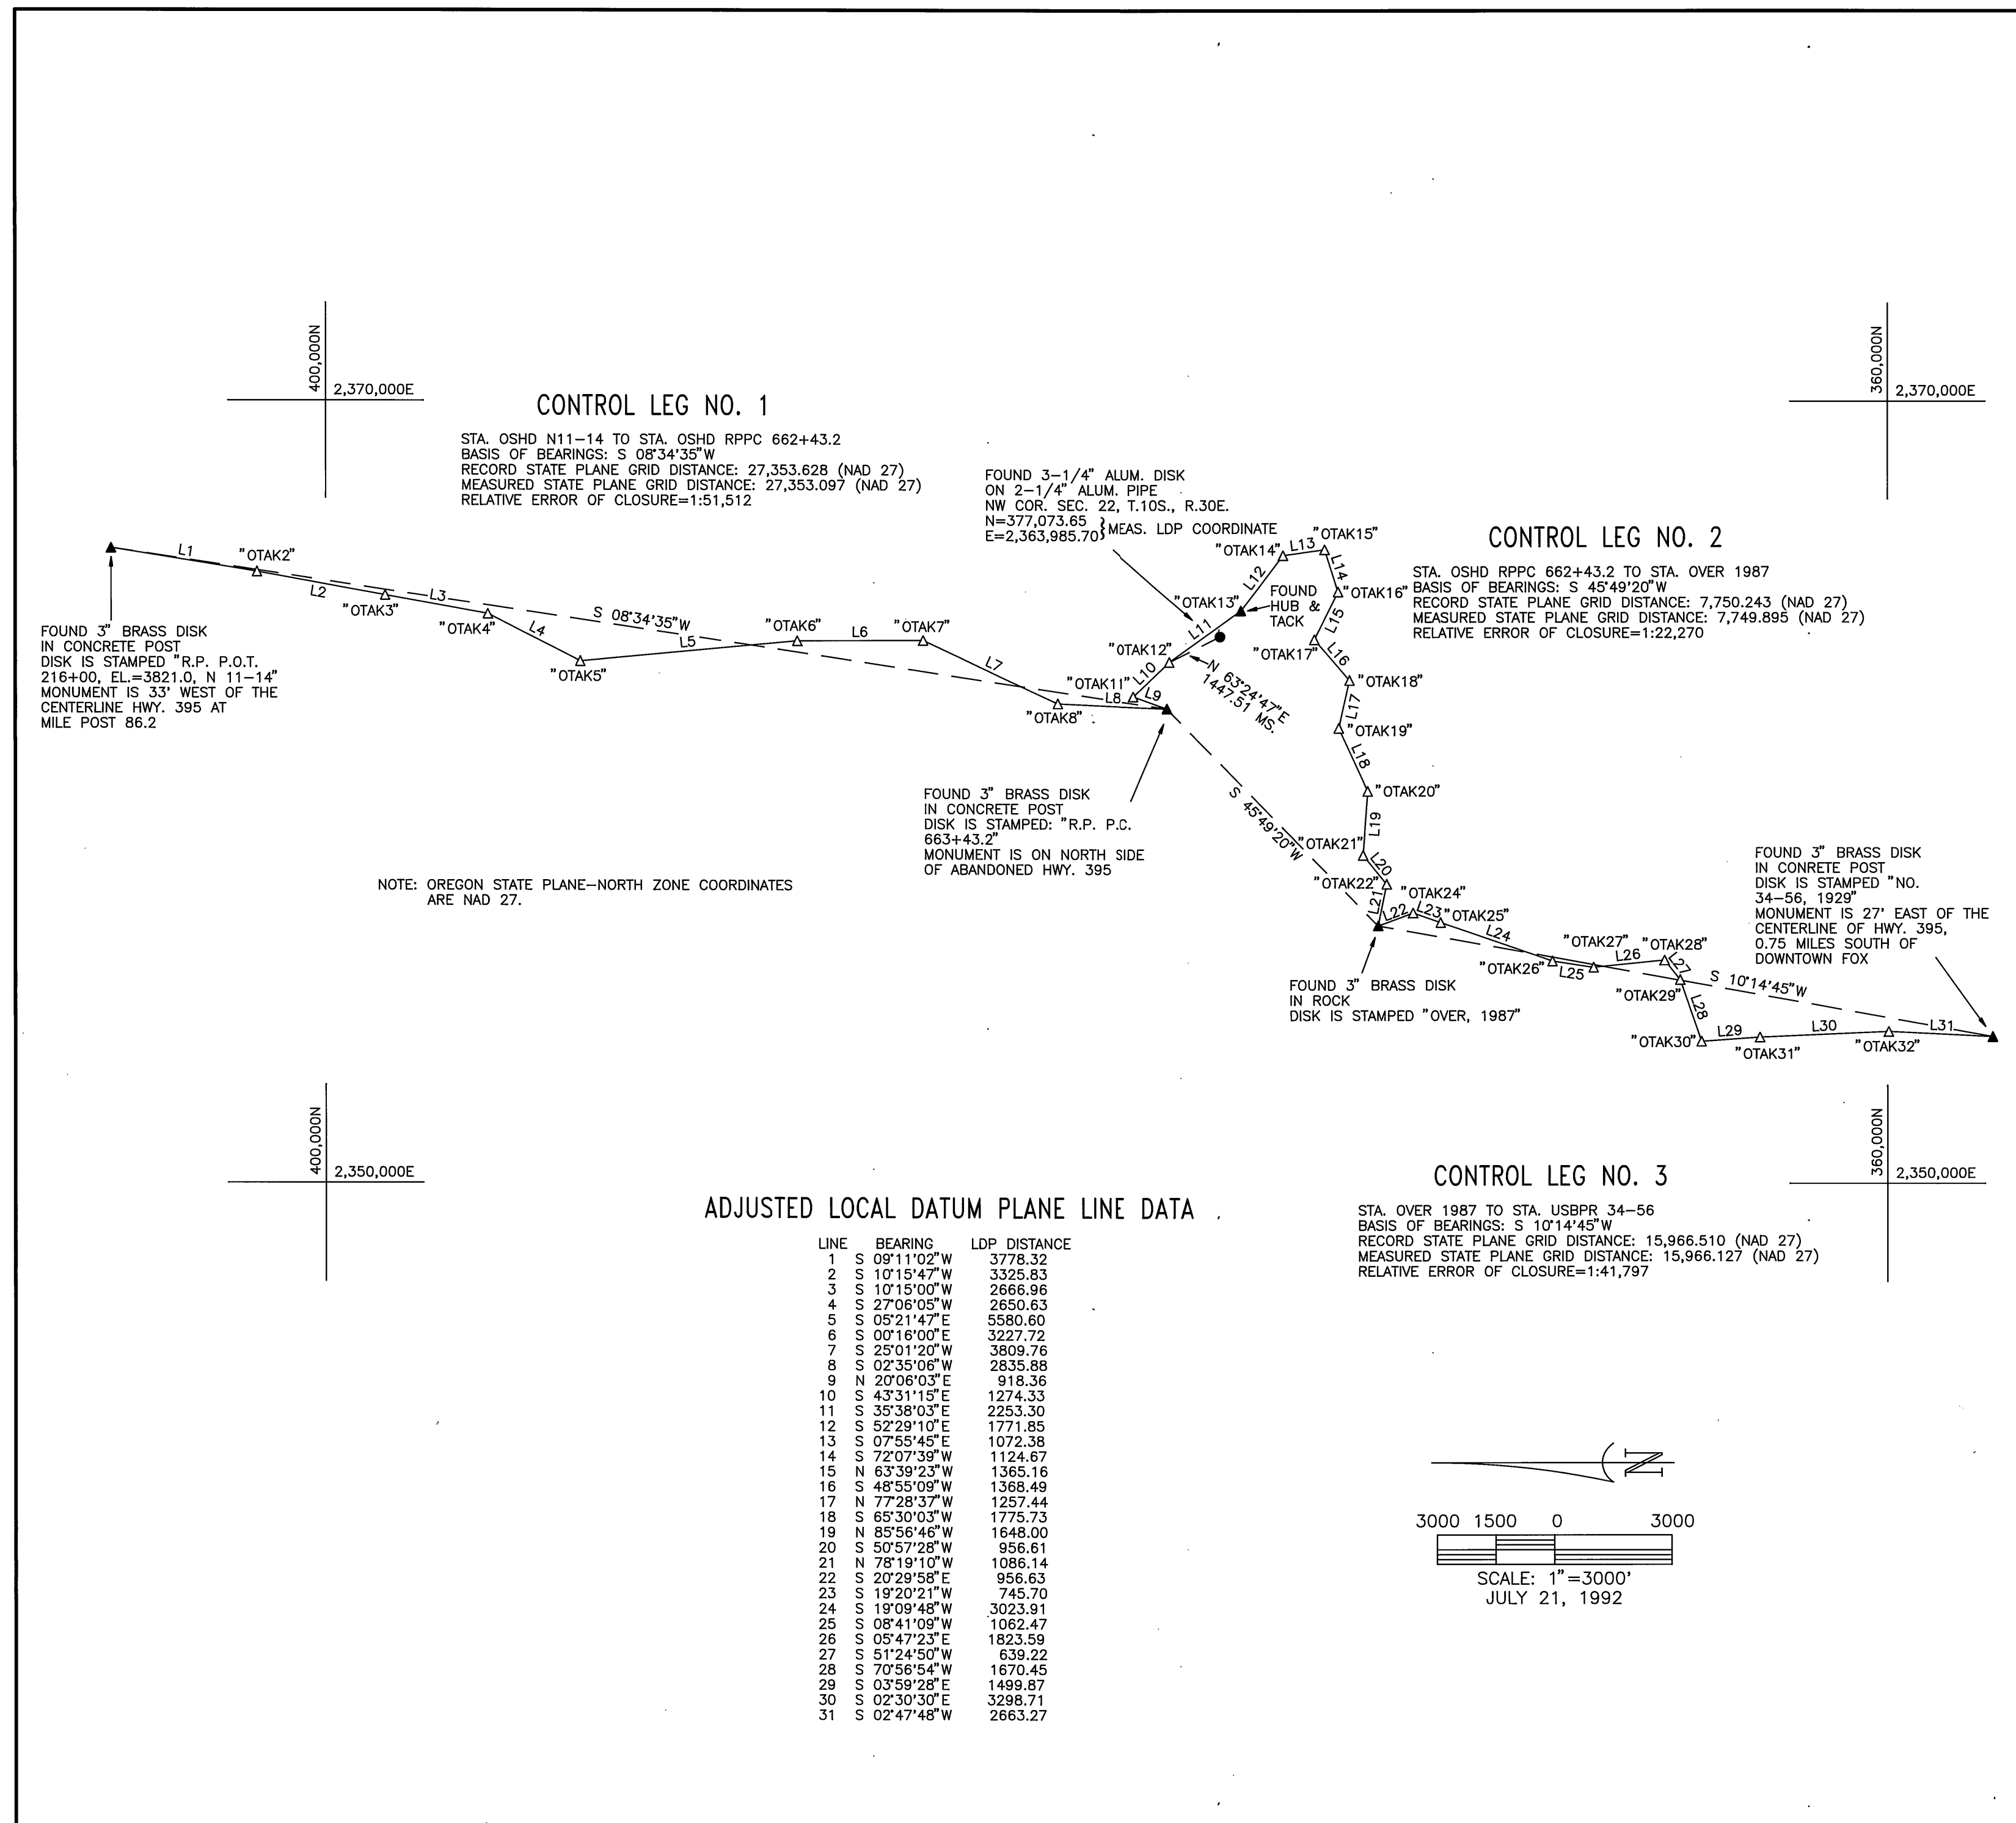

JAC	2/1992
Calculated	Date
DTD	2/1992
Drawn	Date
DLL	2/1992
Checked	Date

REVISIONS

REGISTERED
PROFESSIONAL
LAND SURVEYOR

John A. Carlson

OREGON
JULY 16, 1983
JOHN A. CARLSON
2044

MONUMENTATION SURVEY

PENDLETON-JOHN DAY HIGHWAY
LONG CREEK - FOX SECTION
SECTIONS 9,10,15,16,20,21,22,29,31,32, T.10S., R.30E., W.M.
GRANT COUNTY, OREGON

FOR: OREGON STATE DEPARTMENT OF TRANSPORTATION - HIGHWAY DIVISION

otak
incorporated

17355 S.W. BOONES FERRY ROAD
LAKE OSWEGO, OREGON 97035
(503)635-3618 FAX (503)635-5395

2 OF 13

Sheet No.

3659

Project No.