


- LEGEND**
- DENOTES MONUMENT FOUND AS SHOWN
  - I.R. DENOTES IRON ROD
  - ALC DENOTES ALUMINUM CAP
  - △ DENOTES 5/8" x 30" IRON ROD WITH RED, PLASTIC CAP INSCRIBED "OTAK CONTROL" SET
  - DENOTES 5/8" x 30" IRON ROD WITH 1-3/4" ALUMINUM CAP INSCRIBED "OTAK, INC." SET
  - DENOTES 5/8" x 30" IRON ROD WITH 3-1/4" ALUMINUM CAP INSCRIBED "OTAK, INC." SET
- FOR CENTERLINE CURVE DATA SEE SHEET 4

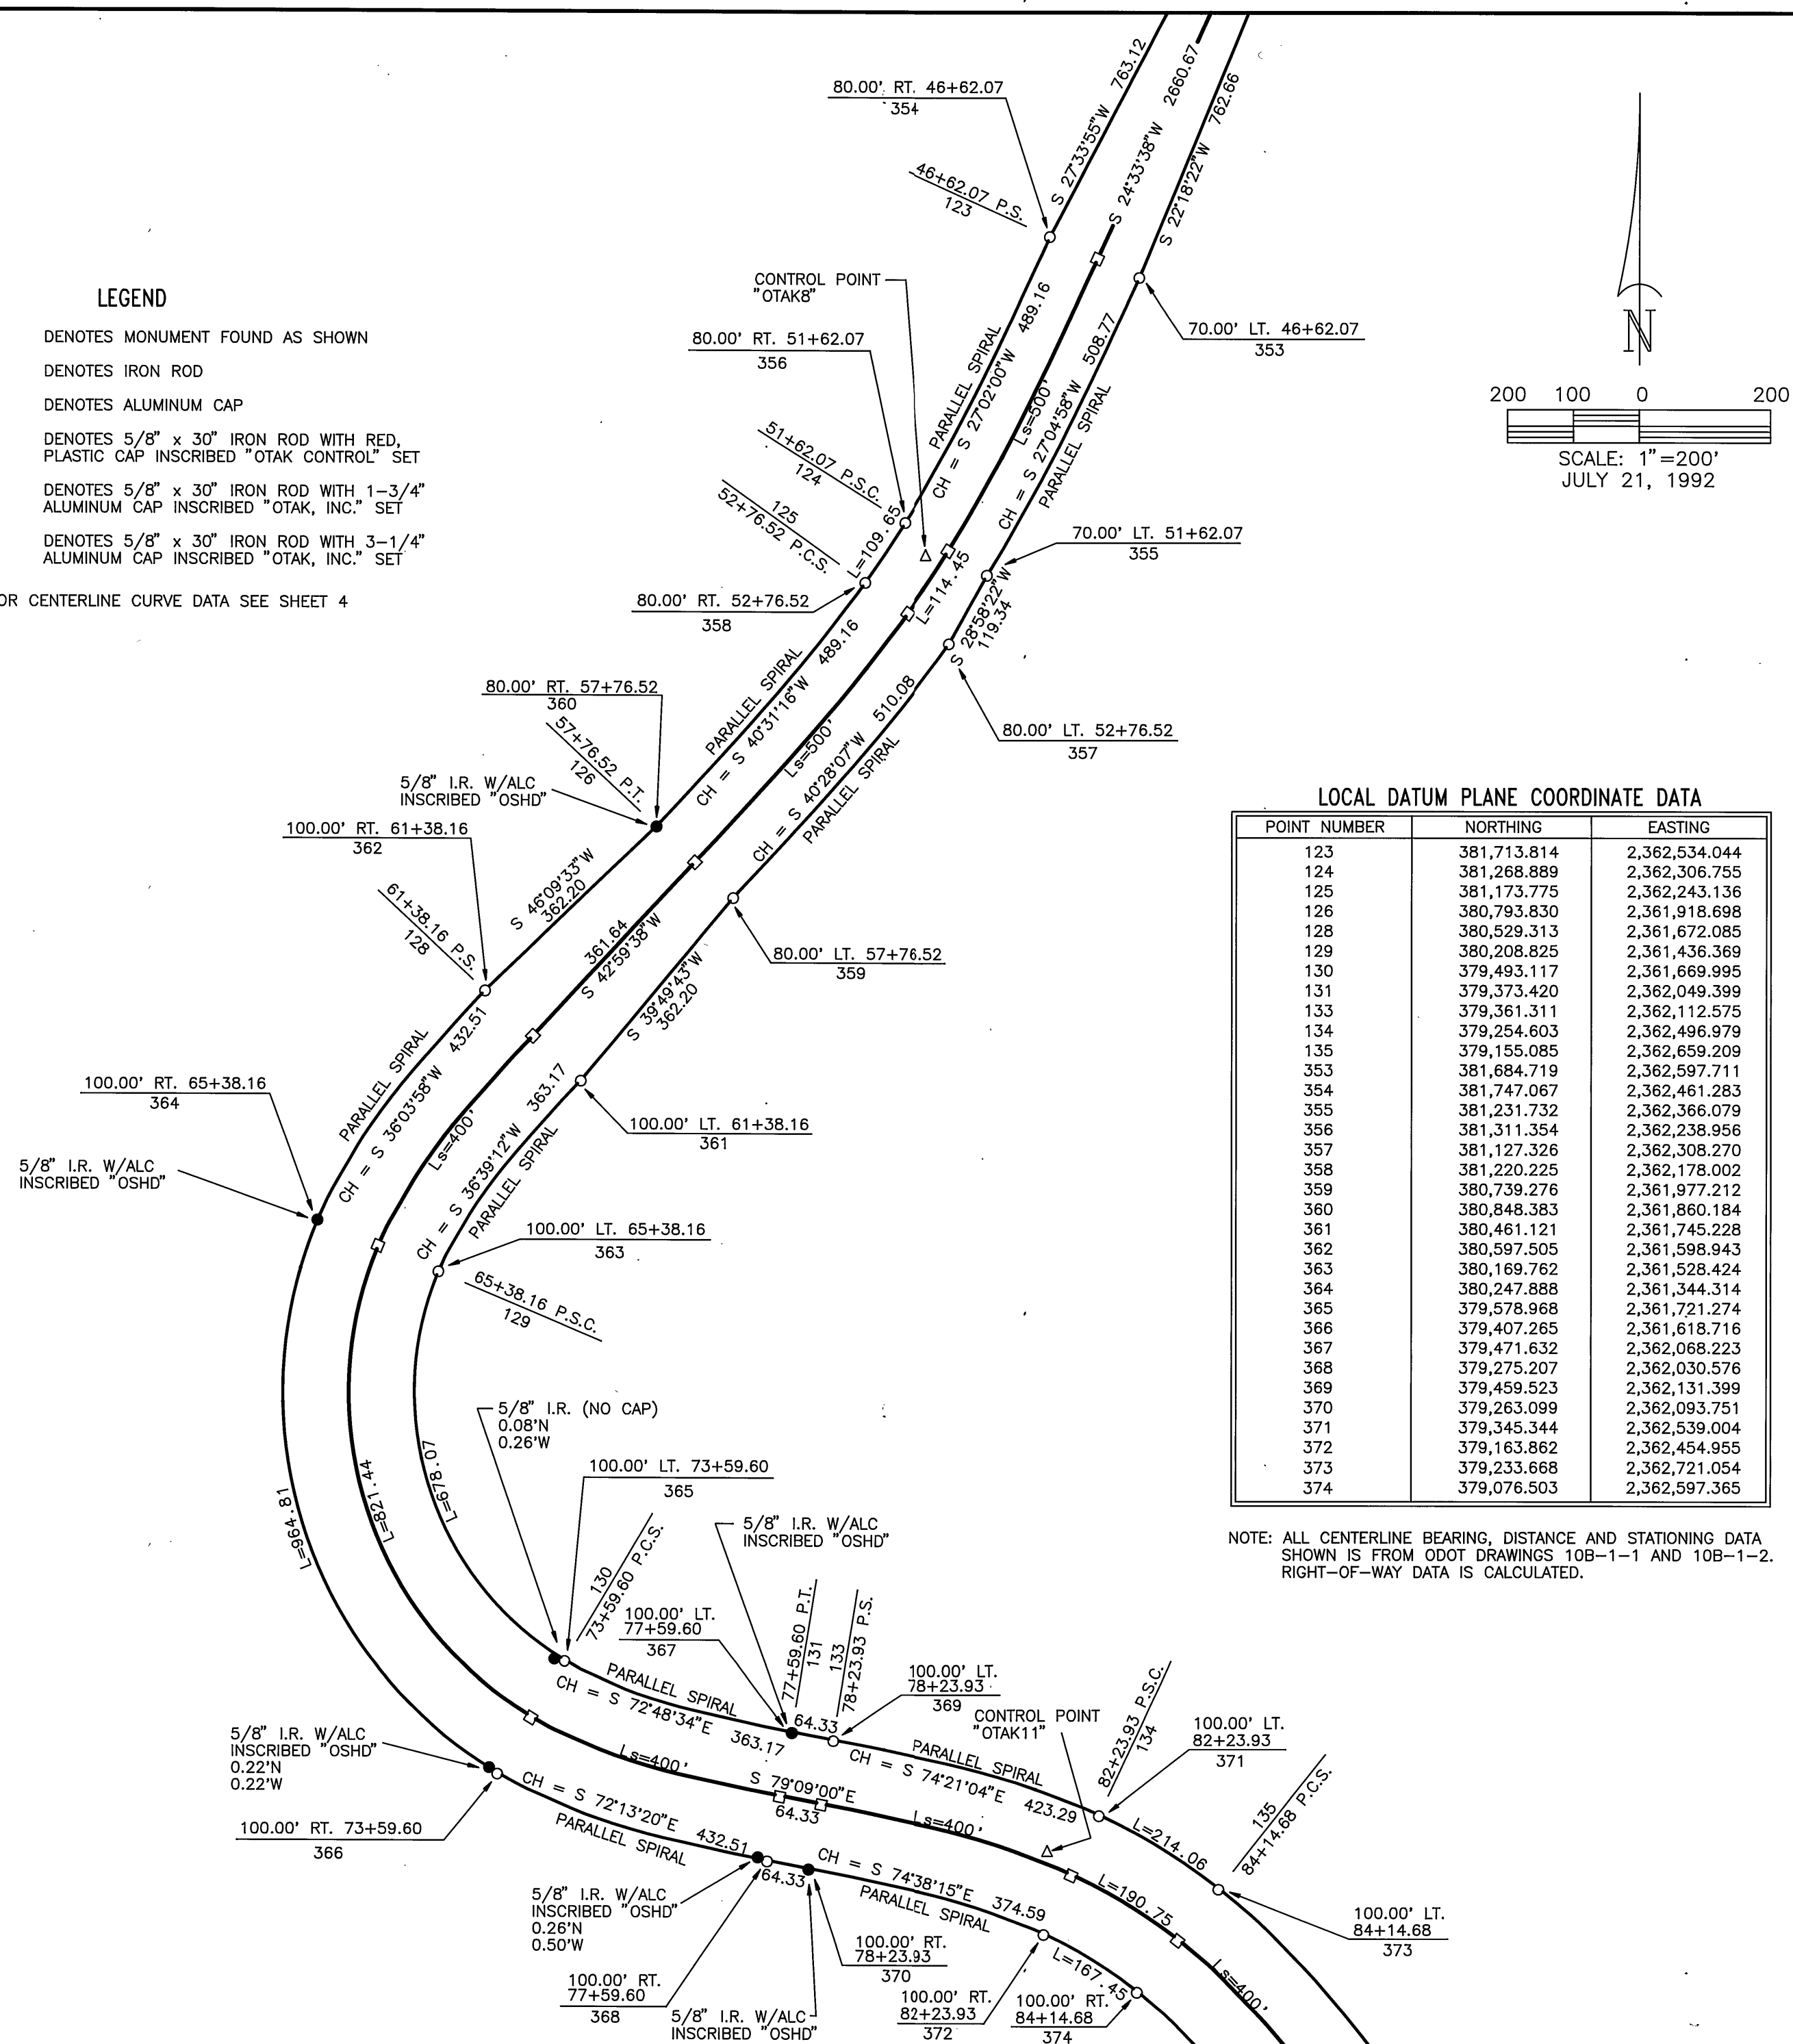

LOCAL DATUM PLANE COORDINATE DATA

| POINT NUMBER | NORTHING    | EASTING       |
|--------------|-------------|---------------|
| 123          | 381,713.814 | 2,362,534.044 |
| 124          | 381,268.889 | 2,362,306.755 |
| 125          | 381,173.775 | 2,362,243.136 |
| 126          | 380,793.830 | 2,361,918.698 |
| 128          | 380,529.313 | 2,361,672.085 |
| 129          | 380,208.825 | 2,361,436.369 |
| 130          | 379,493.117 | 2,361,669.995 |
| 131          | 379,373.420 | 2,362,049.399 |
| 133          | 379,361.311 | 2,362,112.575 |
| 134          | 379,254.603 | 2,362,496.979 |
| 135          | 379,155.085 | 2,362,659.209 |
| 353          | 381,684.719 | 2,362,597.711 |
| 354          | 381,747.067 | 2,362,461.283 |
| 355          | 381,231.732 | 2,362,366.079 |
| 356          | 381,311.354 | 2,362,238.956 |
| 357          | 381,127.326 | 2,362,308.270 |
| 358          | 381,220.225 | 2,362,178.002 |
| 359          | 380,739.276 | 2,361,977.212 |
| 360          | 380,848.383 | 2,361,860.184 |
| 361          | 380,461.121 | 2,361,745.228 |
| 362          | 380,597.505 | 2,361,598.943 |
| 363          | 380,169.762 | 2,361,528.424 |
| 364          | 380,247.888 | 2,361,344.314 |
| 365          | 379,578.968 | 2,361,721.274 |
| 366          | 379,407.265 | 2,361,618.716 |
| 367          | 379,471.632 | 2,362,068.223 |
| 368          | 379,275.207 | 2,362,030.576 |
| 369          | 379,459.523 | 2,362,131.399 |
| 370          | 379,263.099 | 2,362,093.751 |
| 371          | 379,345.344 | 2,362,539.004 |
| 372          | 379,163.862 | 2,362,454.955 |
| 373          | 379,233.668 | 2,362,721.054 |
| 374          | 379,076.503 | 2,362,597.365 |

NOTE: ALL CENTERLINE BEARING, DISTANCE AND STATIONING DATA SHOWN IS FROM ODOT DRAWINGS 10B-1-1 AND 10B-1-2. RIGHT-OF-WAY DATA IS CALCULATED.

|            |        |
|------------|--------|
| JAC        | 2/1992 |
| Calculated | Date   |
| DTD        | 2/1992 |
| Drawn      | Date   |
| DLL        | 2/1992 |
| Checked    | Date   |

REVISIONS

REGISTERED  
PROFESSIONAL  
LAND SURVEYOR

John A. Carlson

OREGON  
JULY 15, 1983  
JOHN A. CARLSON  
2044

MONUMENTATION SURVEY

PENDLETON-JOHN DAY HIGHWAY  
LONG CREEK - FOX SECTION  
SECTIONS 9,10,15,16,20,21,22,29,31,32, T.10S., R.30E., W.M.  
GRANT COUNTY, OREGON

FOR: OREGON STATE DEPARTMENT OF TRANSPORTATION - HIGHWAY DIVISION

otak  
Incorporated  
17355 S.W. BOONES FERRY ROAD  
LAKE OSWEGO, OREGON 97035  
(503)635-3618 FAX (503)635-5395

6 OF 13

Sheet No.

3659

Project No.