
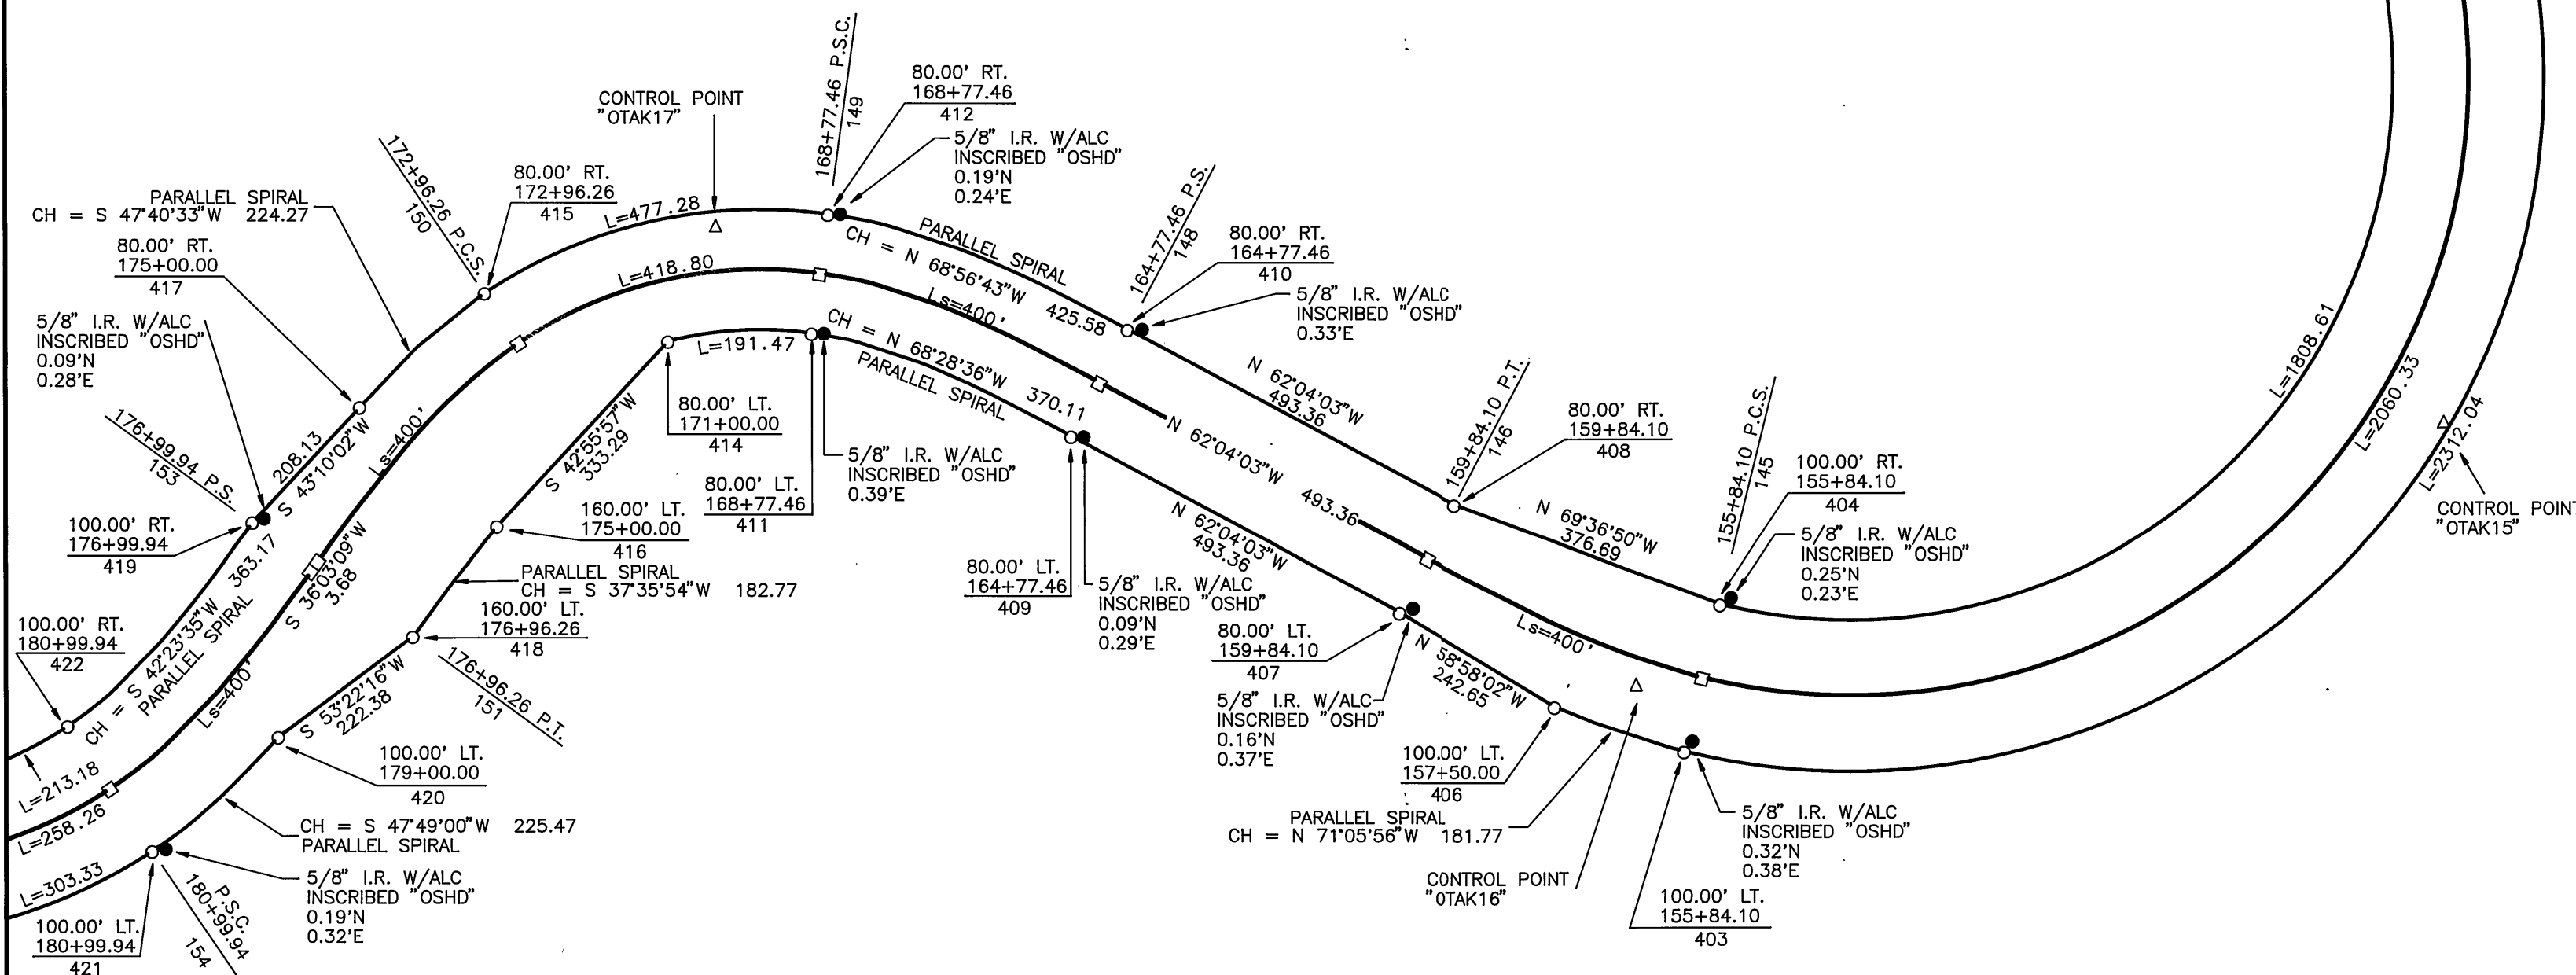


LOCAL DATUM PLANE COORDINATE DATA

POINT NUMBER	NORTHING	EASTING
138	376,607.401	2,364,676.253
139	376,223.911	2,364,996.677
140	376,113.070	2,365,111.632
141	375,806.827	2,365,506.539
143	375,640.253	2,365,738.269
144	375,381.830	2,366,042.194
145	374,058.101	2,365,220.772
146	374,215.696	2,364,854.279
148	374,446.806	2,364,418.388
149	374,591.144	2,364,047.657
150	374,498.966	2,363,648.626
151	374,206.647	2,363,378.766
153	374,203.672	2,363,376.600
154	373,911.353	2,363,106.740
390	376,668.688	2,364,755.271
391	376,546.114	2,364,597.234
392	376,328.199	2,365,104.492
393	376,154.386	2,364,924.800
394	376,224.612	2,365,211.923
395	375,994.091	2,365,004.655
396	375,928.625	2,365,594.091
397	375,676.910	2,365,413.150
398	375,762.051	2,365,825.821
399	375,538.755	2,365,665.309
400	375,581.332	2,366,057.120
401	375,446.496	2,366,118.472
402	375,317.164	2,365,965.916
403	373,961.043	2,365,196.694
404	374,155.159	2,365,244.850
406	374,019.925	2,365,024.723
407	374,145.016	2,364,816.805
408	374,286.376	2,364,891.754
409	374,376.126	2,364,380.913
410	374,517.486	2,364,455.862
411	374,511.910	2,364,036.616
412	374,670.379	2,364,058.697
414	374,501.307	2,363,846.646
415	374,565.330	2,363,603.952
416	374,257.289	2,363,619.632
417	374,414.323	2,363,438.138
418	374,112.483	2,363,508.123
419	374,262.524	2,363,295.753
420	373,979.802	2,363,329.656
421	373,828.398	2,363,162.583
422	373,994.308	2,363,050.897

NOTE: ALL CENTERLINE BEARING, DISTANCE AND STATIONING DATA SHOWN IS FROM ODOT DRAWINGS 10B-1-1 AND 10B-1-2. RIGHT-OF-WAY DATA IS CALCULATED.

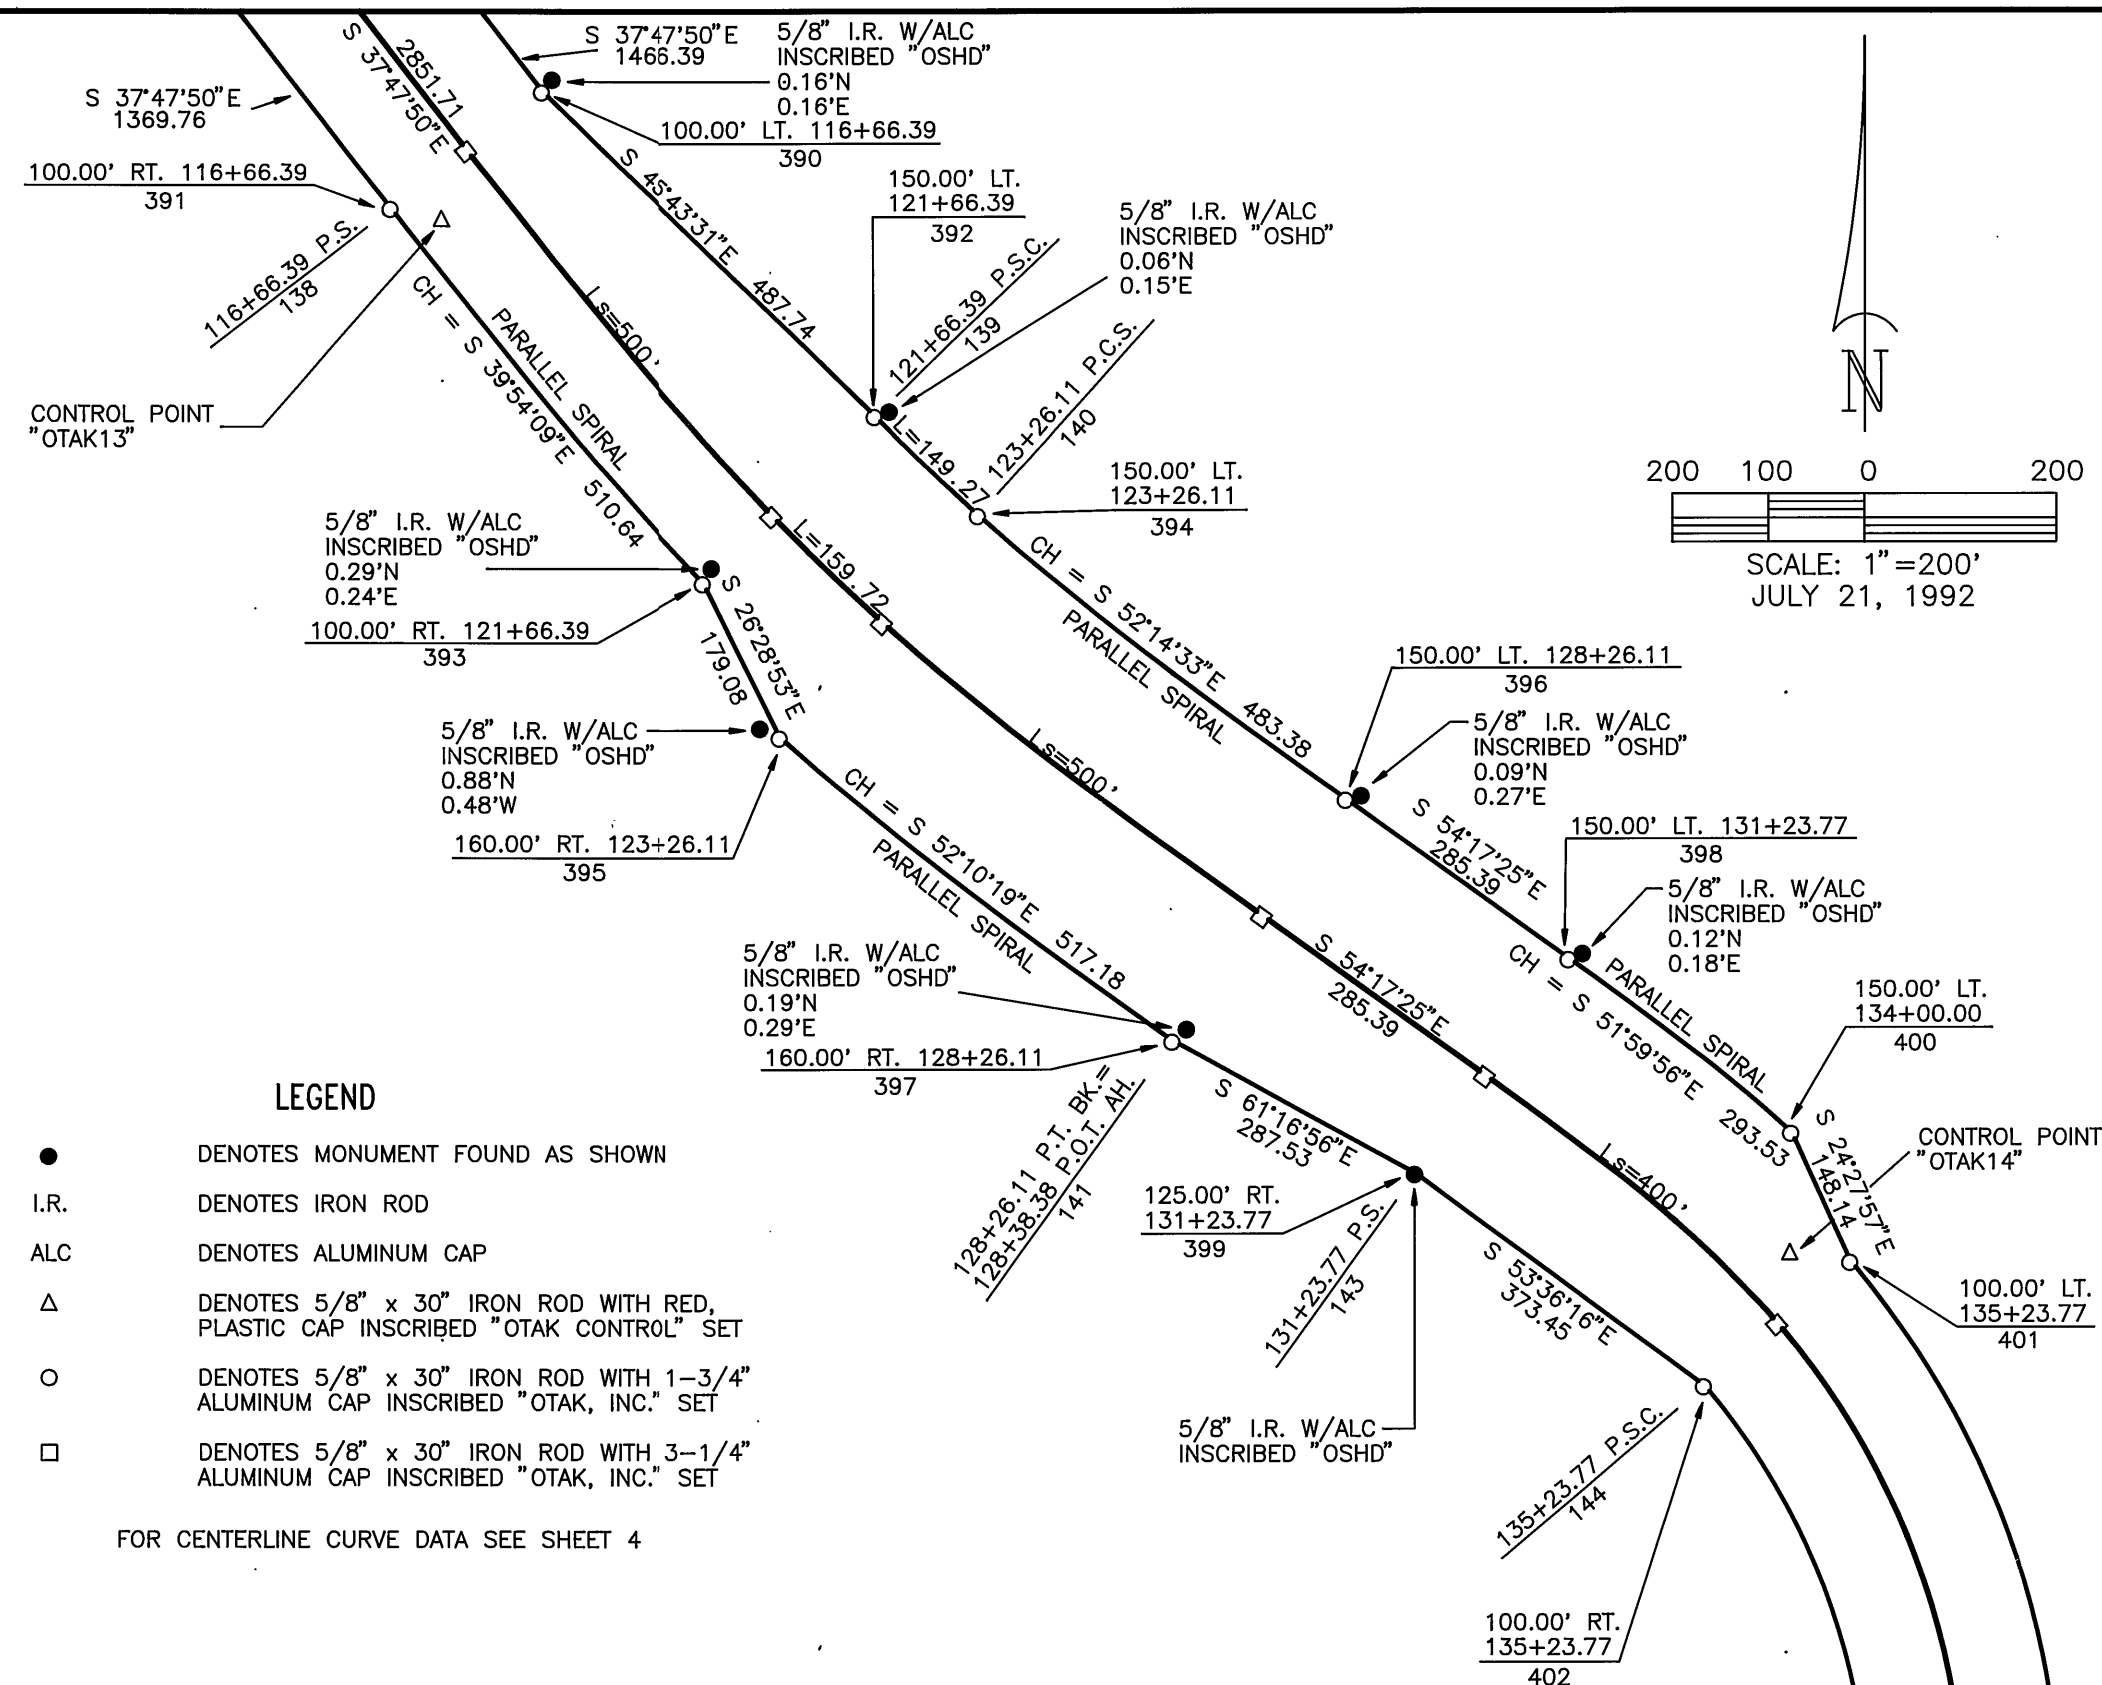

JAC	2/1992
Calculated DTD	Date
Drawn DLL	2/1992
Checked	Date

REVISIONS

REGISTERED
PROFESSIONAL
LAND SURVEYOR

JOHN A. CARLSON
JULY 15, 1983
OREGON
JULY 15, 1983
JOHN A. CARLSON
2044

MONUMENTATION SURVEY

PENDLETON-JOHN DAY HIGHWAY
LONG CREEK - FOX SECTION
SECTIONS 9,10,15,16,20,21,22,29,31,32, T.10S., R.30E., W.M.
GRANT COUNTY, OREGON
FOR: OREGON STATE DEPARTMENT OF TRANSPORTATION - HIGHWAY DIVISION

otak
incorporated
17355 S.W. BOONES FERRY ROAD
LAKE OSWEGO, OREGON 97035
(503)635-3618 FAX (503)635-5395

8 OF 13
Sheet No.
3659
Project No.