


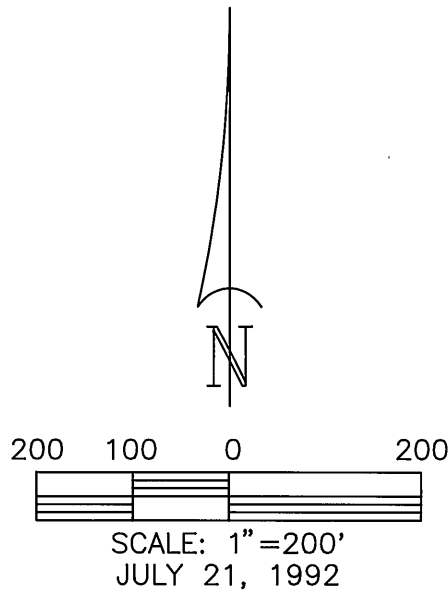

RECORD MAP OF SURVEY NO. 1221