


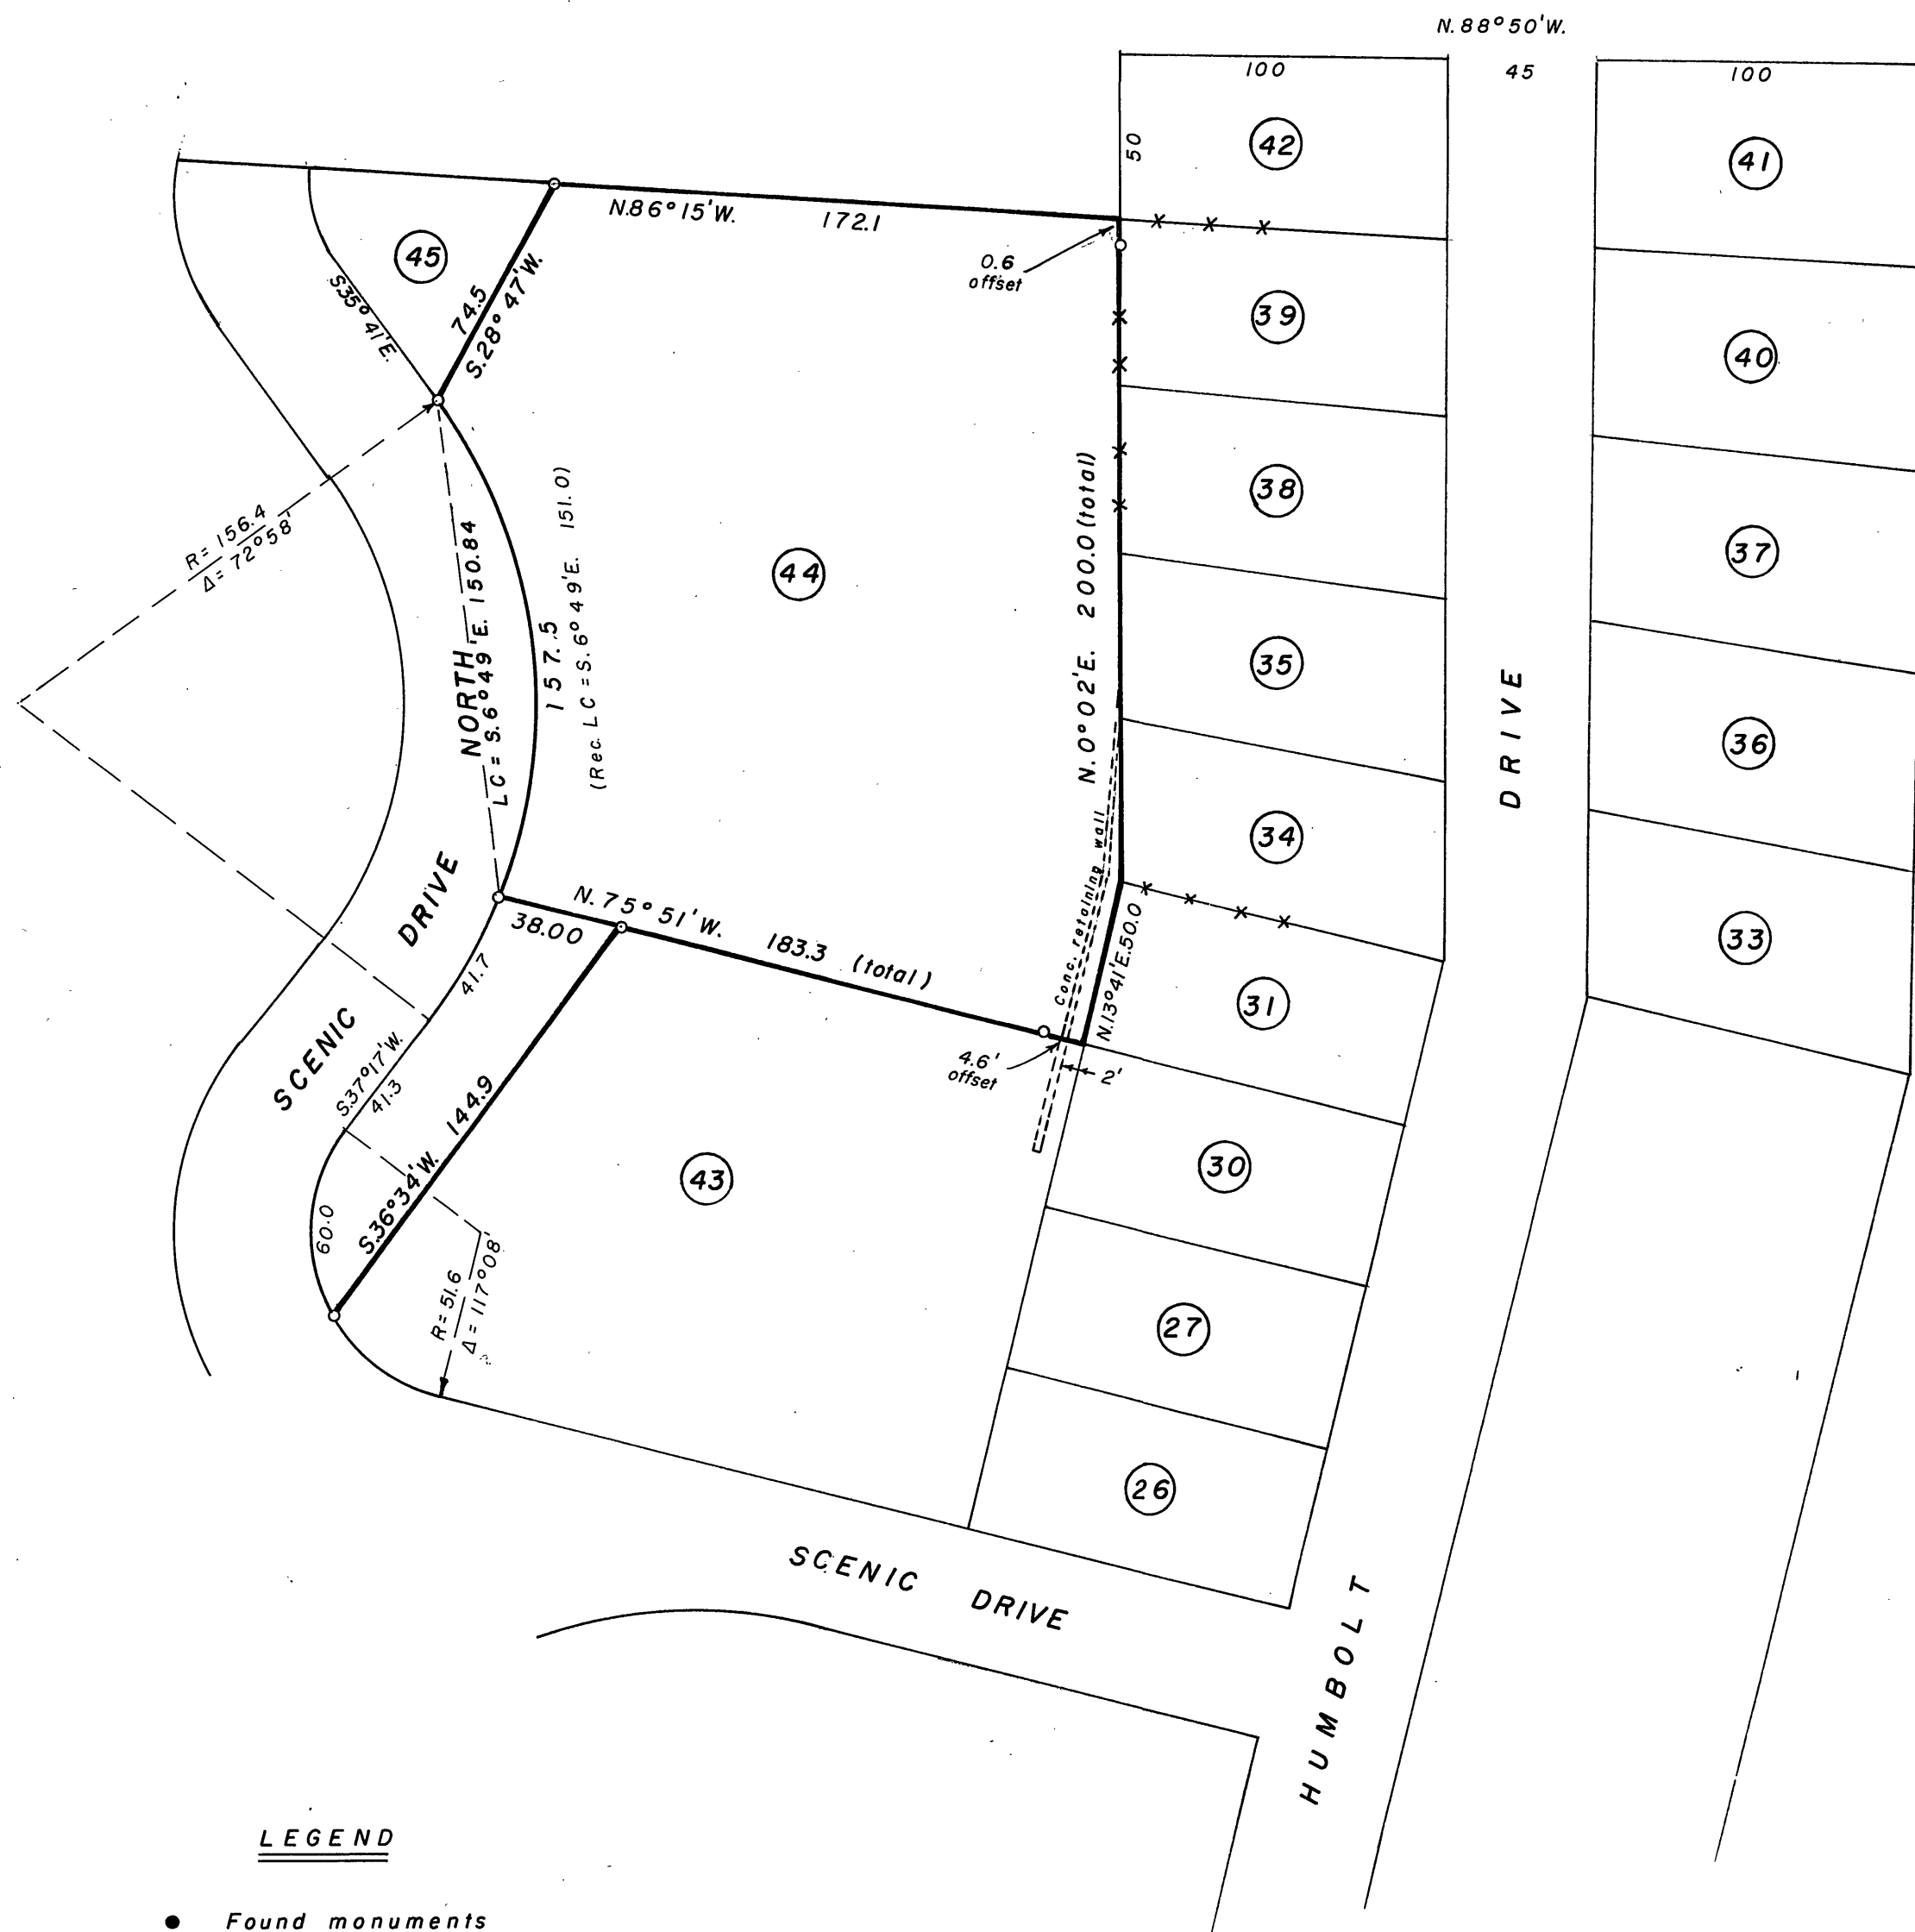

Fd. 1" iron pin

Basis of Bearings
Solar observation

LEGEND

- Found monuments
- Set 5/8" x 30" iron pins
- x-x Fence

RECEIVED AND
FILED
OCT 1 1968
JOHN LIVEIRA, County Clerk
By _____ Deputy

REGISTERED
OREGON
LAND SURVEYOR

Robert D. Bagett
JULY 12, 1963
ROBERT D. BAGETT
598

BAGETT & GRIFFITH SURVEYING
John Day, Oregon
Map of Survey
LOT 44 & PORTION of LOT 43
of
HUMBOLDT ADDITION
to
CANYON CITY, OREGON

SURVEYED FOR	ART THUNELL	
SURVEYED BY	R.D.B. & D.I.G.	8 / 68
SCALE: 1" = 50'	DRAWN BY R.D.B.	8 / 68

Survey Map # 123