


Ferguson Surveying

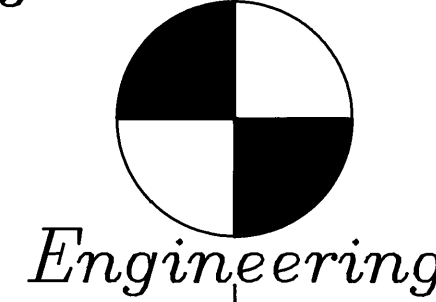

MT. VERNON, OREGON
PHONE (503)932-4520
FAX (503)932-4430

MONUMENTATION

See standard U.S.F.S. "INDEX No." in the circle on the map. Monuments are stamped as shown below. On each Bearing tree, nailed a brass washer stamped "PLS 2405" blaze above the BT scribe and nailed warning signs on the back. Set steel posts with warning and boundary signs, on line within 5 ft. of property corners, or a single post with a warning sign within 5 ft. of controlling corners.

See "CERTIFIED RECORD OF LAND CORNER MONUMENTATION" forms on file in the office of the Grant County Surveyor for a complete history, description of evidence found, monument set, and accessories established at all corners set.

Found aluminum capped monument and accessories as set by George W. Colvin, L.S. 1020, in 1986, from original evidence.

T.13S.

S12 S7

S13 S18

R.34E.


R.35E.

PVT.

N.F.S.L.

PVT.

N.F.S.L.

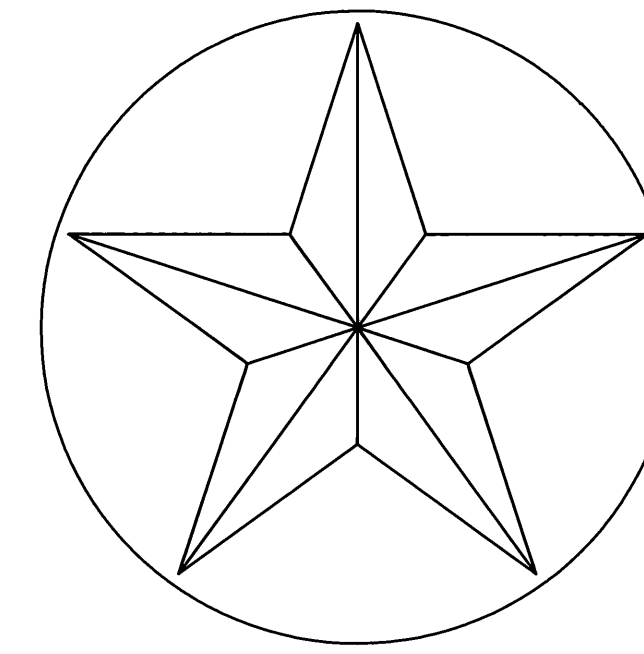

Magnetic Declination 20° East

500 0 500 1000 1500
Scale: 1"=500'

Basis of Bearing: Solar Observations
with the True Meridian through the
center of Section 19.

LEGEND

- Monumented from original evidence.
Set 2-1/2" x 30" aluminum pipe with 3-1/4" aluminum cap, stamped as shown in the "Monumentation" Section
- Set 2-1/2" x 30" aluminum pipe with 3-1/4" aluminum cap, stamped as shown in the "Monumentation" Section
- Found monument of record, as described in the "History" and notes at each corner.
- Record bearing and distance as returned by John B. David in 1869 under G.L.O. Contract No. 131
- Record bearing and distance as returned by Bamford Robb in 1881 under G.L.O. Contract No. 383
- Record bearing and distance as returned by David B. Armstrong, PLS 1026 in 1981. Grant County Map of Survey Number 700.
- Record bearing and distance as returned by Douglas M. Ferguson, PLS 848 in 1987. Grant County Map of Survey Number 1013.
- Exterior Section Lines
- Center Section Lines
- Subdivisional Lines
- N.F.S.L. National Forest System Lands
- PVT. Private Land
- Marked Forest boundary with steel fence posts and Forest boundary signs at Maximum intervals of 250 feet.
- Existing fence with long line showing direction
- Existing road
- U.S.F.S. Index Number

L-1	T13S R34E R35E 1/4 S13S18 1992 PLS 2405	Douglas Fir, 8" dia., bears N42°27'W, 6.8 ft., scribed: 1/4 S13 BT Lodgepole Pine, 10" dia., bears N08°56'E, 28.8 ft., scribed: 1/4 S18 BT Douglas Fir, 14" dia., bears S80°47'E, 43.0 ft., scribed: 1/4 S18 BT Lodgepole Pine, 8" dia., bears S11°19'W, 24.6 ft., scribed: 1/4 S18 BT
N-1	T13S R34E R35E S13S18 S24S19 1992 PLS 2405	Douglas Fir, 12" dia., bears N48°15'W, 23.1 ft., scribed: T13S R34E S13 BT Douglas Fir, 16" dia., bears S39°15'E, 28.8 ft., scribed: T13S R35E S19 BT Ponderosa Pine, 24" dia., bears S47°30'W, 68.8 ft., scribed: T13S R34E S24 BT
N-3	T13S R35E S18 1/4 S19 1992 PLS 2405	White Fir, 14" dia., bears N36°45'W, 10.0 ft., scribed: 1/4 S18 BT White Fir, 10" dia., bears N68°30'E, 24.5 ft., scribed: 1/4 S18 BT White Fir, 20" dia., bears S48°15'E, 25.9 ft., scribed: 1/4 S19 BT White Fir, 14" dia., bears S83°45'W, 21.3 ft., scribed: 1/4 S19 BT
N-4	T13S R35E S18 E1/16 S19 1992 PLS 2405	Douglas Fir, 16" dia., bears N40°15'W, 8.5 ft., scribed: E1/16 S18 BT White Fir, 12" dia., bears S58°30'E, 30.7 ft., scribed: E1/16 S19 BT
D-4	T13S R35E NE 1/16 S 19 1992 PLS 2405	Ponderosa Pine, 12" dia., bears N35°02'W, 24.8 ft., scribed: NE1/16 S19 BT Ponderosa Pine, 14" dia., bears S87°01'E, 28.5 ft., scribed: NE1/16 S19 BT
P-1	T13S R34E R35E 1/4 S24S19 1992 PLS 2405	Western Larch, 16" dia., bears N47°13'W, 135.4 ft., scribed: 1/4 S24 BT White Fir, 14" dia., bears N00°08'E, 43.1 ft., scribed: 1/4 S19 BT White Fir, 14" dia., bears S47°54'E, 25.2 ft., scribed: 1/4 S19 BT Douglas Fir, 9" dia., bears S33°02'W, 12.1 ft., scribed: 1/4 S24 BT
P-3	T13S R35E C1/4 S 19 1992 PLS 2405	Ponderosa Pine, 12" dia., bears N06°27'W, 30.7 ft., scribed: C1/4 S19 BT Ponderosa Pine, 16" dia., bears N69°09'E, 24.0 ft., scribed: C1/4 S19 BT Ponderosa Pine, 10" dia., bears S44°01'E, 12.6 ft., scribed: C1/4 S19 BT Douglas Fir, 12" dia., bears S62°43'W, 31.3 ft., scribed: C1/4 S19 BT

Found 14" x 14" x 8" stone, clearly marked, and two unrecorded bearing trees. Accepted stone and set monument.

Found 16" x 14" x 10" stone, clearly marked. Accepted and set monument.

Searched, found no evidence. Corner lost to logging operations. Set monument at proportionate measure.

Found brass capped monument and accessories as set by Robert D. Baggett, Grant County Survey, in 1987, from original evidence.

NOT SURVEYED THIS SURVEY
PVT.

Found aluminum capped monument and accessories as set by David B. Armstrong, L.S. 1026, in 1981, from original evidence.

Found aluminum capped monument and accessories as set by David B. Armstrong, L.S. 1026, in 1981.

Found aluminum capped monument and accessories as set by David B. Armstrong, L.S. 1026, in 1981, from original evidence.

Found aluminum capped monument and accessories as set by Douglas M. Ferguson, P.L.S. 848, in 1987, by proportionate measure.

REGISTERED
PROFESSIONAL
LAND SURVEYOR
Susan E. Newstetter
OREGON
JULY 26, 1988
SUSAN E. NEWSTETTER
2405
Exp: 12/31/94