

LEGEND

© Set monument as described below.

1078
+ Legal Description point number

Courses between points 1070 and 1090, shown below, are Grant Boundary adjusted based on record courses shown in parenthesis.

1070
A point feet northerly of and perpendicular to the centerline of U.S.F.S. Trail 1606, at foot of spur ridge. Set a 2-1/2"x30" aluminum monument with 3" aluminum cap stamped:
NORTH FORK
JOHN DAY
WILDERNESS
NO. 1070
1992
PLS 848

From which: A Lodge Pole Pine, 10" dia., bears S01°45'E, 20.5 ft.
A Lodge Pole Pine, 8" dia., bears N44°45'W, 25.2 ft.
BT's scribed NFJDW NO 1070 BT.

Placed steel fence post with Wilderness Boundary sign 5' Northerly on line.

N 2°42'21"E, 115.31' (N02°17'W, 100')
1071 N 1°36'39"W, 190.26' (N06°36'W, 165') (Northerly along a spur ridge)
1072 N 9°47'39"W, 148.57' (N14°47'W, 129')
1073 N 3°33'21"E, 230.62' (N01°26'W, 200')
1074 N17°12'21"E, 201.79' (N12°13'E, 175')
1075 N35°52'21"E, 281.36' (N30°53'E, 244')
1076 N54°07'21"E, 159.13' (N49°08'E, 138')
1077 N61°24'21"E, 168.35' (N56°25'E, 146') (Northerly along a spur ridge)
1078 N60°47'21"E, 178.73' (N55°48'E, 155')
1079 N56°51'47"E, 117.12' (N51°26'E, 101')

1080
A point on said spur ridge, 400 feet northerly and perpendicular to the high water line on the north shore of Crawfish Lake. Set a 2-1/2"x30" aluminum monument with 3" aluminum cap stamped:

NORTH FORK
JOHN DAY
WILDERNESS
NO. 1080
1992
PLS 848

From which: A Lodge Pole Pine, 14" dia., bears N12°15'W, 24.9 ft.
A Spruce, 10" dia., bears S65°45'W, 7.7 ft.
BT's scribed NFJDW NO 1080 BT.

Placed steel fence post with Wilderness Boundary sign 12' Easterly on line.

N83°01'10"E, 150.22' (N65°58'E, 182')
1081 S86°00'50"E, 153.52' (N76°56'E, 186')
1082 S77°38'50"E, 110.60' (N85°18'E, 134')
1083 S64°31'51"E, 95.75' (S81°35'E, 116') (Descending Easterly)

1084 A point in Crawfish Creek 600 feet down stream from the high water line at the outlet of Crawfish Lake. Set a 5/8"x 30" iron pin with a yellow plastic cap stamped: PLS 848

From which: A Spruce, 28" dia., bears S57°45'E, 34.2 ft.
A Spruce, 18" dia., bears S07°30'W, 40.0 ft.
BT's scribed NFJDW NO 1084 BT.
A 2-1/2"x30" aluminum monument with 3" aluminum cap bears S25°26'E, 10.8 ft., stamped:

NORTH FORK
JOHN DAY
WILDERNESS
NO. 1084
1992
PLS 848

Placed steel fence post with Wilderness Boundary sign 4' Southerly on line.

1084 S25°27'11"E, 73.19' (S30°10'E, 86')
1085 S00°47'11"E, 115.75' (S05°30'E, 136')
1086 S 7°10'11"E, 131.92' (S11°53'E, 155')
1087 S16°13'11"E, 104.69' (S20°56'E, 123') (Ascending southeasterly)
1088 S60°09'11"E, 75.75' (S64°52'E, 89')
1089 S66°20'20"E, 89.36' (S71°03'E, 105')

1090 A point in the inlet stream, Crawfish Lake. Elevation 6,920 feet. Set a 5/8"x 30" iron pin with a yellow plastic cap stamped: PLS 848

From which: A Spruce, 22" dia., bears N69°45'E, 39.8 ft.
A Spruce, 20" dia., bears N65°15'W, 27.8 ft.
BT's scribed NFJDW NO 1090 BT.
A 2-1/2"x30" aluminum monument with 3" aluminum cap bears N66°20'W, 23.2 ft., stamped:

NORTH FORK
JOHN DAY
WILDERNESS
NO. 1090
1992
PLS 848

Placed steel fence post with Wilderness Boundary sign 5' Easterly on line.

Courses between points 1090 and 1105, shown below, are 'Ascending the inlet stream, Crawfish Lake', as per the Legal Description.

1090 S59°29'53"E, 113.44' (S55°31'E, 120')
1091 S62°33'42"E, 168.93' (S66°27'E, 170')
1092 S65°28'55"E, 149.59' (S77°31'E, 153')
1093 S85°01'28"E, 119.27' (S74°43'E, 167')
1094 S54°37'40"E, 133.74' (S53°28'E, 101') (Ascending inlet stream, Crawfish Lake)
1095 S74°54'18"E, 69.62' (S50°37'E, 87')
1096 S32°18'48"E, 57.90' (N83°40'E, 72')
1097 N42°46'56"E, 118.27' (N70°14'E, 68')
1098 N74°19'25"E, 122.95' (S83°46'E, 111')
1099 S66°56'32"E, 129.84' (S78°05'E, 111')
1100 S69°54'09"E, 98.28' (S66°07'E, 77')
1101 S28°12'23"E, 142.81' (S40°36'E, 111')
1102 S40°35'27"E, 93.01' (S31°44'E, 114')
1103 S13°30'32"E, 100.26' (S34°00'E, 100')
1104 S59°22'31"E, 88.09' (S64°22'E, 83')

1105 A point in the inlet stream at the intersection of an unnamed stream. Set a 5/8"x 30" iron pin with a yellow plastic cap stamped: PLS 848

From which: A Spruce, 14" dia., bears S08°15'E, 48.5 ft.
A Spruce, 16" dia., bears S77°15'W, 26.6 ft.
BT's scribed NFJDW NO 1105 BT.
A 2-1/2"x30" aluminum monument with 3" aluminum cap bears S80°36'E, 45.6 ft., stamped:

NORTH FORK
JOHN DAY
WILDERNESS
NO. 1105
1992
PLS 848

Placed steel fence post with Wilderness Boundary sign 20' Easterly on line.

A PORTION OF "NORTH FORK JOHN DAY WILDERNESS SURVEY" "BALDY CREEK UNIT"

Courses between points 1105 and 1, shown below, are Grant Boundary adjusted based on record courses shown in parenthesis.

1105 S80°35'34"E, 69.88' (S83°29'E, 70')
1106 N88°48'26"E, 111.81' (N85°55'E, 112')
1107 N59°42'26"E, 185.68' (N56°49'E, 186') (Ascending northeasterly)
1108 N56°49'26"E, 213.63' (N53°56'E, 214')
1109 N46°41'26"E, 268.54' (N43°48'E, 269')
1110 N47°01'26"E, 184.69' (N44°08'E, 185')

1111 Set a 2-1/2"x30" aluminum monument with 3" aluminum cap stamped:
NORTH FORK
JOHN DAY
WILDERNESS
NO. 1111
1992
PLS 848

From which: A Lodge Pole Pine, 10" dia., bears N44°15'W, 11.2 ft.
A Spruce, 12" dia., bears N88°30'E, 25.5 ft.
BT's scribed NFJDW NO 1111 BT.

Placed steel fence post with Wilderness Boundary sign 5' Westerly on line.

N46°39'26"E, 197.66' (N43°46'E, 198')
1112 N59°03'26"E, 215.63' (N56°10'E, 216')
1113 N66°08'26"E, 137.77' (N63°15'E, 138')
1114 N69°47'26"E, 162.73' (N66°54'E, 163') (Ascending northeasterly)
1115 N56°45'26"E, 292.50' (N53°52'E, 293')
1116 N57°40'26"E, 332.43' (N54°47'E, 333')
1117 N52°01'26"E, 450.23' (N49°08'E, 451')

1118 Set a 2-1/2"x30" aluminum monument with 3" aluminum cap stamped:
North Fork

NORTH FORK
JOHN DAY
WILDERNESS
NO. 1118
1992
PLS 848

From which: A Lodge Pole Pine, 14" dia., bears S17°15'E, 76.3 ft.
A Spruce, 16" dia., bears N68°30'W, 29.2 ft.
BT's scribed NFJDW NO 1118 BT.

Placed steel fence post with Wilderness Boundary sign Northerly on line.

N47°01'26"E, 372.37' (N44°08'E, 373')
1119 N38°50'26"E, 435.26' (N35°57'E, 436')
1120 N37°46'26"E, 562.04' (N34°53'E, 563') (Ascending northeasterly)
1121 N37°29'26"E, 434.26' (N34°36'E, 435')
1122 N20°43'26"E, 267.54' (N17°50'E, 268')
1123 N23°17'34"E, 128.81' (N20°24'E, 129')


1 A high point on the crest of the Elkhorn Range, identified as 'The Lakes Lookout,' elevation 8522 feet.
Set a 2-1/2"x30" aluminum monument with 3" aluminum cap stamped:

NORTH FORK
JOHN DAY
WILDERNESS
NO. 1
1992
PLS 848

From which: A 5/8" x 30" iron pin bears N14°15'E, 17.8 ft.
A 5/8" x 30" iron pin bears N80°30'E, 9.6 ft.
Pins capped with yellow plastic cap stamped PLS 848

Placed steel fence post with Wilderness Boundary sign 2' Westerly on line.

Ferguson Surveying

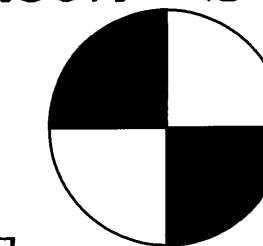


Engineering

MT. VERNON, OREGON
PHONE (503)932-4520
FAX (503)932-4430

MAGNETIC DECLINATION 20° EAAST

Scale: 1"=200'

Basis of Bearing: Solar Observation

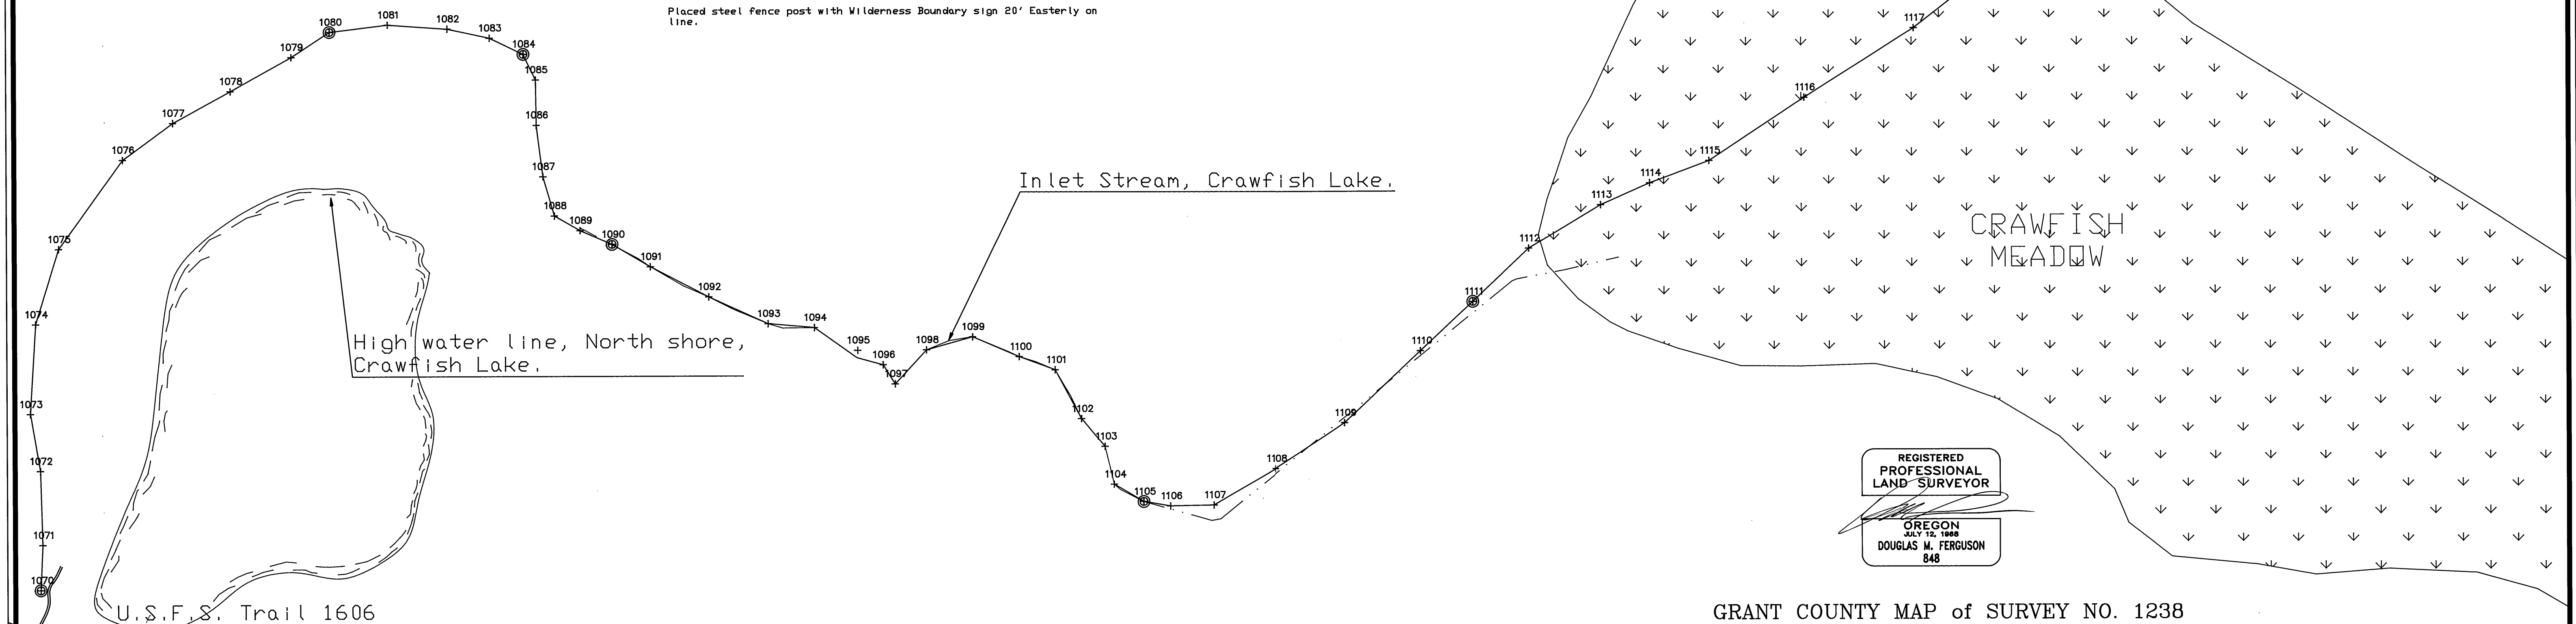

REGISTERED
PROFESSIONAL
LAND SURVEYOR
OREGON
JULY 12, 1988
DOUGLAS M. FERGUSON
848

GRANT COUNTY MAP of SURVEY NO. 1238