

NORTH FORK JOHN DAY WILDERNESS, BALDY CREEK UNIT
(CRAWFISH LAKE)

Legal Description points adjusted to the top of the
Divide Ridge as tied in the field. Courses shown in
parenthesis are from original legal description.

251
A point at intersection of the summit ridge of the
Elkhorn Range and the divide ridge between the North Fork
John Day River and Cracker Creek drainages, approximate elevation
7,780 feet. Set a 2-1/2" x 30" aluminum monument with 3" aluminum
cap stamped:

NORTH FORK
JOHN DAY
WILDERNESS
NO 251
1992
PLS 848

From which: An Alpine Fir, 8" dia., bears S45°30'E, 43.0 ft.
An Alpine Fir, 8" dia., bears S10°15'E, 64.0 ft.
BT's scribed NFJDW NO 251 BT

Placed a steel fence post with Wilderness Boundary sign Southerly on
the ridge top.

S 46 33 02 W, 82.00 (S33°07'W, 82)
252 S 46 33 02 W, 106.00 (S37°18'W, 106)
253 S 46 33 10 W, 96.54 (S59°02'W, 134)
254 S 42 26 30 W, 214.50 (S45°00'W, 177)
255 S 42 26 34 W, 168.00 (S28°24'W, 168) (Southerly along said divide ridge)
256 S 42 26 43 W, 65.83 (S25°54'W, 117)
257 S 37 20 30 W, 161.28 (S29°21'W, 110)
258 S 37 20 34 W, 121.00 (S33°34'W, 121)
259 S 37 20 40 W, 190.89 (S38°43'W, 142)
260 S 6 40 45 W, 92.75 (S30°19'W, 137)
261 S 6 40 55 W, 242.47 (S06°30'W, 159)
262 S 5 17 59 W, 230.94 (S06°30'W, 253)
263 Set a 2-1/2" x 30" aluminum monument with 3" aluminum cap stamped:

NORTH FORK
JOHN DAY
WILDERNESS
NO 263
1992
PLS 848

From which: A Spruce, 14" dia., bears S33°45'E, 43.6 ft.
A Spruce, 16" dia., bears S45°15'W, 36.4 ft.
BT's scribed NFJDW NO 263 BT

Placed a steel fence post with Wilderness Boundary sign 8' Northerly on
the ridge top.

A PORTION OF "NORTH FORK JOHN DAY WILDERNESS SURVEY"
"BALDY CREEK UNIT"

263 S 00 38 30 W, 256.00 (S01°07'W, 256)
264 S 4 37 01 E, 201.97 (S01°59'W, 202)
265 S 9 56 24 E, 275.59 (S06°46'E, 238)
266 S 6 48 52 E, 168.45 (S16°20'E, 206)
267 S 6 49 33 E, 159.00 (S07°59'E, 159)
268 S 6 48 00 E, 142.00 (S26°23'E, 142)
269 S 6 48 53 E, 157.28 (S06°44'E, 111)
270 S 18 41 59 W, 101.07 (S01°12'W, 144)
271 S 18 40 26 W, 168.51 (S17°16'W, 185)
272 S 9 13 36 W, 175.68 (S12°22'W, 159) (Southerly along said divide ridge)
273 S 9 13 35 W, 80.84 (S15°53'W, 113)
274 S 00 54 39 W, 147.43 (S05°31'W, 115)
275 S 00 54 36 W, 142.00 (S11°47'E, 142)
276 S 00 54 36 W, 46.72 (S03°47'E, 166)
277 Summit of Columbia Hill, Elevation 8117 feet. Set a 2-1/2" x 30"
aluminum monument with 3" aluminum cap stamped:

NORTH FORK
JOHN DAY
WILDERNESS
NO 277
1992
PLS 848

From which: 5/8" x 30" Iron pin bears N25°15'E, 35.3 ft.
5/8" x 30" Iron pin bears S67°45'E, 13.5 ft.
Pins capped with yellow plastic cap stamped PLS 848

Placed a steel fence post with Wilderness Boundary sign 30' North-easterly on
the ridge top.

277 S 57 55 17 W, 297.77 (S62°21'W, 308)
278 S 59 17 04 W, 182.96 (S55°24'W, 298)
279 S 57 46 20 W, 419.38 (S59°56'W, 272)
280 S 68 19 45 W, 256.12 (S59°09'W, 269)
281 S 57 43 39 W, 271.30 (S61°23'W, 301) Southwesterly along the divide ridge
282 S 74 17 06 W, 247.89 (S63°11'W, 202) between the North Fork John Day River
283 S 65 21 57 W, 254.83 (S67°14'W, 189) and Fruit Creek.
284 S 50 45 32 W, 184.07 (S54°44'W, 272)
285 S 50 45 33 W, 119.86 (S49°40'W, 182)
286 S 47 12 58 W, 196.09 (S50°32'W, 88)
287 S 38 37 32 W, 40.30 (S36°28'W, 86)
288 S 39 28 15 W, 77.00 (S44°28'W, 77)
289 S 39 10 49 W, 39.13 (S74°56'W, 27)
290 Summit of unnamed peak, elevation 7836 feet.
Set a 2-1/2" x 30" aluminum monument with 3" aluminum cap stamped:

NORTH FORK
JOHN DAY
WILDERNESS
NO 290
1992
PLS 848


From which: An Alpine Fir, 10" dia., bears N24°15'E, 52.8 ft.
An Alpine Fir, 12" dia., bears S17°45'W, 84.9 ft.
BT's scribed NFJDW NO 290 BT

Placed a steel fence post with Wilderness Boundary alongside monument.

SHEET 3 OF 3

"CRACKER CREEK"

Ferguson Surveying

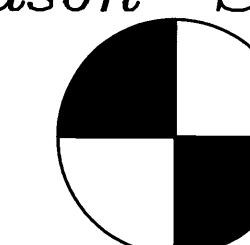

Engineering




MT. VERNON, OREGON
PHONE (503)932-4520
FAX (503)932-4430

LEGEND

○ SET MONUMENT AS DESCRIBED ABOVE

x LEGAL DESCRIPTION POINT NUMBER

MAGNETIC DECLINATION 20° EAST

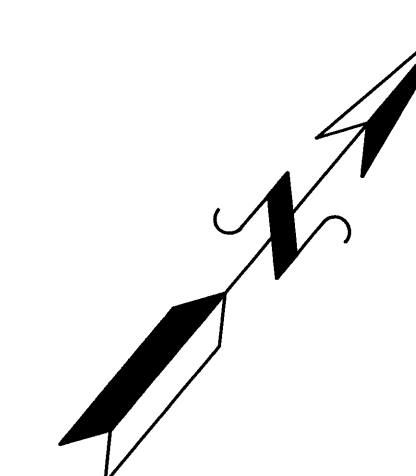

200 0 200 400 600
Scale: 1"=200'

BASIS OF BEARING: SOLAR OBSERVATION

REGISTERED
PROFESSIONAL
LAND SURVEYOR

OREGON
JULY 12, 1988
DOUGLAS M. FERGUSON
848

GRANT COUNTY MAP of SURVEY NO. 1238