
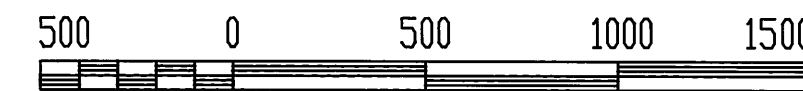


MAGNETIC DECLINATION 20° EAST


T.11S., R.35E., W.M.
SECTION 6

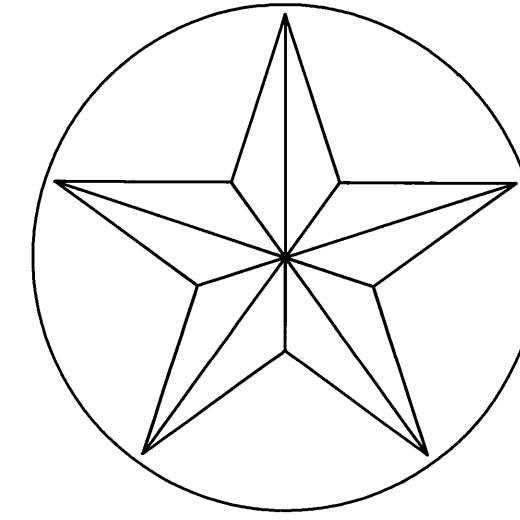






Scale: 1"=500'

Basis of Bearing: Solar Observation

Ferguson Surveying

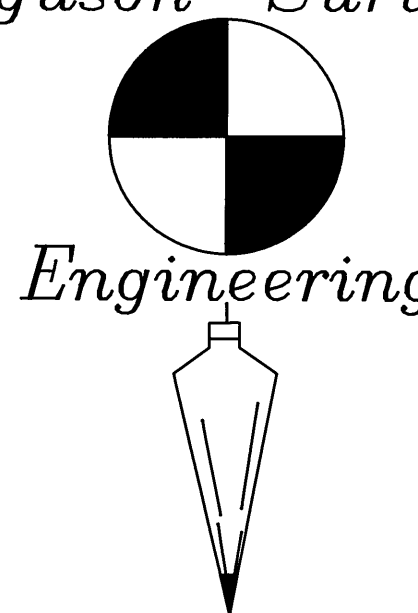

MT. VERNON, OREGON
PHONE (503)932-4520
FAX (503)932-4430

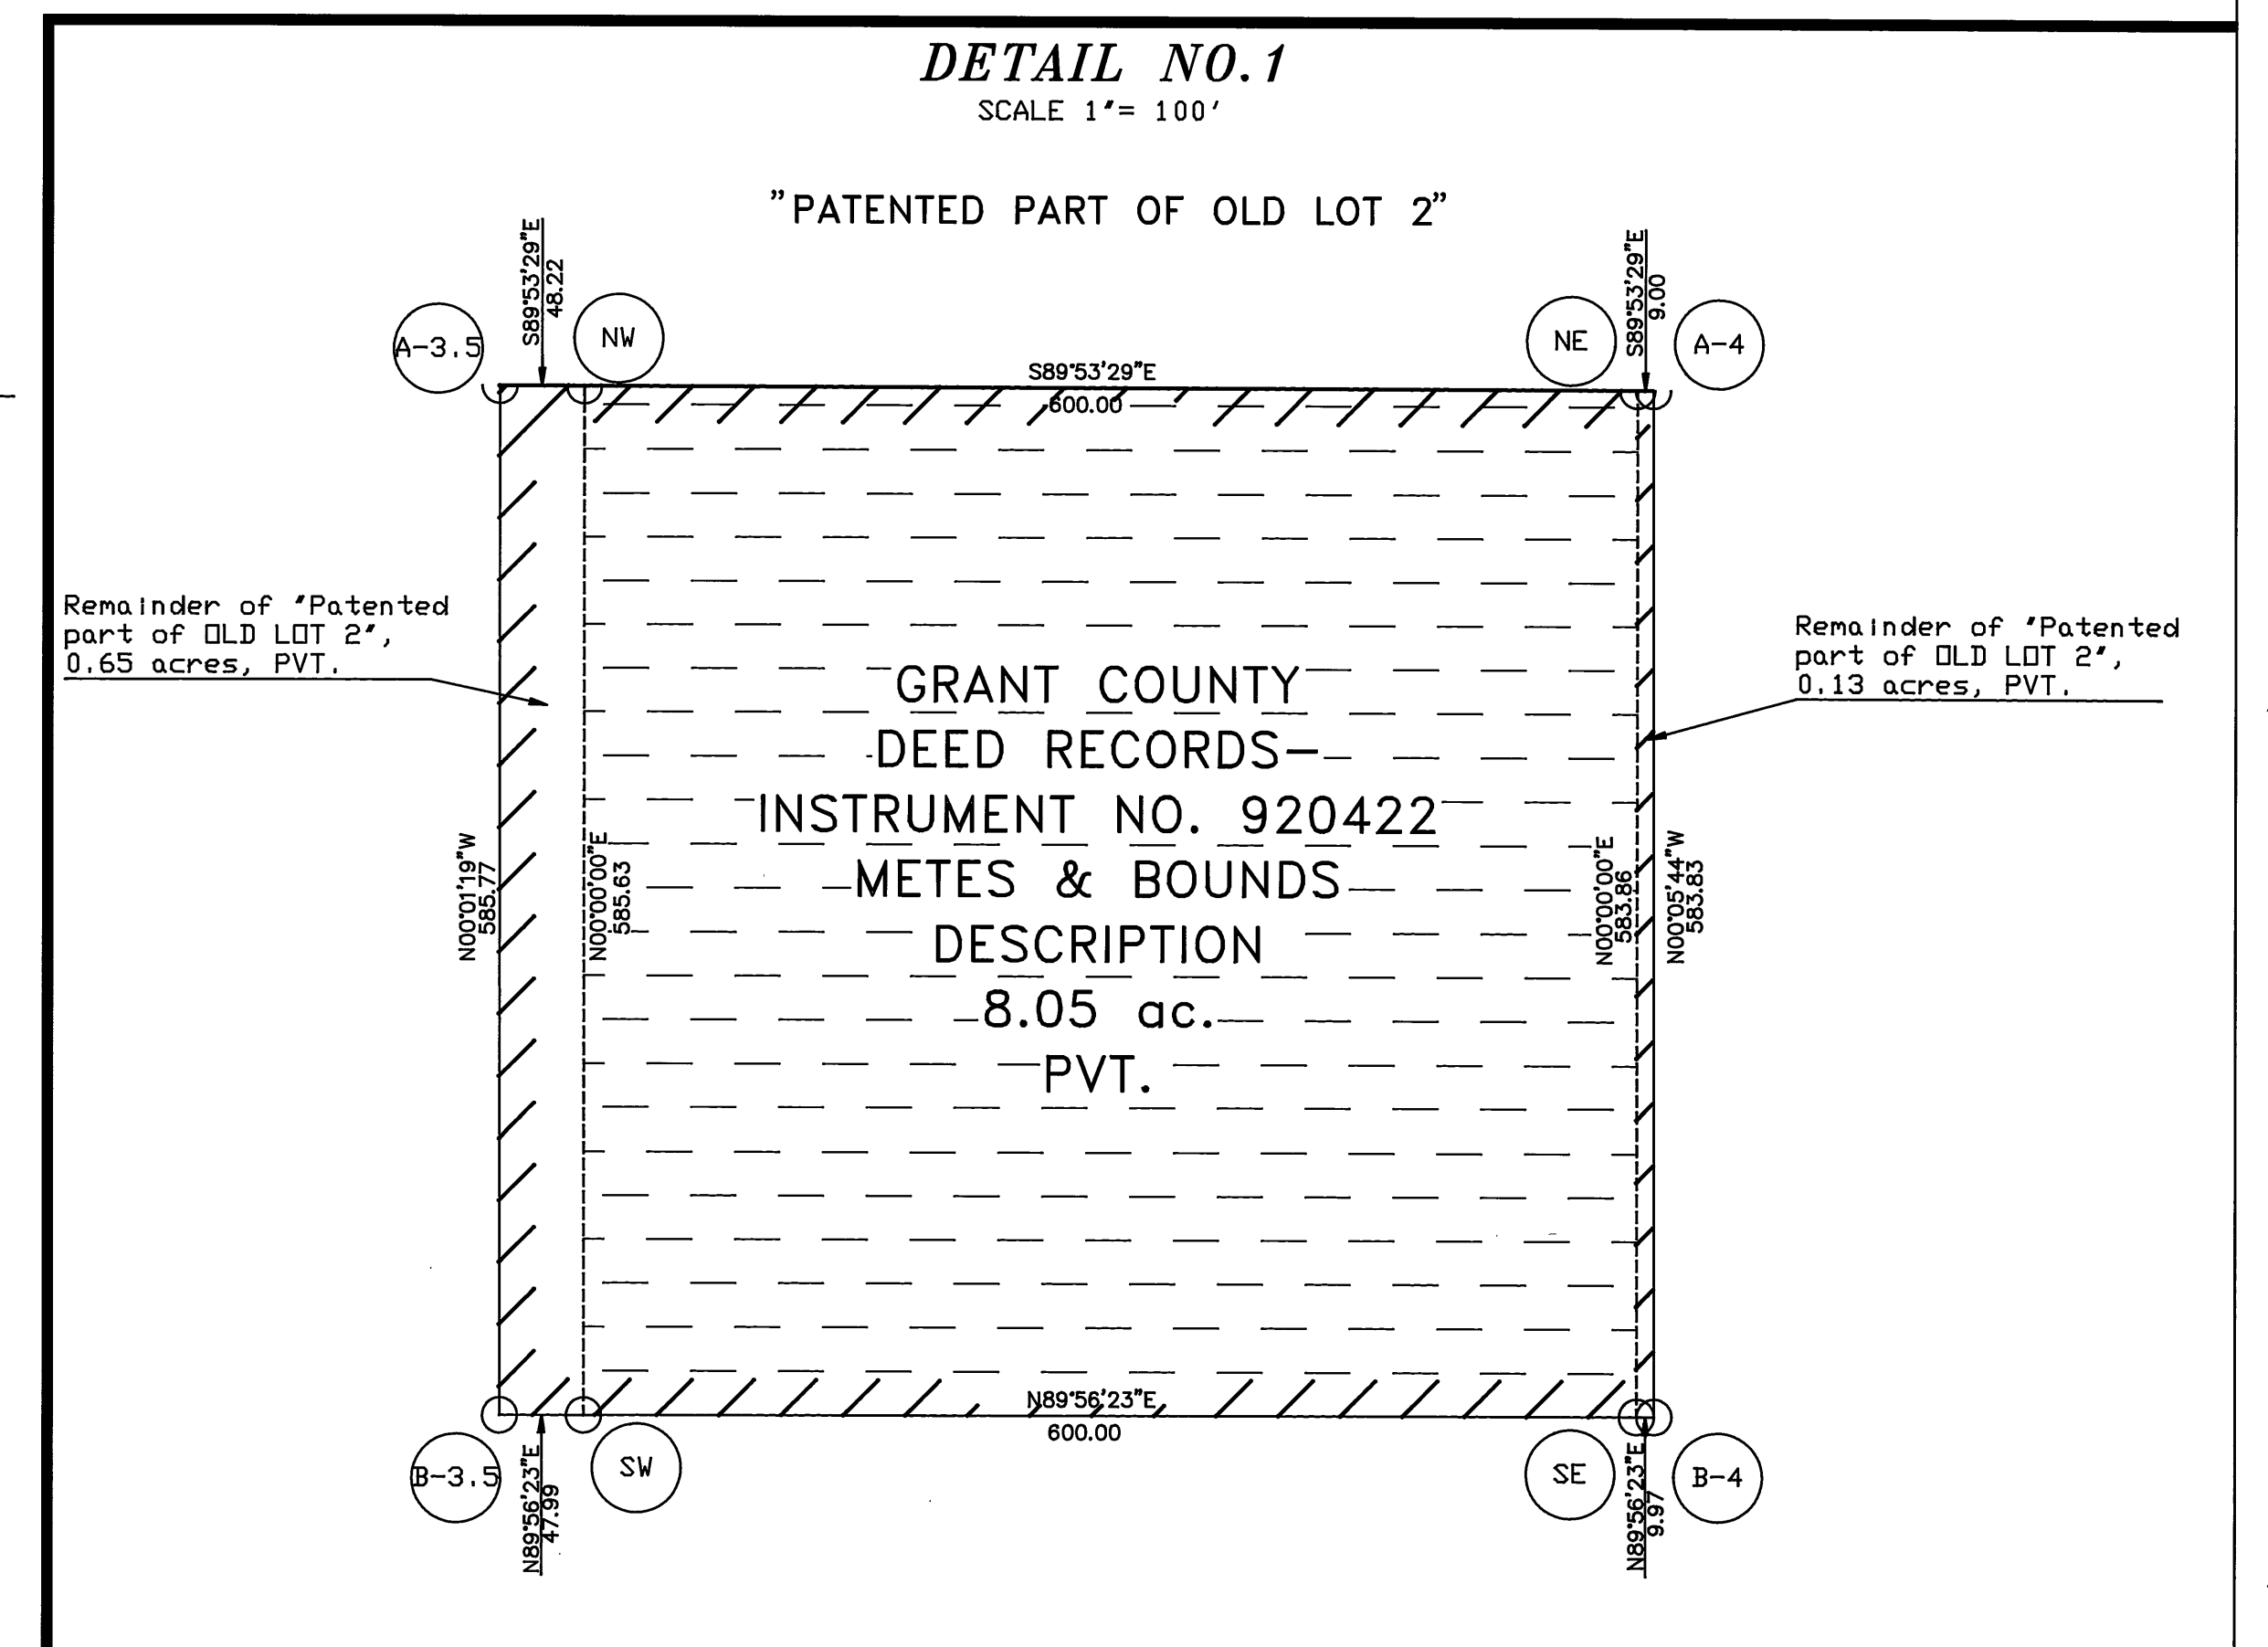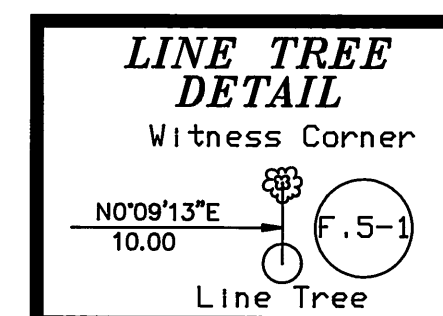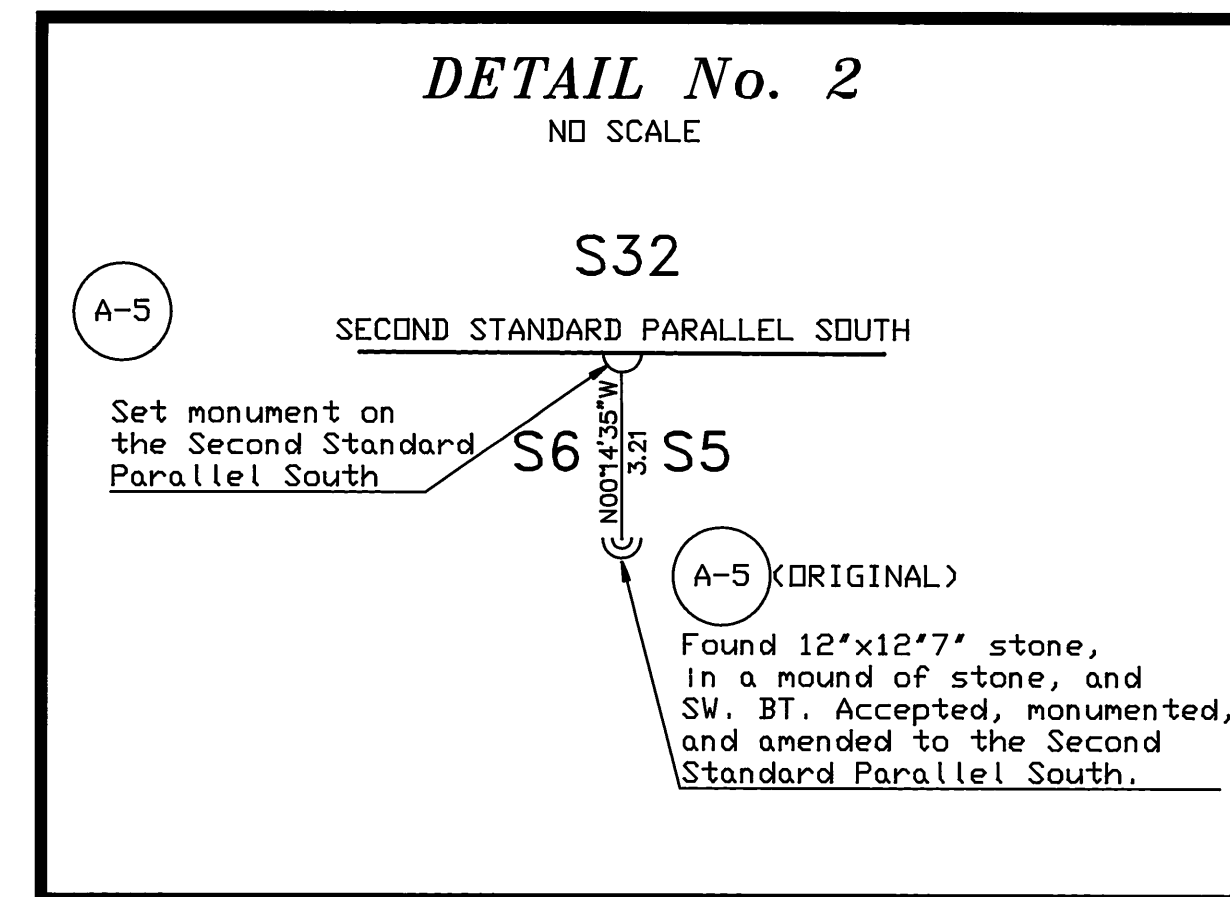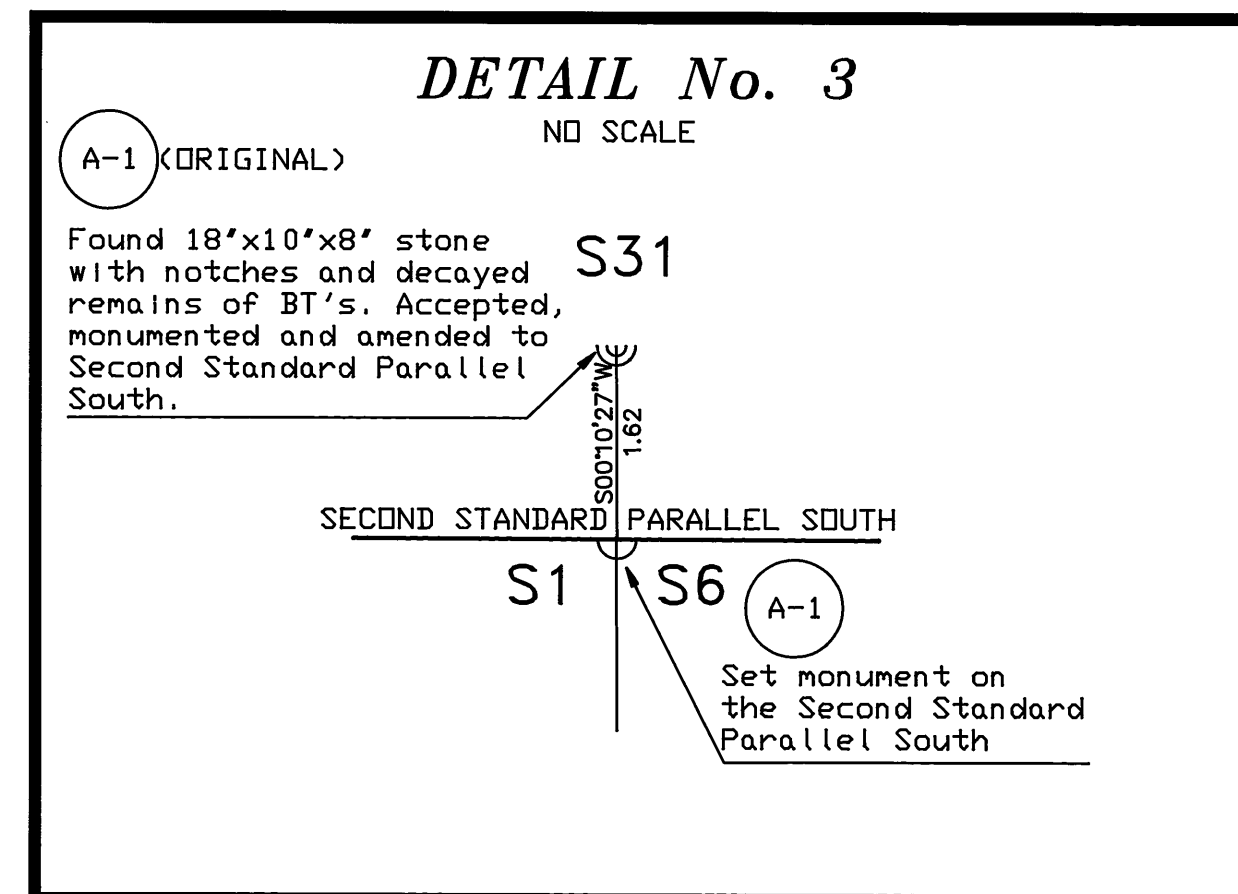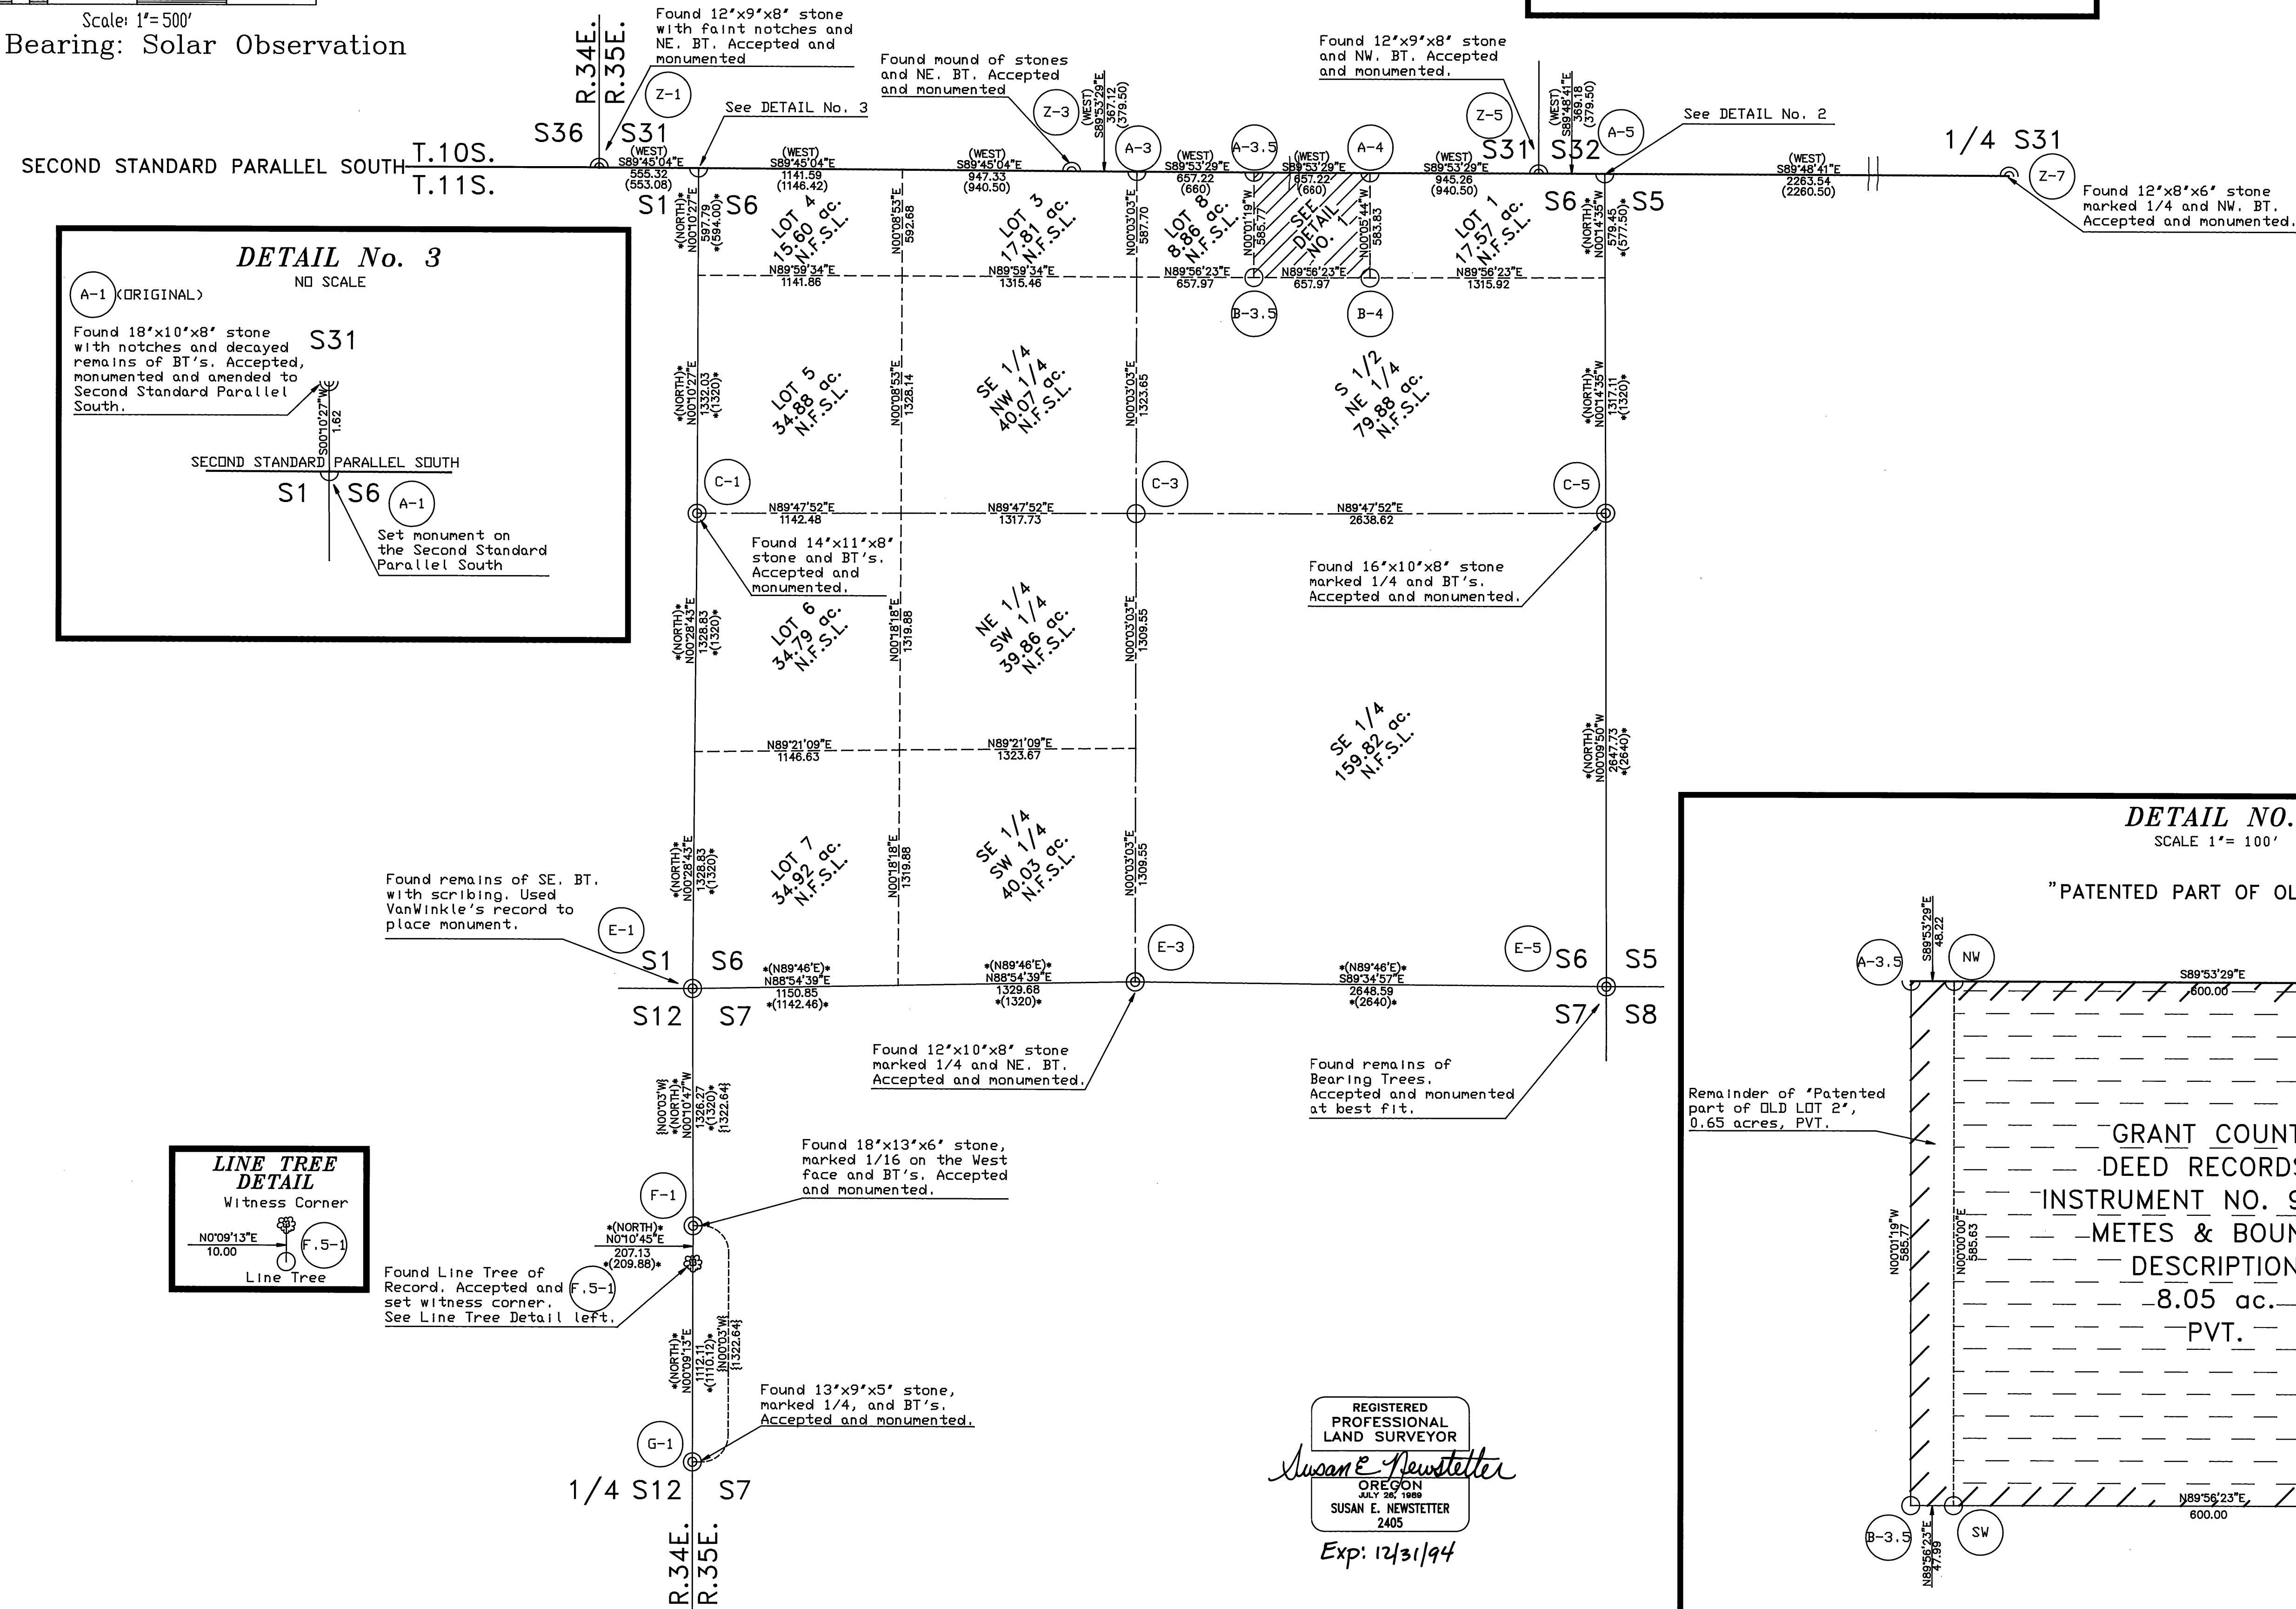

REGISTERED
PROFESSIONAL
LAND SURVEYOR
Susan E. Newstetter
OREGON
SUSAN E. NEWSTETTER
2405
Exp: 12/31/94