

MONUMENTATION

SHEET 3 OF 3

See standard U.S.F.S. "INDEX No." in the circle on the map. Monuments are stamped as shown below. On each Bearing tree, nailed a brass washer stamped "PLS 2405" blaze above the BT scribe and nailed warning signs on the back. Set steel posts with warning and boundary signs, on line within 5 ft. of property corners, or a single post with a warning sign within 5 ft. of controlling corners.

See "CERTIFIED RECORD OF LAND CORNER MONUMENTATION" forms on file in the office of the Grant County Surveyor for a complete history, description of evidence found, monument set and accessories established at all corners set.

Z-1 SC
T10S
R34E R35E
S36 S31
1992
PLS 2405

Ponderosa Pine, 30' dia., bears N50°30'W, 55.8 ft., scribed: T10S R34E S36 SC BT
Ponderosa Pine, 12' dia., bears N10°45'W, 63.3 ft., scribed: T10S R34E S36 SC BT
Ponderosa Pine, 10' dia., bears N20°15'E, 59.9 ft., scribed: T10S R35E S31 SC BT
Ponderosa Pine, 12' dia., bears N42°45'E, 24.0 ft., scribed: T10S R35E S31 SC BT

A-4 T10S R35E
E1/16 S6
T11S R35E
1992
PLS 2405

White Fir, 10' dia., bears S68°45'E, 24.1 ft., scribed: E1/16 S6 CC BT
Douglas Fir, 10' dia., bears S15°30'W, 15.4 ft., scribed: E1/16 S6 CC BT

E-1 T11S
R34E R35E
S1 S6
S12 S7
1992
PLS 2405

Western Larch, 12' dia., bears N29°58'W, 8.5 ft., scribed: T11S R34E S1 BT
Ponderosa Pine, 14' dia., bears N23°40'E, 21.4 ft., scribed: T11S R35E S6 BT
Douglas Fir, 12' dia., bears S08°31'E, 28.2 ft., scribed: T11S R35E S7 BT
Douglas Fir, 12' dia., bears S42°06'W, 28.2 ft., scribed: T11S R34E S12 BT

Z-3 SC
T10S R35E
1/4 S31
1992
PLS 2405

Ponderosa Pine, 10' dia., bears N50°30'W, 33.7 ft., scribed: 1/4 S31 SC BT
Ponderosa Pine, 14' dia., bears N04°45'W, 36.9 ft., scribed: 1/4 S31 SC BT
Ponderosa Pine, 12' dia., bears N31°45'E, 47.7 ft., scribed: 1/4 S31 SC BT

A-5 AM
T10S R35E
S32
S6 S5
T11S R35E
CC
1992
PLS 2405

No bearing trees were taken to this monument. The monument I placed on the Second Standard Parallel South bears, N00°04'35'W, 3.20 ft.

E-3 T11S R35E
S 6
1/4 S 7
1992
PLS 2405

White Fir, 14' dia., bears N81°30'W, 25.2 ft., scribed: 1/4 S6 BT
White Fir, 14' dia., bears S43°45'E, 44.8 ft., scribed: 1/4 S7 BT
White Fir, 14' dia., bears S38°45'W, 10.6 ft., scribed: 1/4 S7 BT

Z-5 SC
T10S R35E
S31 S32
1992
PLS 2405

Ponderosa Pine, 12' dia., bears N89°45'W, 89.9 ft., scribed: T10S R35E S31 SC BT
Ponderosa Pine, 8' dia., bears N05°30'E, 21.3 ft., scribed: T10S R35E S32 SC BT
Ponderosa Pine, 10' dia., bears N42°15'E, 31.7 ft., scribed: T10S R35E S32 SC BT

A-5 T10S R35E
S32
S6 S5
T11S R35E
CC
1992
PLS 2405

Douglas Fir, 14' dia., bears S80°15'E, 30.3 ft., scribed: T11S R35E S5 CC BT
Ponderosa Pine, 20' dia., bears S65°30'E, 95.9 ft., scribed: T11S R35E S5 CC BT
Ponderosa Pine, 12' dia., bears S26°45'W, 20.5 ft., scribed: T11S R35E S6 CC BT
Ponderosa Pine, 12' dia., bears S56°30'W, 25.0 ft., scribed: T11S R35E S6 CC BT

E-5 T11S R35E
S6 S5
S7 S8
1992
PLS 2405

Ponderosa Pine, 12' dia., bears N52°45'W, 24.6 ft., scribed: T11S R35E S6 BT
Ponderosa Pine, 10' dia., bears N27°30'E, 28.5 ft., scribed: T11S R35E S5 BT
Ponderosa Pine, 14' dia., bears S67°15'E, 21.2 ft., scribed: T11S R35E S8 BT
Ponderosa Pine, 18' dia., bears S56°30'W, 25.3 ft., scribed: T11S R35E S7 BT

Z-7 SC
T10S R35E
1/4 S32
1992
PLS 2405

White Fir, 14' dia., bears N32°15'W, 30.9 ft., scribed: 1/4 S32 SC BT
Douglas Fir, 12' dia., bears N01°45'W, 37.9 ft., scribed: 1/4 S32 SC BT
Douglas Fir, 14' dia., bears N24°30'E, 43.0 ft., scribed: 1/4 S32 SC BT
Douglas Fir, 26' dia., bears N87°15'E, 15.3 ft., scribed: 1/4 S32 SC BT

B-3 T11S R35E
C-W-NE 1/64
S6
1992
PLS 2405

Douglas Fir, 14' dia., bears S74°45'W, 23.1 ft., scribed: C-W-NE 1/64 S6 BT
Ponderosa Pine, 20' dia., bears N30°45'E, 17.5 ft., scribed: C-W-NE 1/64 S6 BT

F-1 T11S
R34E R35E
N 1/16
S12 S7
1992
PLS 2405

Douglas Fir, 12' dia., bears N48°15'W, 65.2 ft., scribed: N 1/16 S12 BT

A-1 AM
T10S R35E
S31
S1 S6
R34E R35E
T11S
CC
1992
PLS 2405

No bearing trees were taken to this monument. The monument I placed on the Second Standard Parallel South bears S00°10'27'W, 1.62 ft.

SW
T11S R35E
SW
Corner
Metes/
Bounds
1992
PLS 2405

As references set 5/8" x 30' rebars with yellow plastic caps marked PLS 2405, 28' in the ground, which bear as follows:
N45°W, 8.6 ft.
N45°E, 8.7 ft.

F-5-1 WC
T11S
(Line Tree)
Line Tree
R34E R35E
S12 S7
1992
PLS 2405

Ponderosa Pine, 14' dia., bears S89°15'W, 20.0 ft., scribed: LT S12 BT
Ponderosa Pine, 12' dia., bears S39°45'E, 17.2 ft., scribed: LT S7 BT

A-1 T10S R35E
S31
S1 S6
R34E R35E
T11S
CC
1992
PLS 2405

Douglas Fir, 12' dia., bears S70°15'E, 52.7 ft., scribed: T11S R35E S6 CC BT
Douglas Fir, 6' dia., bears S24°45'E, 28.7 ft., scribed: X BT
Ponderosa Pine, 12' dia., bears S02°30'W, 46.9 ft., scribed: T11S R34E S1 CC BT
Ponderosa Pine, 10' dia., bears S34°15'W, 49.3 ft., scribed: T11S R34E S1 CC BT

SE
T11S R35E
SE
Corner
Metes/
Bounds
1992
PLS 2405

As references set 5/8" x 30' rebars with yellow plastic caps marked PLS 2405, 28' in the ground, which bear as follows:
N45°W, 10.5 ft.
N45°E, 9.7 ft.

G-1 T11S
R34E R35E
1/4
S12 S7
1992
PLS 2405

Douglas Fir, 16' dia., S80°45'W, 29.9 ft., scribed: 1/4 S12 BT
Ponderosa Pine, 16' dia., S62°15'E, 48.1 ft., scribed: 1/4 S 7 BT

A-3 T10S R35E
1/4 S6
T11S R35E
1992
PLS 2405

Ponderosa Pine, 18' dia., bears S70°15'E, 16.8 ft., scribed: 1/4 S6 CC BT
Ponderosa Pine, 10' dia., bears S12°30'E, 59.9 ft., scribed: 1/4 S6 CC BT
Ponderosa Pine, 26' dia., bears S28°45'W, 53.2 ft., scribed: 1/4 S6 CC BT
Ponderosa Pine, 26' dia., bears S70°15'W, 16.5 ft., scribed: 1/4 S6 CC BT

B-4 T11S R35E
NE 1/16
S6
1992
PLS 2405

Ponderosa Pine, 12' dia., bears N77°45'E, 17.9 ft., scribed: NE 1/16 S6 BT
Ponderosa Pine, 12' dia., bears S75°15'W, 33.2 ft., scribed: NE 1/16 S6 BT

A-3-5 T10S R35E
W-E 1/64 S6
T11S R35E
1992
PLS 2405

Ponderosa Pine, 8' dia., bears S09°30'E, 26.3 ft., scribed: W-E 1/64 S6 CC BT
Ponderosa Pine, 12' dia., bears S77°15'W, 22.2 ft., scribed: W-E 1/64 S6 CC BT

C-1 T11S
R34E R35E
1/4
S1 S6
1992
PLS 2405

Ponderosa Pine, 22' dia., bears N20°15'W, 23.6 ft., scribed: 1/4 S1 BT
Ponderosa Pine, 14' dia., bears N17°45'E, 22.6 ft., scribed: 1/4 S6 BT
Ponderosa Pine, 20' dia., bears S42°15'E, 9.3 ft., scribed: 1/4 S6 BT
Ponderosa Pine, 24' dia., bears S52°30'W, 29.3 ft., scribed: 1/4 S1 BT

NW
Corner
Metes/
Bounds
T10S R35E
NW
T11S R35E
1992
PLS 2405

As references set 5/8" x 30' rebars with yellow plastic caps marked PLS 2405, 28' in the ground, which bear as follows:
S45°E, 9.4 ft.
S45°W, 10.1 ft.

C-3 T11S R35E
C1/4
S 6
1992
PLS 2405

Ponderosa Pine, 10' dia., bears N67°46'W, 29.3 ft., scribed: C1/4 S6 BT
Ponderosa Pine, 10' dia., bears N65°15'E, 37.9 ft., scribed: C1/4 S6 BT
Douglas Fir, 12' dia., bears S72°45'E, 23.1 ft., scribed: C1/4 S6 BT
Douglas Fir, 12' dia., bears S60°45'W, 4.2 ft., scribed: C1/4 S6 BT


NE
Corner
Metes/
Bounds
T10S R35E
NE
T11S R35E
1992
PLS 2405

As references set 5/8" x 30' rebars with yellow plastic caps marked PLS 2405, 28' in the ground, which bear as follows:
S45°E, 10.1 ft.
S30°W, 9.7 ft.

C-5 T11S R35E
1/4
S6 S5
1992
PLS 2405

Douglas Fir, 14' dia., bears N47°15'W, 15.4 ft., scribed: 1/4 S6 BT
Douglas Fir, 12' dia., bears N34°45'E, 28.0 ft., scribed: 1/4 S5 BT
Ponderosa Pine, 11' dia., bears S64°30'E, 18.0 ft., scribed: 1/4 S5 BT
Ponderosa Pine, 10' dia., bears S41°15'W, 28.2 ft., scribed: 1/4 S6 BT

Ferguson Surveying

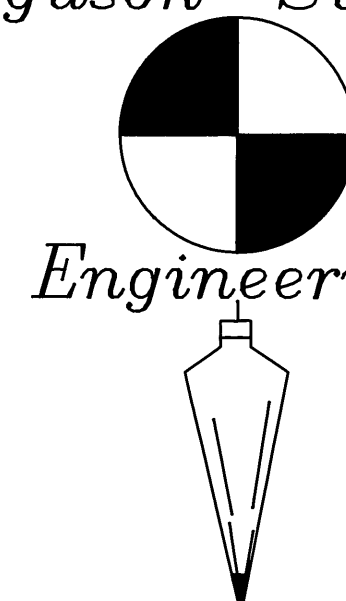

REGISTERED
PROFESSIONAL
LAND SURVEYOR
Susan E. Newstetter
OREGON
JULY 26, 1999
SUSAN E. NEWSTETTER
2405

Exp: 12/31/94

MT. VERNON, OREGON
PHONE (503)932-4520
FAX (503)932-4430