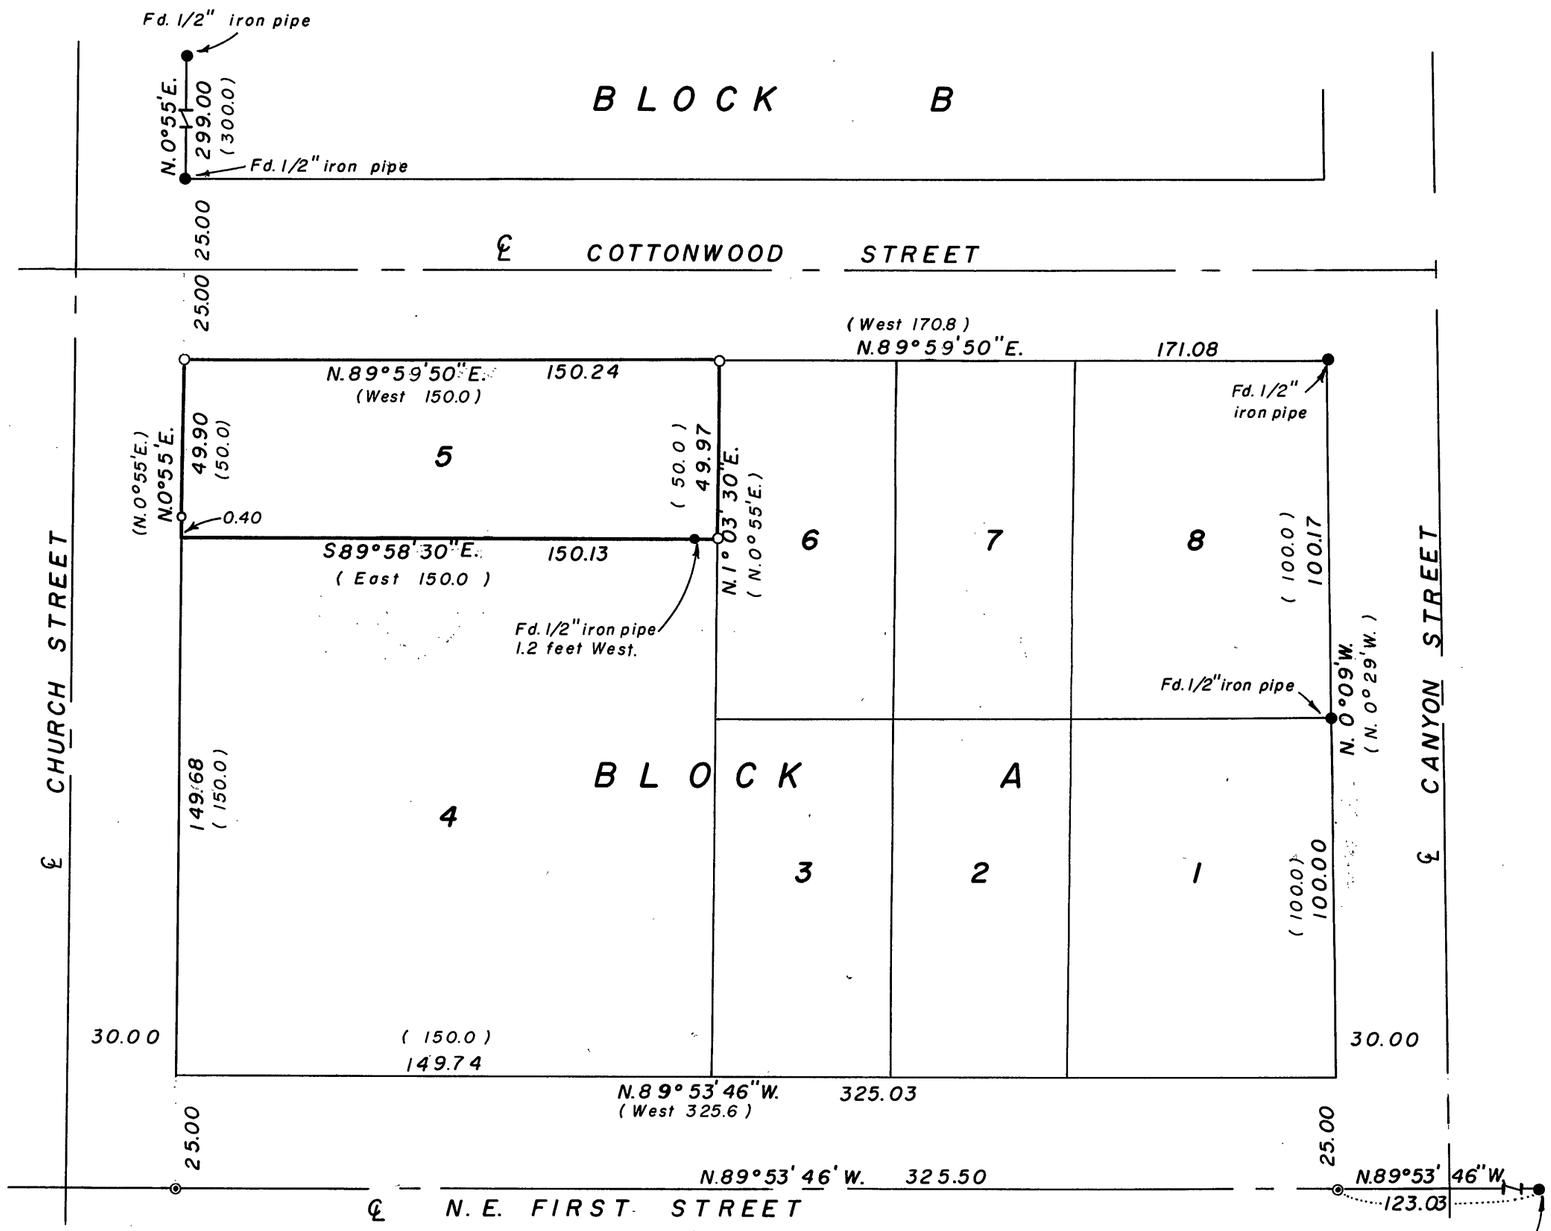

N

RECEIVED AND
FILED
OCT 1 1968
JOHN LIVEIRA, County Clerk
By _____ Deputy

Basis of Bearings

Record bearing West Bdy. this Addition.

REGISTERED
OREGON
LAND SURVEYOR
Duane I. Griffith
JULY 10, 1964
DUANE I. GRIFFITH
644

LEGEND

- ● Found monuments
- ○ Set 5/8" x 30" iron pins
- ⊙ Set 8" bridge spike
- ( ) Record bearings & distances

BAGETT & GRIFFITH SURVEYING
John Day, Oregon

Map of Survey

BLK. 'A', LOT 5, FIRST MUNICIPAL ADD.

JOHN DAY, OREGON

Surveyed for	Claude Ingram	
Surveyed by	D.I.G & R.D.B.	9/26/68
Scale: 1" = 40'	Drawn by D.I.G	9/26/68

Survey Map # 124