


TOWNSHIP 15 SOUTH, RANGE 27 EAST, OF THE WILLAMETTE MERIDIAN, OREGON

DEPENDENT RESURVEY AND SUBDIVISION OF SECTION 12

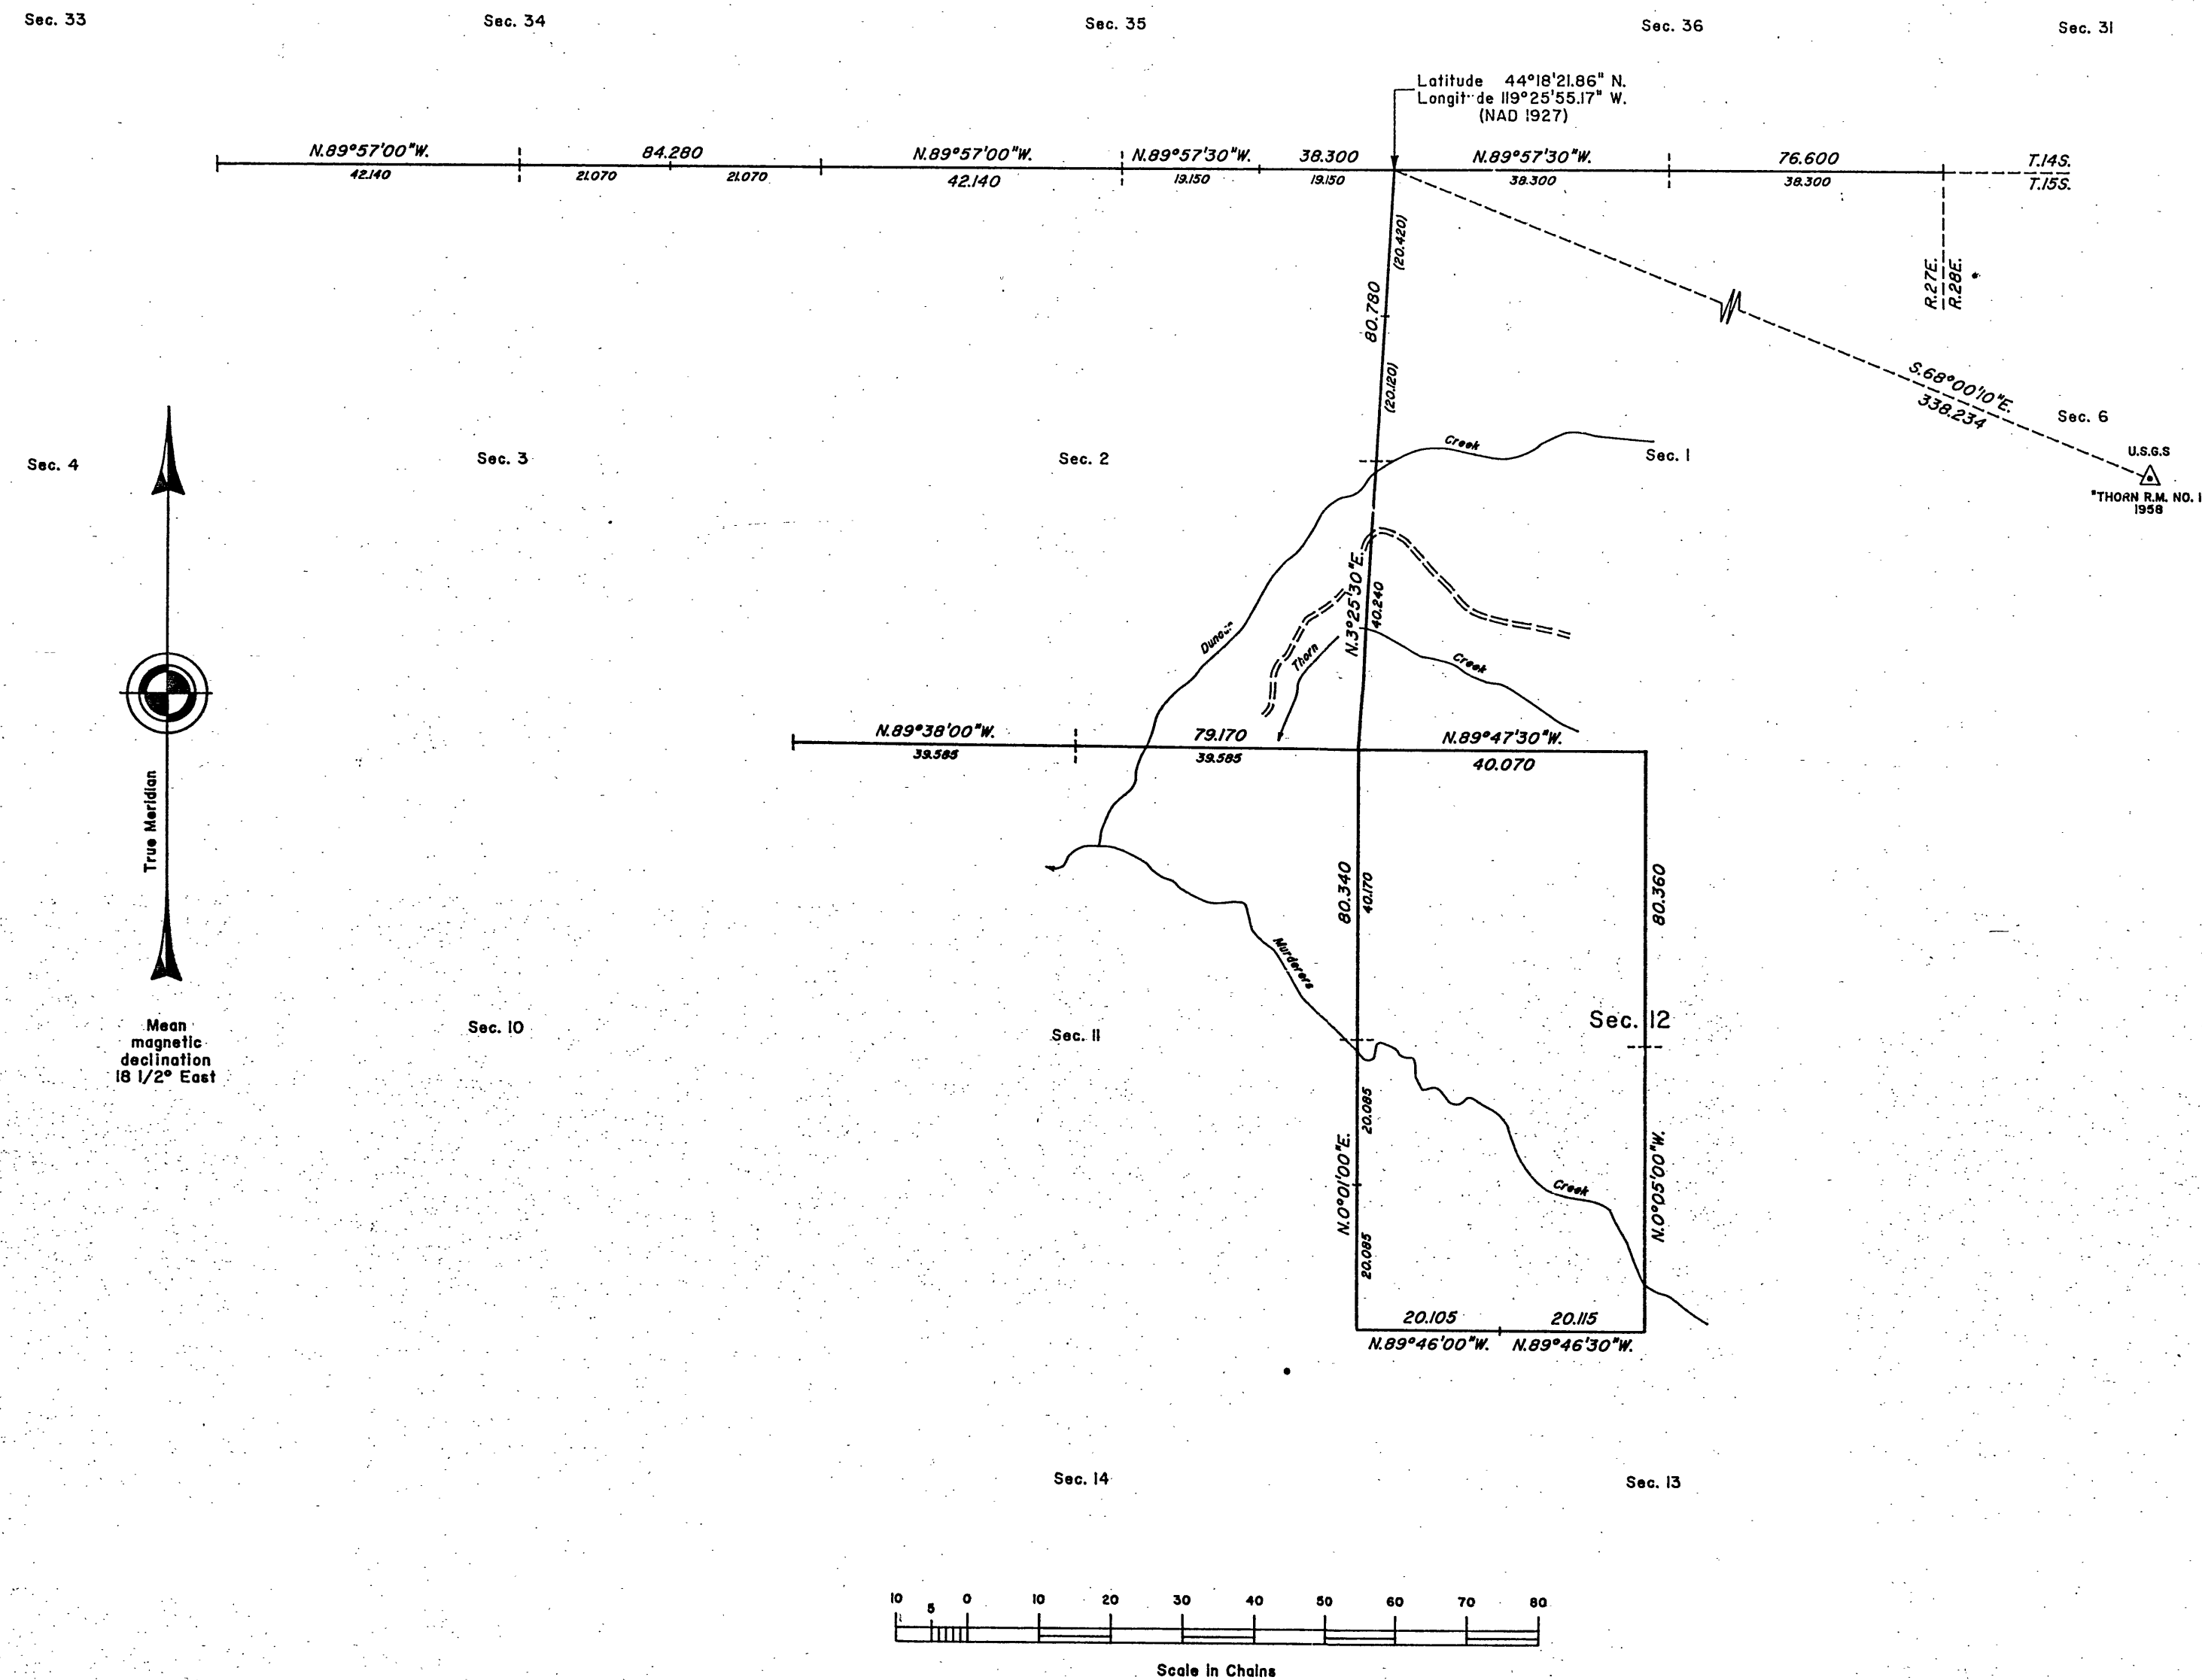

A history of surveys is contained in the field notes.

This plat represents a dependent resurvey of a portion of the north boundary and subdivision lines, T. 15 S., R. 27 E., Willamette Meridian, Oregon, designed to restore the corners in their true original locations according to the best available evidence, and the subdivision of section 12.

The survey was executed by Daniel E. Weller, Cadastral Surveyor, beginning May 1, 1991, and completed June 11, 1991, pursuant to Special Instructions dated April 15, 1991, under Group Number 1597, Oregon.

Timber in this area consists of juniper, pine and fir.

UNITED STATES DEPARTMENT OF THE INTERIOR
BUREAU OF LAND MANAGEMENT

Portland, Oregon

October 13, 1992

This plat is strictly conformable to the approved field notes, and the survey, having been correctly executed in accordance with the requirements of law and the regulations of this Bureau, is hereby accepted.

For the Director

Wayne M. Hansen
Chief Cadastral Surveyor of Oregon

RECEIVED AND
FILED

MAR 29 1993

OFFICE OF THE SURVEYOR
Attest: *[Signature]*

W.H.B.