

DRG. NO. 10B-3-15

SURVEY FOR
OREGON DEPARTMENT OF TRANSPORTATION
DIXIE SUMMIT-AUSTIN JCT. SEC.
JOHN DAY HIGHWAY
GRANT COUNTY


SHEET
No. **13**
TOTAL
SHEETS **14**

REGISTERED
PROFESSIONAL
LAND SURVEYOR
Duane N. Berg
OREGON
JULY 15, 1983
DUANE N. BERG
2043
OREGON DEPARTMENT OF TRANSPORTATION
3012 Island Avenue
La Grande, OR. 97850

POINT NO.	NORTHING	DISTANCE	EASTING	BEARING	STATION	OFFSET
11165	161575.74		276037.68		740+65.22 PS	67.38' Lt.
11167	161745.59	438.07'	276441.48	N 67°11'13" E	745+15.22 PSC	175.62' Lt.
11169	161665.42	95.10'	276492.63	S 32°32'19" E	745+45.22 PCS	84.41' Lt.
11171	161852.75	433.87'	276883.97	N 64°25'12" E	749+95.22 PT	99.69' Lt.
11173	161991.52	292.96'	277141.98	N 61°43'36" E	752+88.09 PS	106.80' Lt.
11179	163349.98	1601.06'	277989.32	N 31°57'14" E	771+25.31 PT	105.23' Lt.
11181	163912.49	562.55'	277996.06	N 00°41'11" E	776+97.58 PS	105.29' Lt.

MALHEUR NATIONAL FOREST

4°30' C.L.
TΔ 62°25'30"
Ts 1000.26'
2 - 450' Spirals
S 10°07'30"
a 1.0

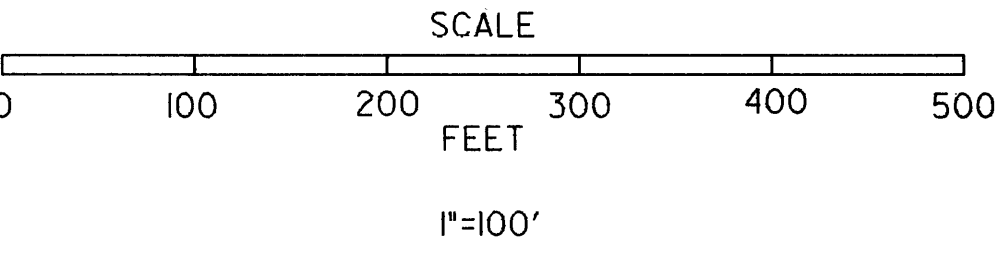

POINT NO.	NORTHING	DISTANCE	EASTING	BEARING	STATION	OFFSET
11166	161415.95		276052.45		740+65.22 PS	93.05' Rt.
11168	161498.01	465.38'	276511.91	N 80°50'53" E	745+15.22 PSC	89.49' Rt.
11170	161517.67	37.42'	276537.11	N 42°20'08" E	745+45.22 PCS	69.89' Rt.
11172	161696.71	462.06'	276963.07	N 67°12'07" E	749+95.22 PT	75.26' Rt.
11174	161849.13	293.73'	277214.16	N 58°44'27" E	752+88.09 PS	52.84' Rt.
11176	162078.52	458.99'	277611.72	N 60°00'55" E	757+38.09 PSC	55.31' Rt.
11175	162057.07	26.86'	277627.89	S 37°00'38" E	757+38.09 PSC	82.17' Rt.
11177	162873.82	998.42'	278202.14	N 35°06'39" E	766+75.31 PCS	142.00' Rt.
11178	162878.48	24.85'	278177.73	N 79°11'31" W	766+75.31 PCS	117.15' Rt.
11180	163347.83	469.47'	278167.09	N 01°17'55" W	771+25.31 PT	72.56' Rt.
11182	163910.25	562.61'	278181.86	N 01°30'16" E	776+97.58 PS	80.53' Rt.
11183	164386.15	479.24'	278238.37	N 06°46'18" E	781+97.58 PSC	97.35' Rt.