

BASIS OF BEARINGS
RECORD MAP OF SURVEY NO.1115

LEGEND

- Found 2-1/4" alum. pipe with alum. Cap.
- Set 5/8" x 30" iron pin with attached yellow plastic cap marked BGA SURVEY MARKER.
- Found monument from Recorded Survey No. Survey No. appears in the box.


REFERENCES

Deed Record Book 66 Page 515
117 984
Deed Record Instrument No. 901477
Record Map of Survey No. 1115

NARRATIVE: This survey was performed at the request of Evelyn Kimberling, the owner of the property. The purpose of this survey was to create new common boundary lines around certain improvements within the Kimberling Ranch, expanding the lines of Tax Lot No.4203, described in Deeds, Book 132, Page 577, to the lines as shown hereon.

A search was made of the available records pertaining to this survey. Field measurements were made to locate the South 1/4 Corner of Sec. 36 and the South 1/4 Corner of Sec. 35. I used George Colvin's record bearing between these monuments, as shown on Record Map of Survey No. 1115, for my basis of bearings. New monuments were set at locations approved by Mrs. Kimberling. We located the center of Forest Road No. 13 and the center of Deardorff Creek as shown hereon.

I found no unusual conditions with this survey.

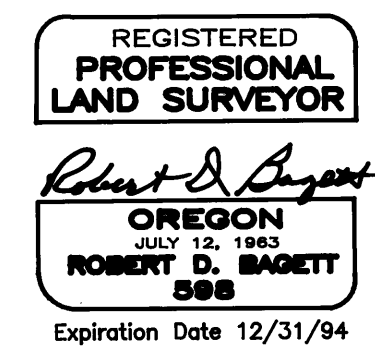

S1/4 cor. Section 36
T13S R34E
T14S R34E

RECEIVED AND
FILED

July 6, 1993
OFFICE OF COUNTY SURVEYOR
Robert D. Baggett
ATTEST: *James Russell*

BAGETT - GRIFFITH & ASSOCIATES John Day, Oregon		
MAP OF SURVEY SITUATED IN THE N1/2SW1/4 AND S1/2NW1/4 OF SECTION 36 T13S, R34E, W.M.		
GRANT COUNTY, OREGON		
SURVEYED FOR	EVELYN KIMBERLING	
SURVEYED BY	RDB & SDF & GJR	5/18/93
Scale: 1"=50'	Drawn by:	J.L.W.

RECORD MAP OF SURVEY NO.1262