


TOWNSHIP 14 SOUTH, RANGE 35 EAST, OF THE WILLAMETTE MERIDIAN, OREGON

DEPENDENT RESURVEY AND SUBDIVISION OF SECTION 27

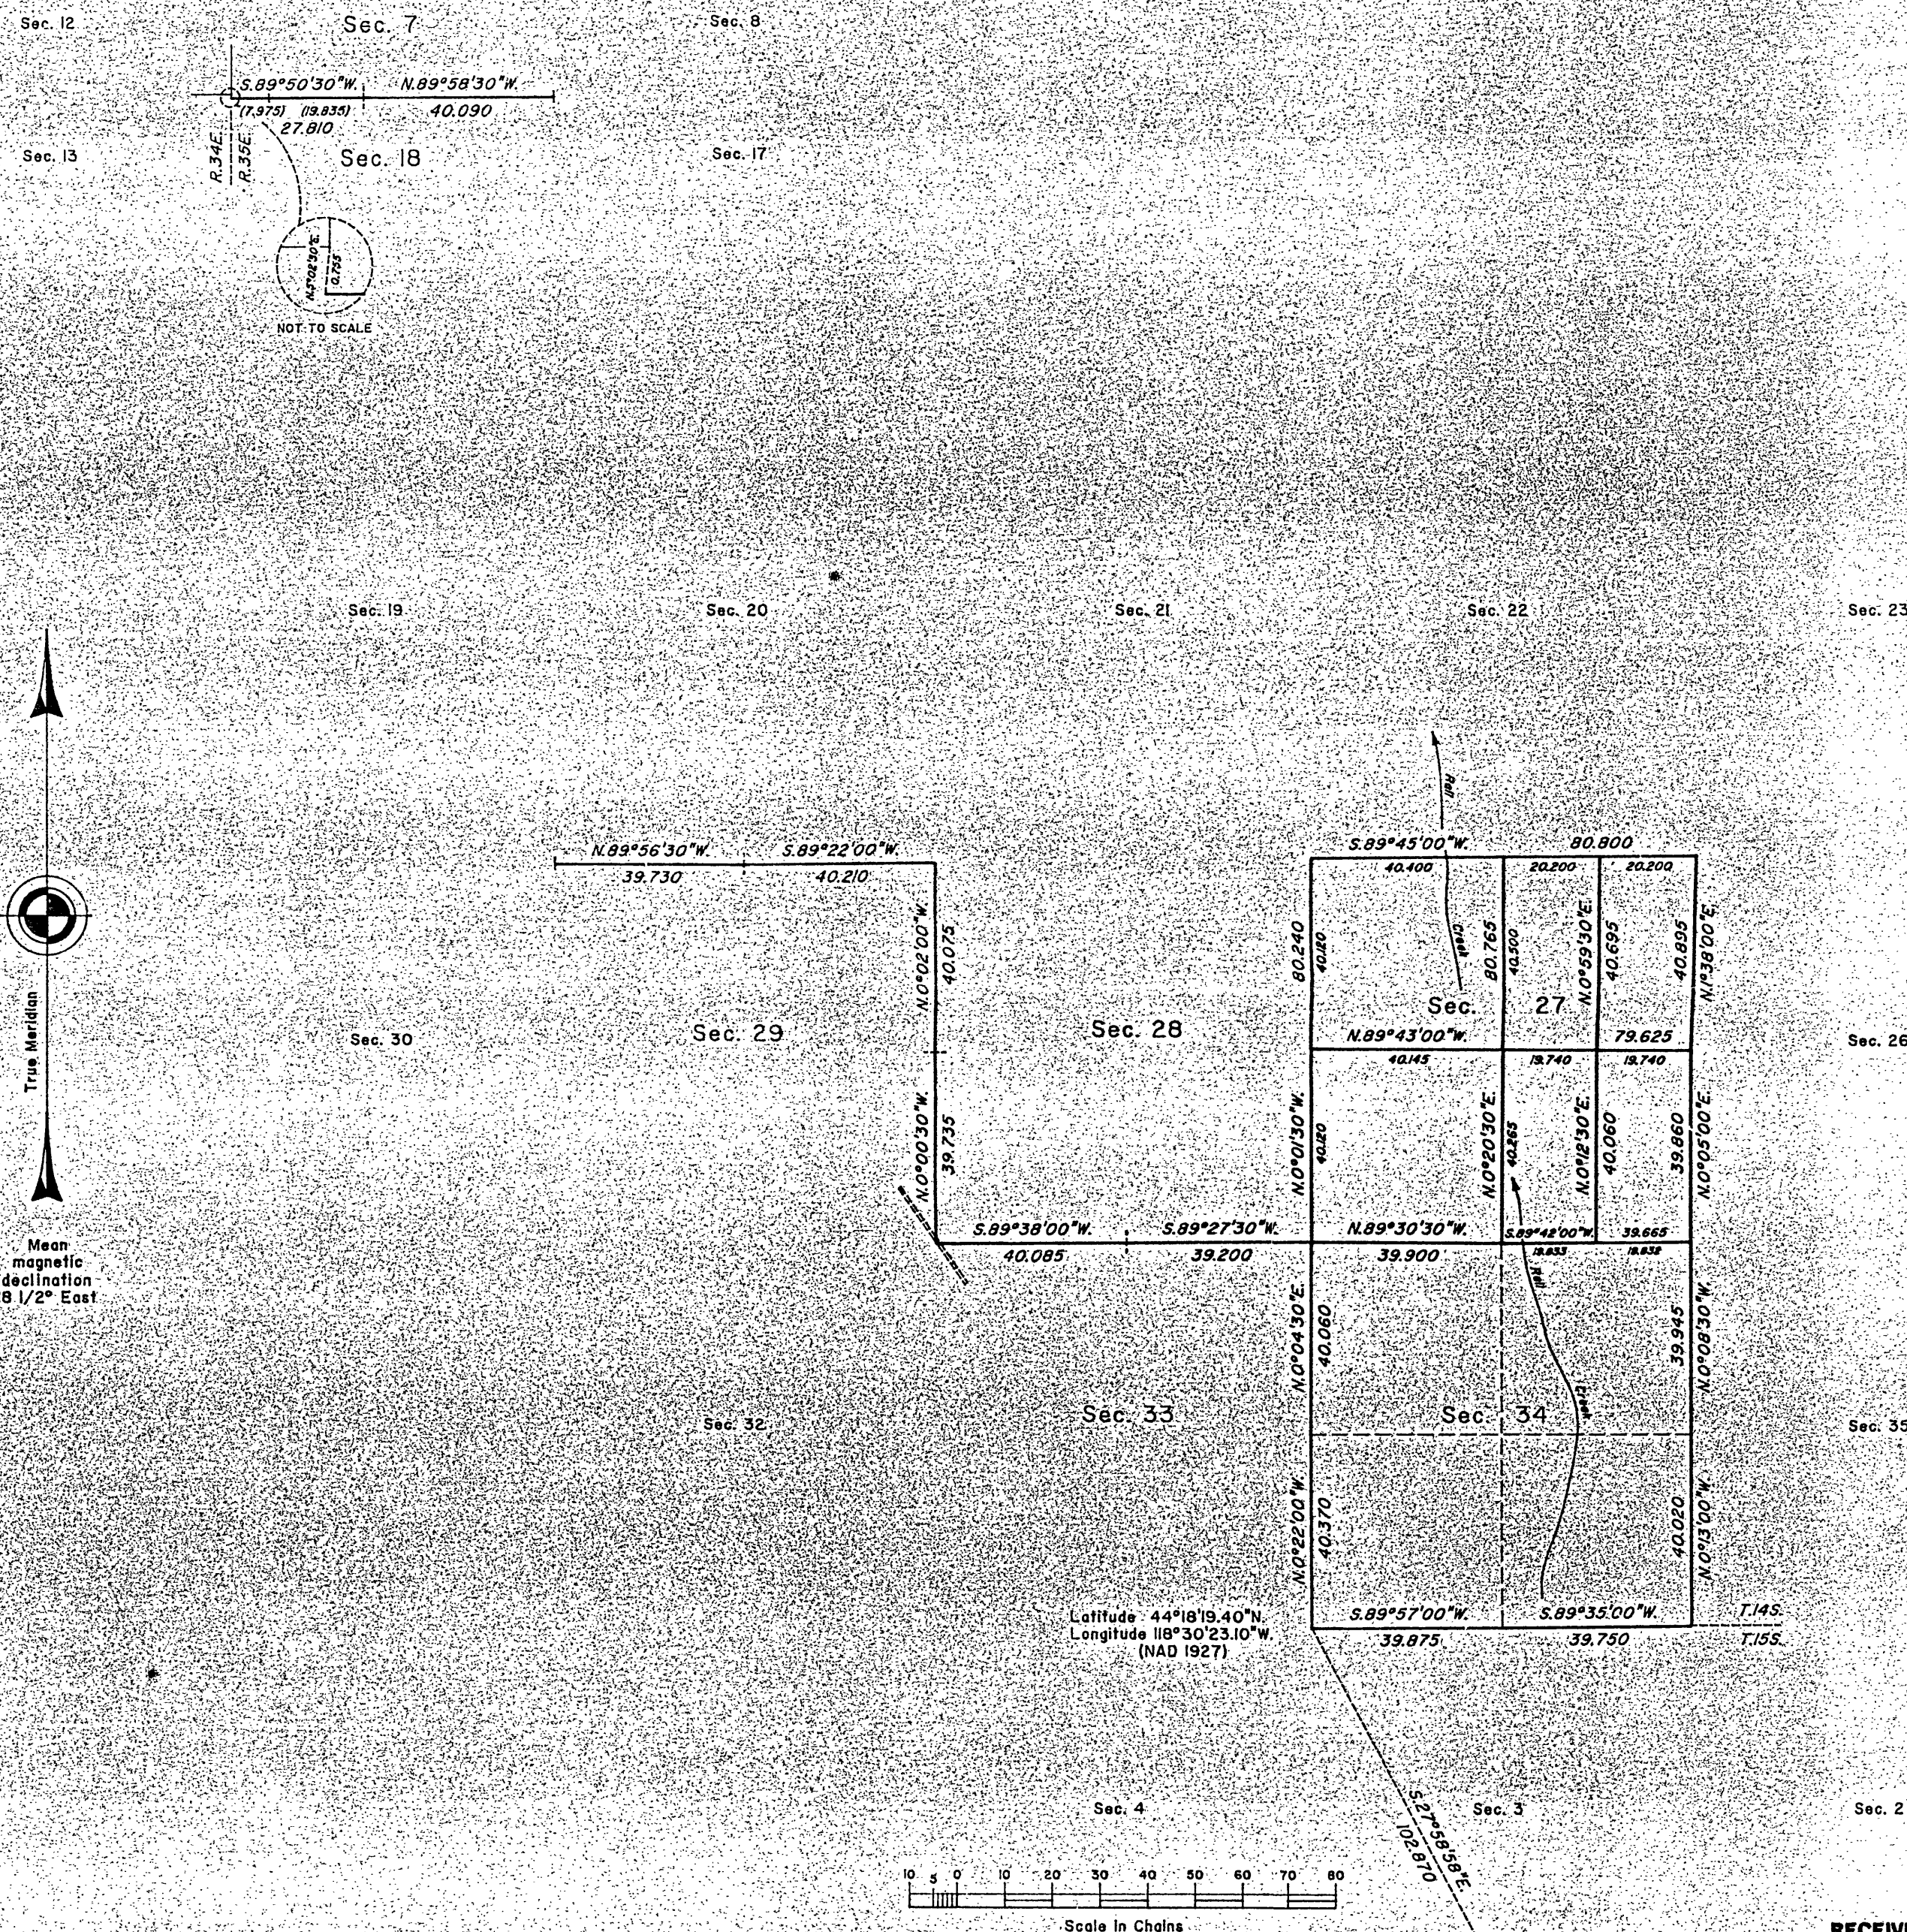

A history of surveys is contained in the field notes.

This plat represents a dependent resurvey of a portion of the south boundary and subdivisional lines, T. 14 S., R. 35 E., Willamette Meridian, Oregon, designed to restore the corners in their true original locations according to the best available evidence, and the subdivision of section 27.

Except as shown hereon, the lottings and areas are as shown on the plat approved March 28, 1902.

The survey was executed by Daniel E. Weller, Cadastral Surveyor, beginning June 12, 1991, and completed July 31, 1991, pursuant to Special Instructions dated April 16, 1991, under Group Number 1598, Oregon.

Timber in this area consists of pine, fir, larch and spruce.

Bearings and distances have been adjusted to calculate corner positions by Cadastral Measurement Management, a computer program that incorporates least squares analysis. The adjusted bearings and distances have been rounded and are reported to the nearest 30" and 0.005 chains.

UNITED STATES DEPARTMENT OF THE INTERIOR
BUREAU OF LAND MANAGEMENT

Portland, Oregon January 6, 1993

This plat is strictly conformable to the approved field notes, and the survey, having been correctly executed in accordance with the requirements of law and the regulations of this Bureau, is hereby accepted.

For the Director

Wayne M. Gardner

Chief Cadastral Surveyor of Oregon

RECEIVED AND
FILED

JUL 26 1993

OFFICE OF COUNTY SURVEYOR
Attest: *Don S. Hollenbeck*