

Searched, found no evidence.
Corner believed lost to time.
Re-established at proportionate
measure.

Found 18"x8"x6" stone,
marked R27, in a mound
of stone. Accepted and
remonumented.

Found the remains of an
original bearing tree.
Remonumented at record
bearing and distance.

Found the remains of the
original bearing trees.
Remonumented at best fit from
their records.


Found G.L.D. Brass capped
monument and accessories
as set from original
evidence in 1939.

Found G.L.D. Brass capped
monument and accessories
as set from original
evidence in 1939.

Found G.L.D. Brass capped
monument and accessories
as set from original
evidence in 1939.


MATCH LINE
SHEET 2

MAGNETIC DECLINATION 20° EAST

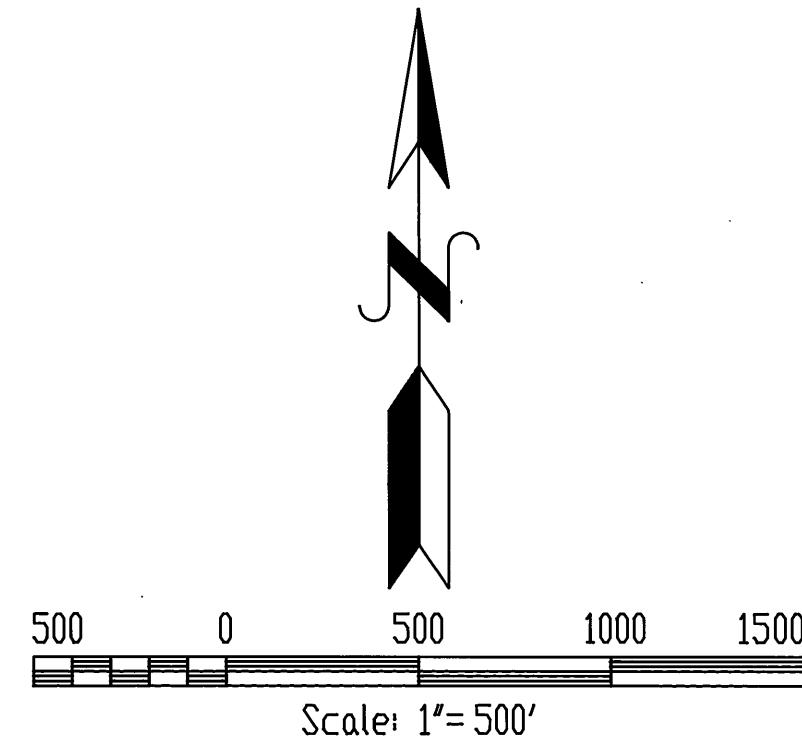

BASIS OF BEARING: Solar Observation

Ferguson Surveying

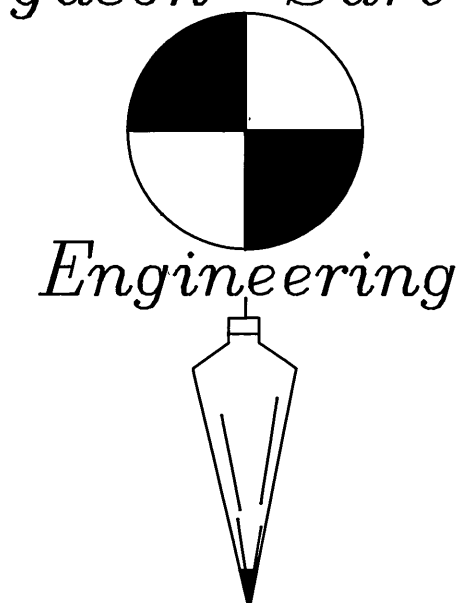

MT. VERNON, OREGON
PHONE (503)932-4520
FAX (503)932-4430

O. Adrich

REGISTERED
PROFESSIONAL
LAND SURVEYOR

SUSAN E. NEWSTETTER
2405

RENEWAL DATE:
12/31/94

S3 S2
S10 S11

See DETAIL #6
below

S2 S1
S11 S12

S1 S6
R.27E. R.28E.

S10 S11
S15 S14

S11 S12
S14 S13

NOT SURVEYED
THIS SURVEY

NOT SURVEYED
THIS SURVEY

NOT SURVEYED
THIS SURVEY

NOT SURVEYED
THIS SURVEY

T.13S. R.27E.
S34

A-17 AM
S3 S2
T.14S. R.27E.

T.13S. R.27E.
S35

A-21 AM
S2 S1
T.14S. R.27E.

S2 S1
T.14S. R.27E.

DETAIL #1

Found 15"x12"x5" stone, marked
CC and the remains of the SE
bearing tree. Accepted and
Remonumented.

Corner position as amended
to the Senior Line

DETAIL #3

Found 28"x9"x3" stone, marked
CC & with grooves, and the
remains of the SE bearing tree.
Accepted and remonumented.

Found a 36" dbh. Western
Larch with healed hacks
on the north and south
faces.

Set witness monument for
line tree.

DETAIL #2

T.13S. R.27E.
S35

Corner position as amended
to the Senior Line

Found 15"x10"x5" stone, marked
1/4, and the remains of the SE
bearing tree. Accepted and
remonumented.

1/4 S2
T.14S. R.27E.

DETAIL #4

T.13S. R.27E.
S35

Corner position as amended
to the Senior Line

Found 15"x14"x10" stone, marked
1/4, and the remains of the SW
bearing tree. Accepted and
remonumented.

1/4 S1
T.14S. R.27E.

DETAIL #6

Found a 28"x18"x10,
unmovable, marked 1/4
on the north face and
an X on top.

S2
1/4 S1
Set a witness corner