



A PORTION OF "MALHEUR CADASTRAL"
LAKE T.16S., R.33-1/2E.
SECTION 4

Ferguson Surveying

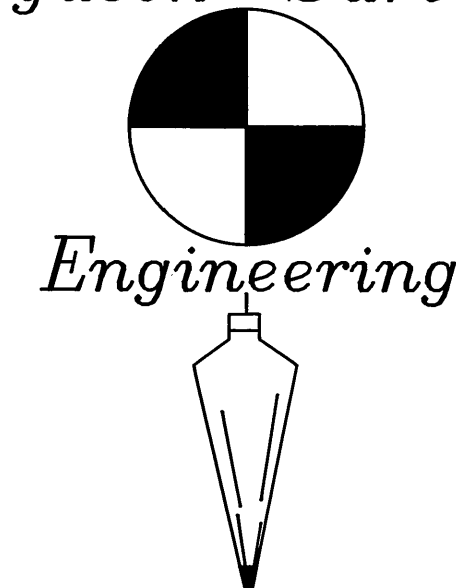


MT. VERNON, OREGON
 PHONE (503)932-4520
 FAX (503)932-4430

Detail of Lots 1-4
 No Scale

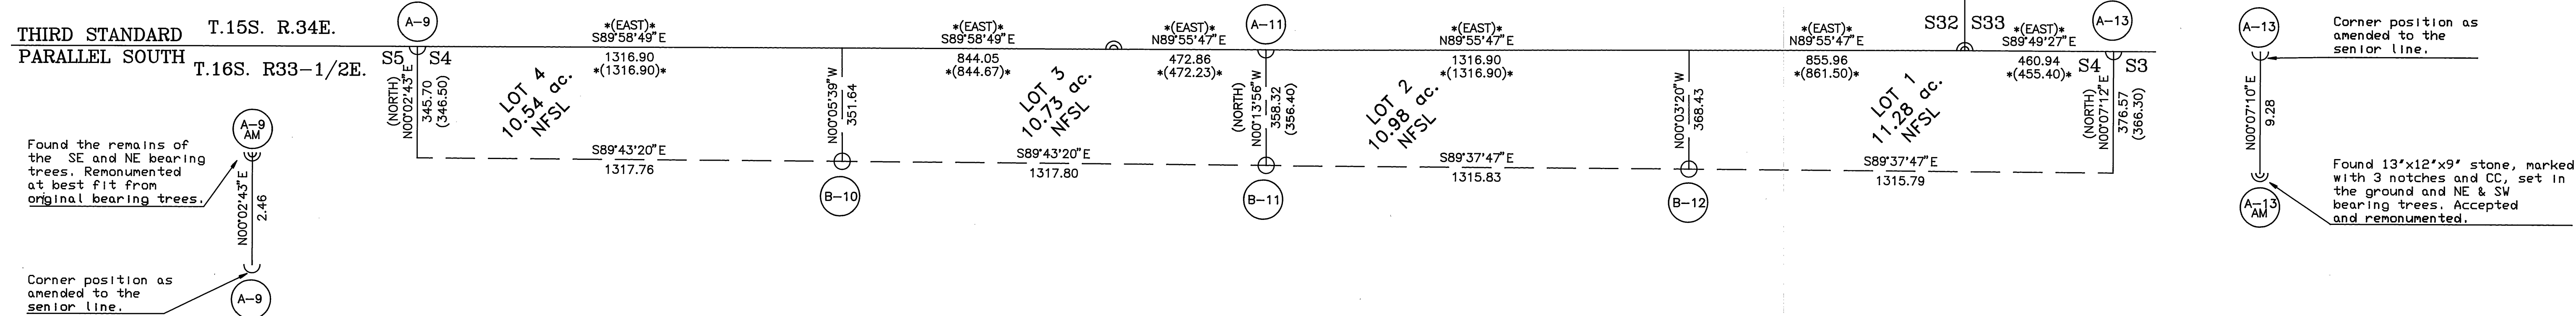


MAGNETIC DECLINATION 20° EAST

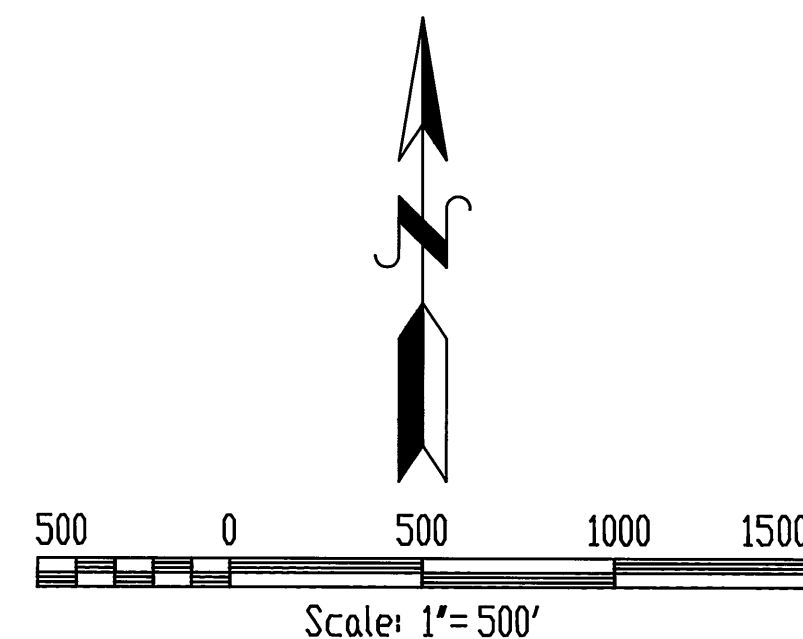

LEGEND

- ⊙ Monumented from original evidence. Set 2-1/2" x 30" aluminum pipe with 3-1/4" aluminum cap.
- Monumented by survey. Set 2-1/2" x 30" aluminum pipe with 3-1/4" aluminum cap.
- Found monument of record, as described in the "History" and notes at each corner.
- (*) Record bearing and distance as returned by Henry W. Cooke in 1883 under GLO Contract No. 470
- () Record bearing and distance as returned by Henry W. Cooke in 1884 under GLO Contract No. 494.
- [] Record bearing and distance as returned by David B. Armstrong, PLS 1026, in 1983 while under contract with the Malheur National Forest.
- Exterior Section Lines
- Center Section Lines
- Subdivisional Lines
- N.F.S.L. National Forest System Lands
- PVT. Private Lands
- PVT. Marked Forest boundary with steel fence posts and Forest boundary signs at maximum intervals of 250 feet.
- N.F.S.L. Existing fence with long line showing direction
- Existing roadway

REGISTERED
 PROFESSIONAL
 LAND SURVEYOR
Susan E. Newstetter
 OREGON
 JULY 26, 1980
 SUSAN E. NEWSTETTER
 2405
 RENEWAL DATE:
 12/31/94

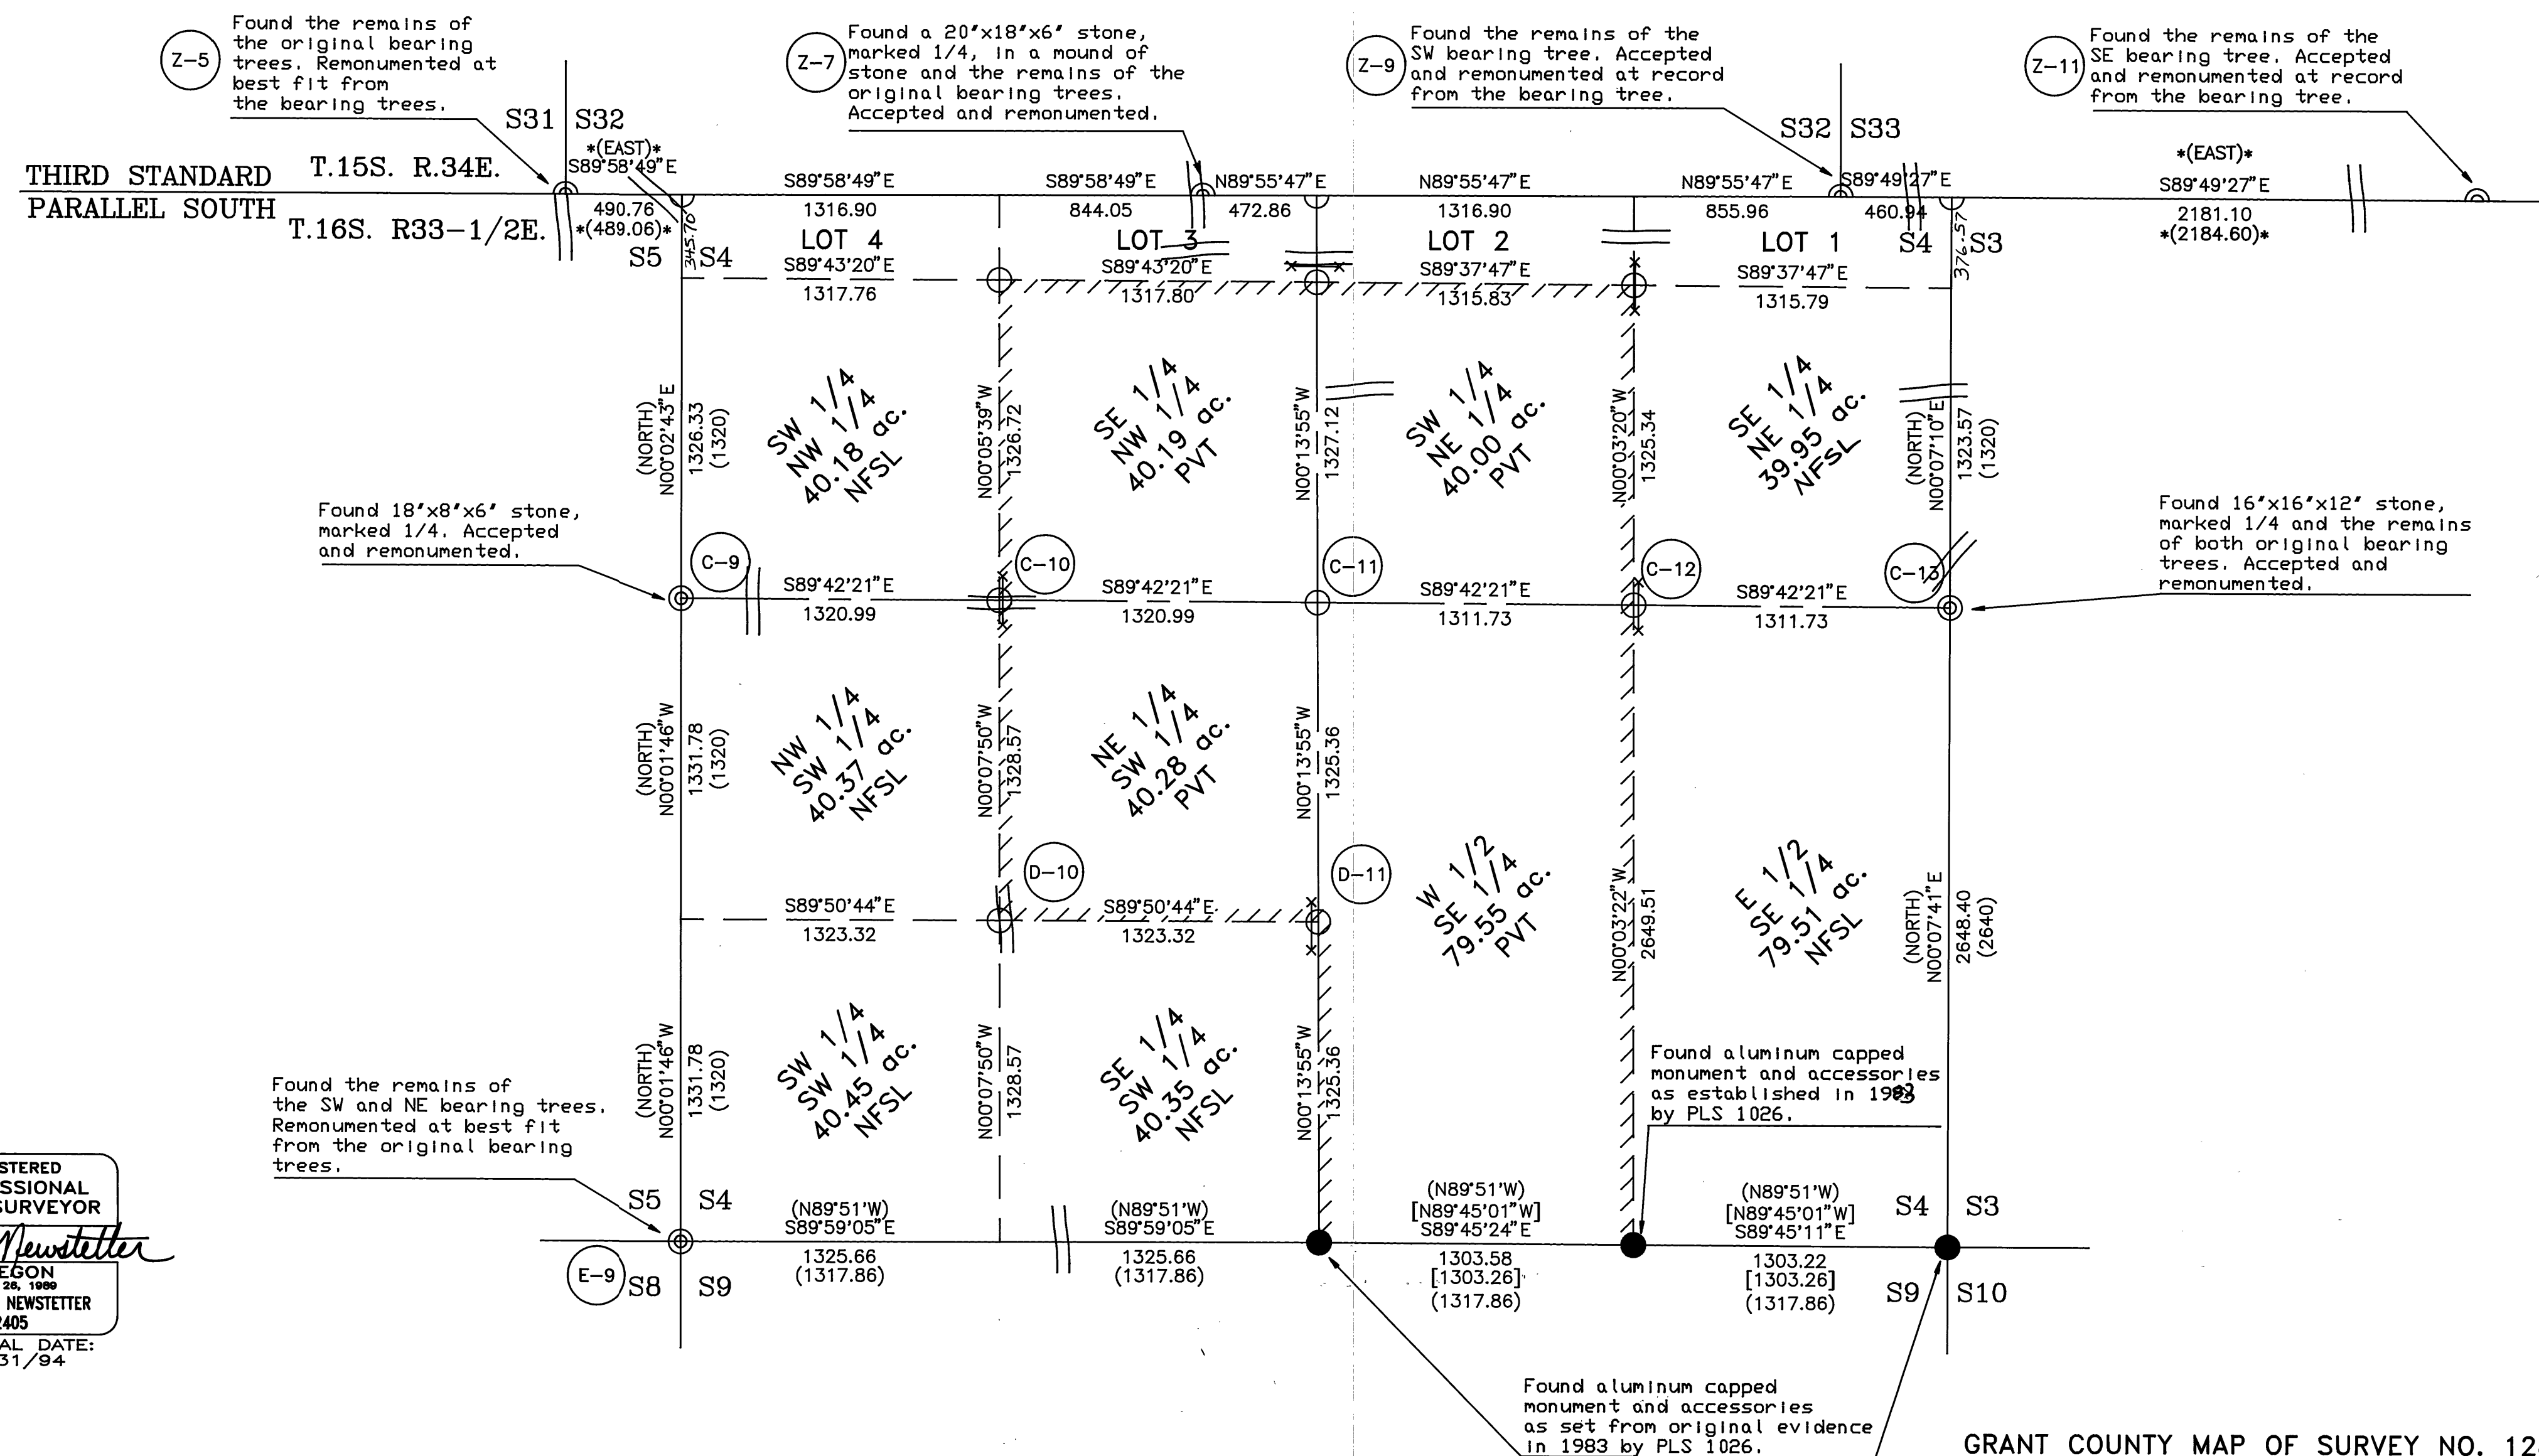

GRANT COUNTY MAP OF SURVEY NO. 1283