


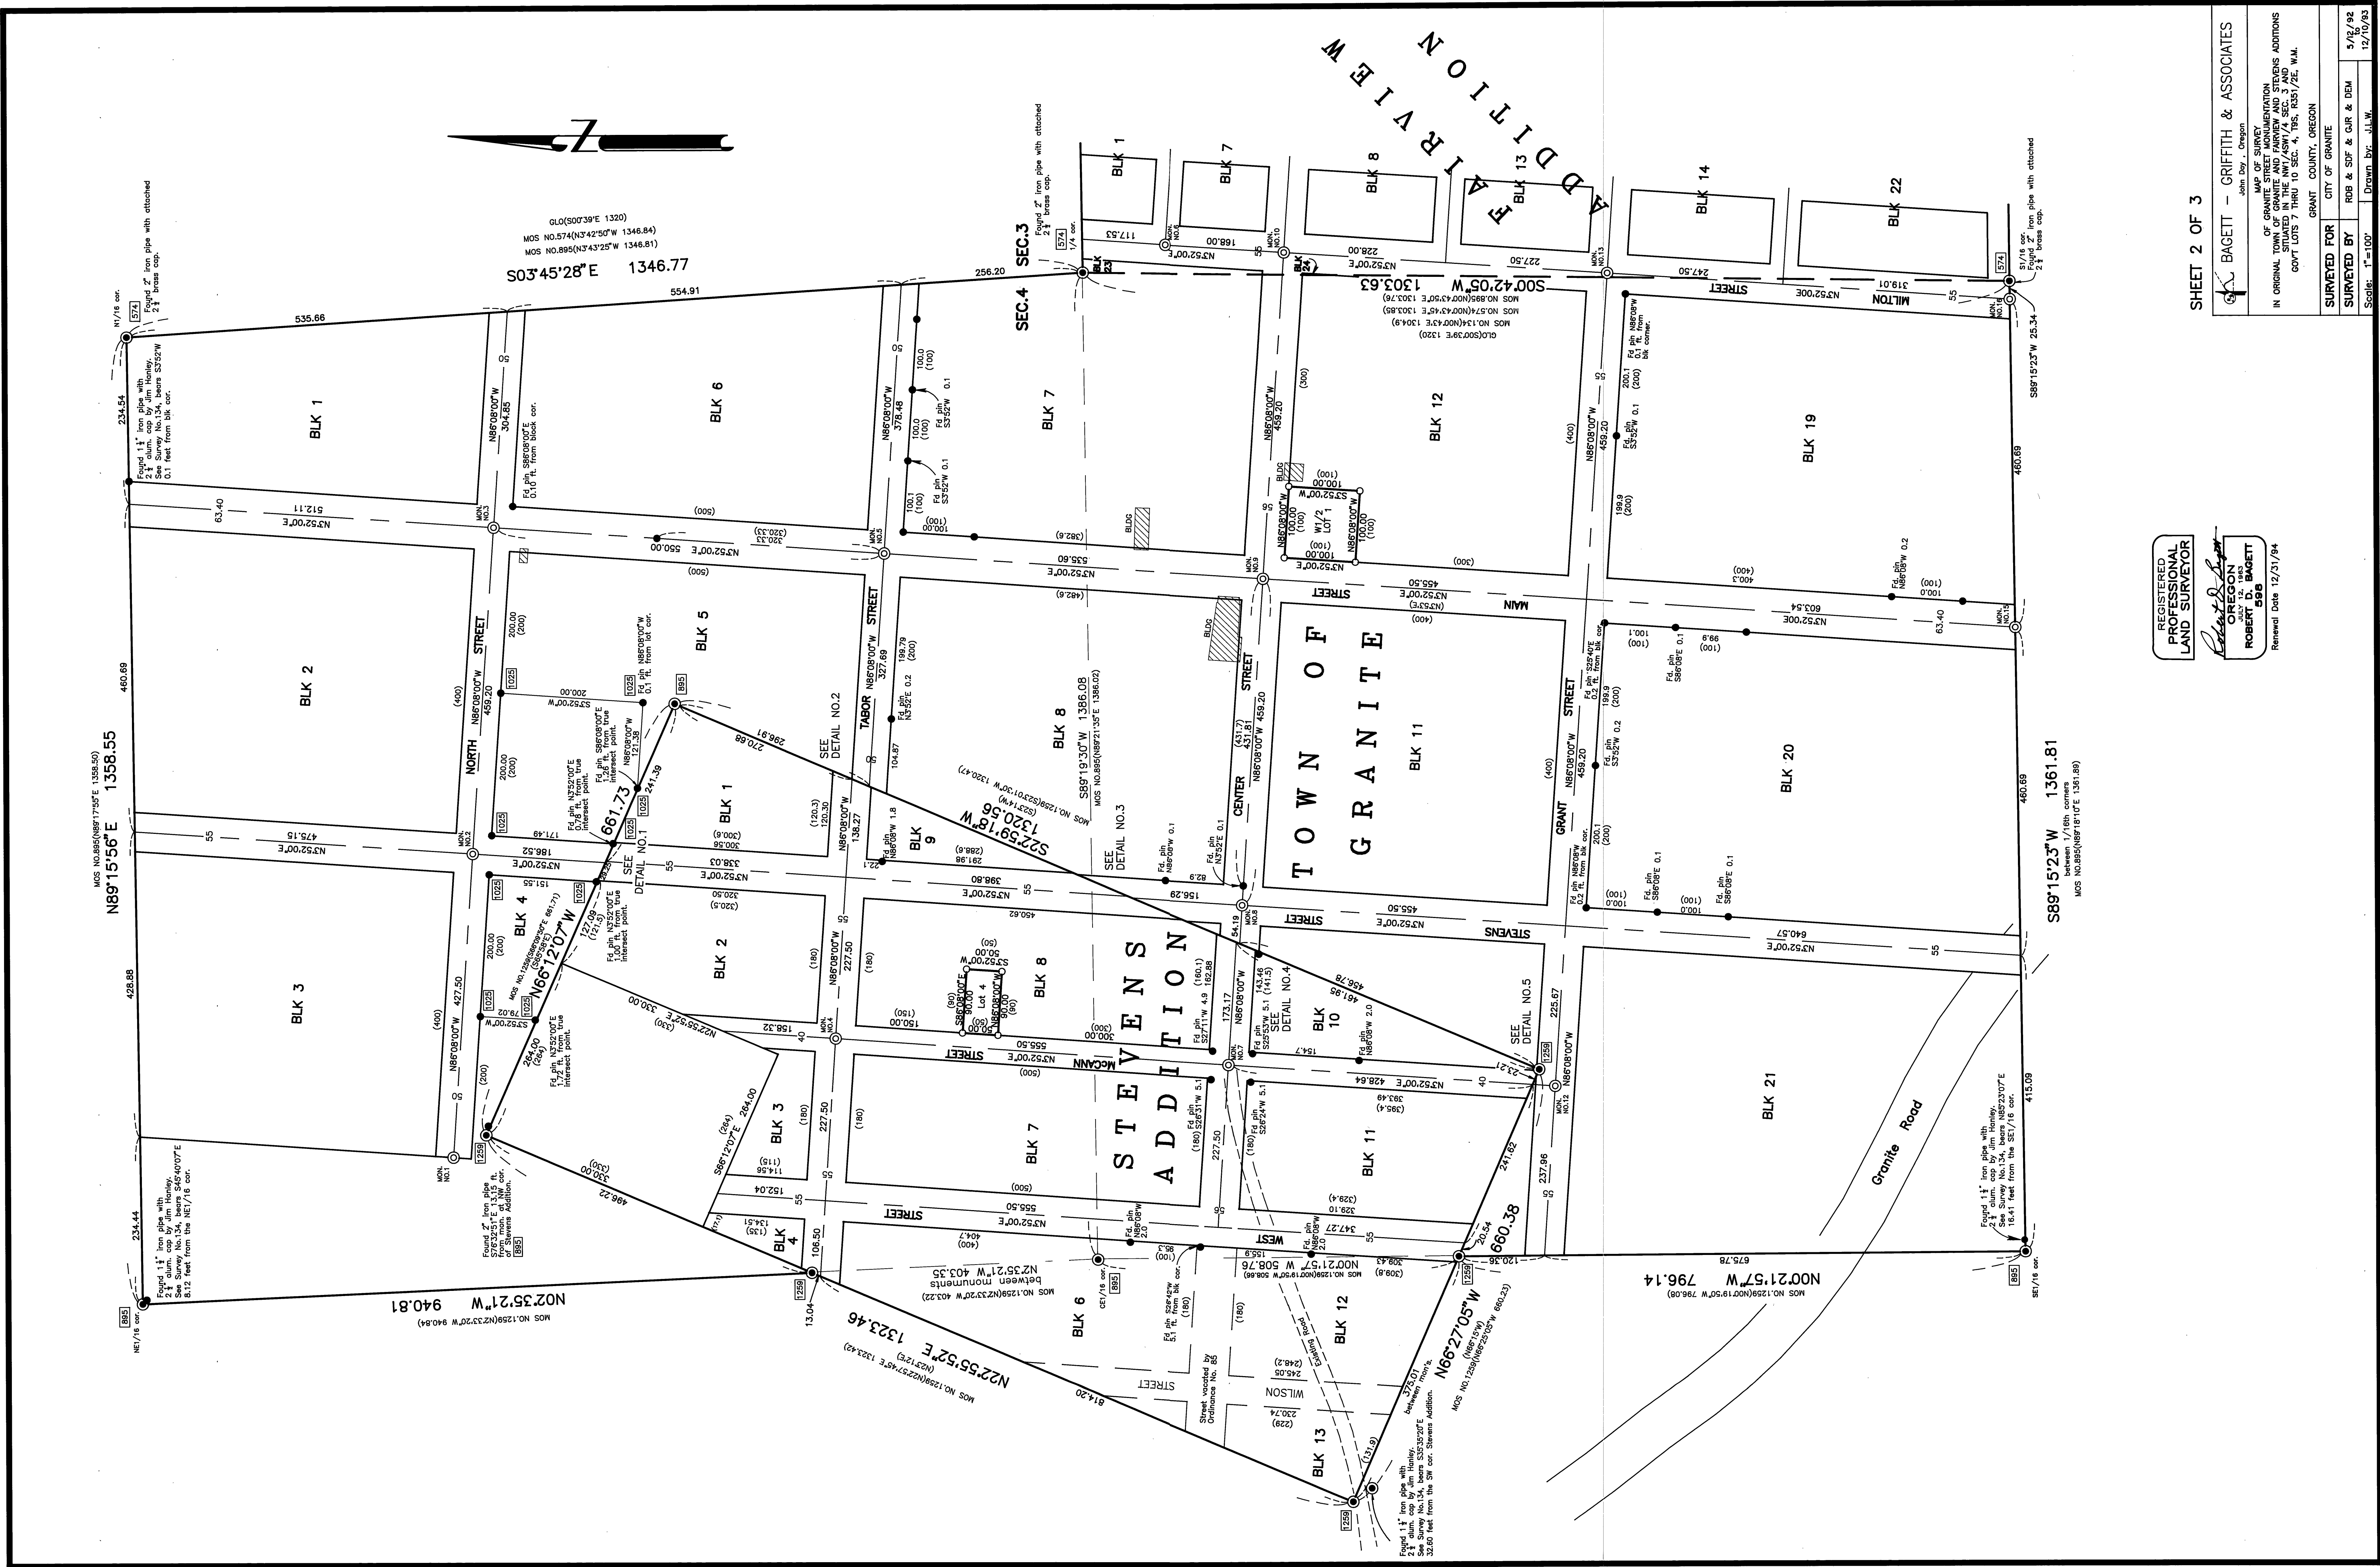

SHEET 2 OF 3

BAGETT - GRIFFITH & ASSOCIATES

MADE OF SURVEY
OF GRANITE STREET MONUMENTATION
IN ORIGINAL TOWN OF GRANITE
STILLING THE NW 1/4 SEC. 3 AND
GOVT LOTS 7 THRU 10 SEC. 4, T9S, R35E, W1E, W.M.

CITY OF GRANITE

ROB & SDF & GJR & DEM

5/12/92

12/10/93

Scale: 1"=100'

Drawn by: J.L.W.

RECORD MAP OF SURVEY NO.1285

REGISTERED
PROFESSIONAL
LAND SURVEYOR

ROBERT D. BAGETT

JULY 12, 1983

Renewal Date 12/31/94