T.14S.,R.33E.

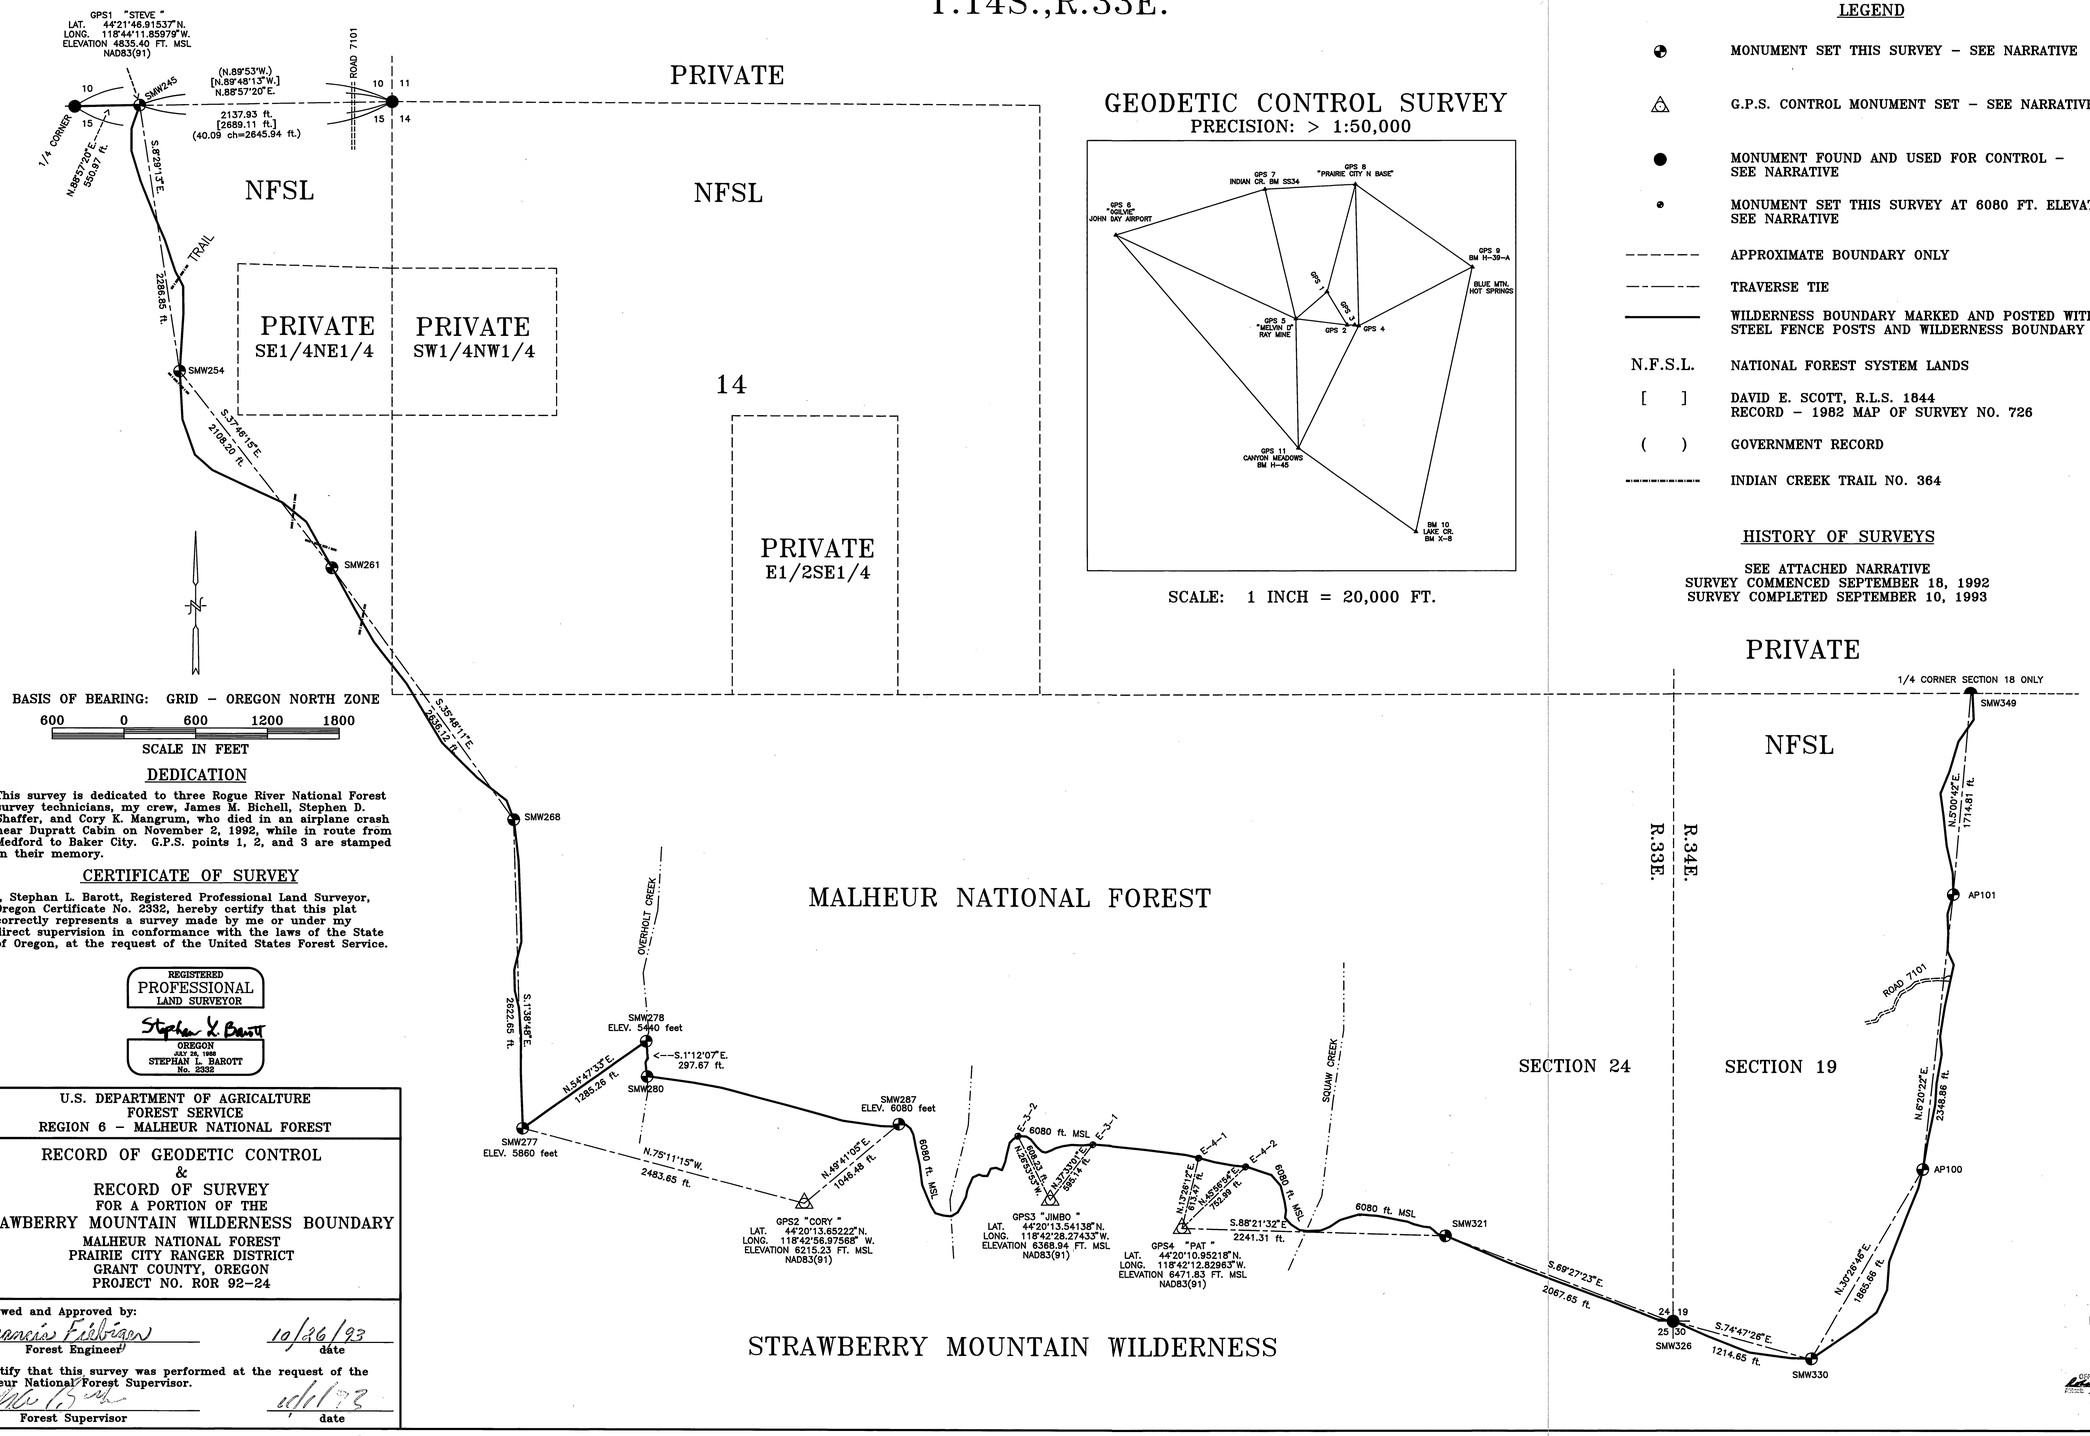

GEODETIC CONTROL SURVEY

PRECISION: > 1:50,000

SCALE: 1 INCH = 20,000 FT.

LEGEND

- MONUMENT SET THIS SURVEY – SEE NARRATIVE
- G.P.S. CONTROL MONUMENT SET – SEE NARRATIVE
- MONUMENT FOUND AND USED FOR CONTROL – SEE NARRATIVE
- MONUMENT SET THIS SURVEY AT 6080 FT. ELEVATION – SEE NARRATIVE
- APPROXIMATE BOUNDARY ONLY
- TRAVERSE TIE
- WILDERNESS BOUNDARY MARKED AND POSTED WITH 6 FT. STEEL FENCE POSTS AND WILDERNESS BOUNDARY SIGNS.
- N.F.S.L. NATIONAL FOREST SYSTEM LANDS
- [ ] DAVID E. SCOTT, R.L.S. 1844 RECORD – 1982 MAP OF SURVEY NO. 726
- ( ) GOVERNMENT RECORD
- INDIAN CREEK TRAIL NO. 364

HISTORY OF SURVEYS

SEE ATTACHED NARRATIVE
SURVEY COMMENCED SEPTEMBER 18, 1992
SURVEY COMPLETED SEPTEMBER 10, 1993

BASIS OF BEARING: GRID – OREGON NORTH ZONE

600 0 600 1200 1800

SCALE IN FEET

DEDICATION

This survey is dedicated to three Rogue River National Forest survey technicians, my crew, James M. Bichell, Stephen D. Shaffer, and Cory K. Mangrum, who died in an airplane crash near Dupratt Cabin on November 2, 1992, while in route from Medford to Baker City. G.P.S. points 1, 2, and 3 are stamped in their memory.

CERTIFICATE OF SURVEY

I, Stephan L. Barott, Registered Professional Land Surveyor, Oregon Certificate No. 2332, hereby certify that this plat correctly represents a survey made by me or under my direct supervision in conformance with the laws of the State of Oregon, at the request of the United States Forest Service.

REGISTERED
PROFESSIONAL
LAND SURVEYOR

Stephan L. Barott

OREGON
JULY 25, 1986
STEPHAN L. BAROTT
No. 2332

U.S. DEPARTMENT OF AGRICALTURE
FOREST SERVICE
REGION 6 – MALHEUR NATIONAL FOREST

RECORD OF GEODETIC CONTROL
&
RECORD OF SURVEY
FOR A PORTION OF THE
STRAWBERRY MOUNTAIN WILDERNESS BOUNDARY
MALHEUR NATIONAL FOREST
PRAIRIE CITY RANGER DISTRICT
GRANT COUNTY, OREGON
PROJECT NO. ROR 92-24

Reviewed and Approved by:

Francis Fielbrian — 10/26/93
Forest Engineer — date

I certify that this survey was performed at the request of the Malheur National Forest Supervisor.

Forest Supervisor — 10/1/93
date

RECEIVED AND FILED
NOV 29 1993
OFFICE OF COUNTY SURVEYOR
FIELD BOOK
PAGE

MAP OF SURVEY NO. 1293