


TOWNSHIP 10 SOUTH, RANGE 27 EAST, OF THE WILLAMETTE MERIDIAN, OREGON.

DEPENDENT RESURVEY

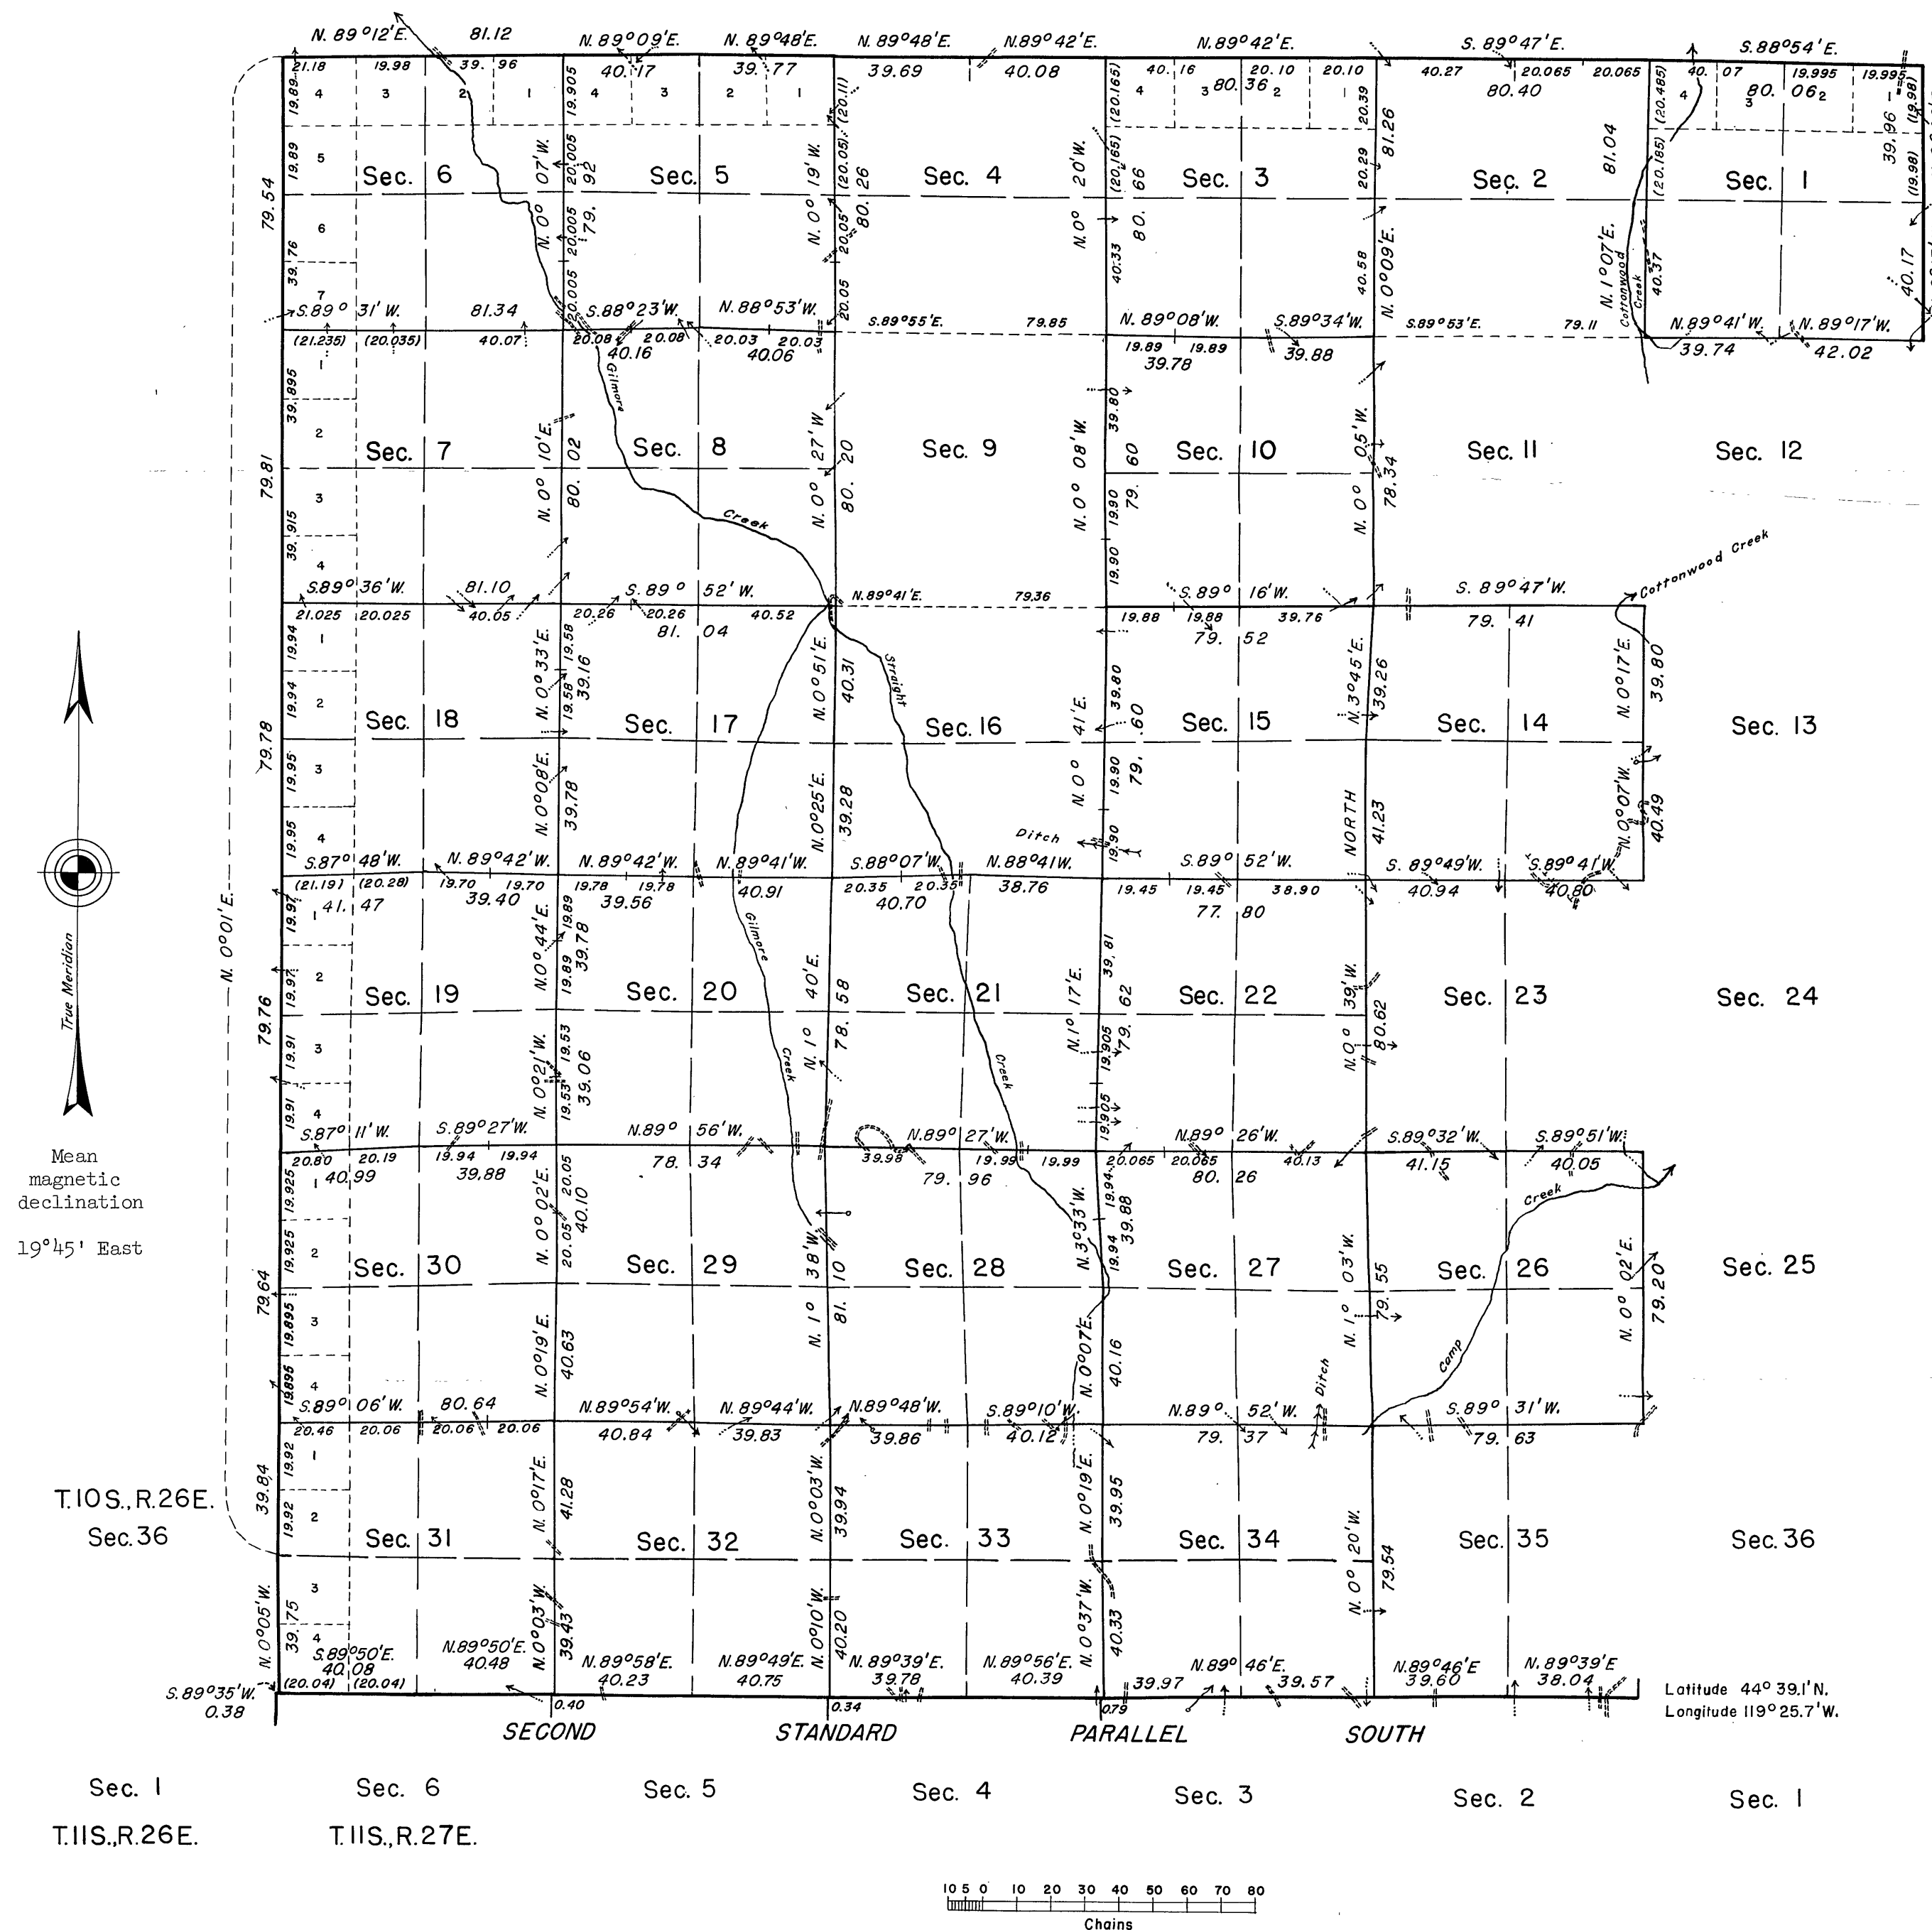

This plat represents a retracement and reestablishment of a portion of the second standard parallel south, south boundary of T. 10 S., R. 27 E., the north and west boundaries, a portion of the east boundary, and a portion of the subdivisional lines of T. 10 S., R. 27 E., Willamette Meridian, Oregon, designed to restore the corners in their true original location according to the best available evidence. The lottings and areas are as shown on the plat approved December 19, 1881.

The second standard parallel south and the north, east and west boundaries of the township were surveyed in 1879 by E. A. Thatcher. The second standard parallel south, south boundary of the township was retraced by A. F. York in 1880. In 1881 A. F. York again retraced the second standard parallel south and the north, east and west boundaries, and subdivided the township.

Dependent resurvey of a portion of the second standard parallel south, south boundary of T. 10 S., R. 27 E., the north and west boundaries and a portion of the east boundary, and a portion of the subdivisional lines of T. 10 S., R. 27 E., Willamette Meridian, Oregon, executed by C. Albert White, and Raymond M. Bicknell, September 15, 1955, to November 4, 1960, under Special Instructions dated August 17, 1955, which provide for the surveys included under Group No. 319, Oregon.

UNITED STATES DEPARTMENT OF THE INTERIOR
BUREAU OF LAND MANAGEMENT
Washington, D.C. March 12, 1963

This plat is strictly conformable to the approved field notes, and the survey, having been correctly executed in accordance with the requirements of law and the regulations of this Bureau, is hereby accepted.

For the Director

E. L. Pennington
Chief, Division of Engineering

Survey Map 131