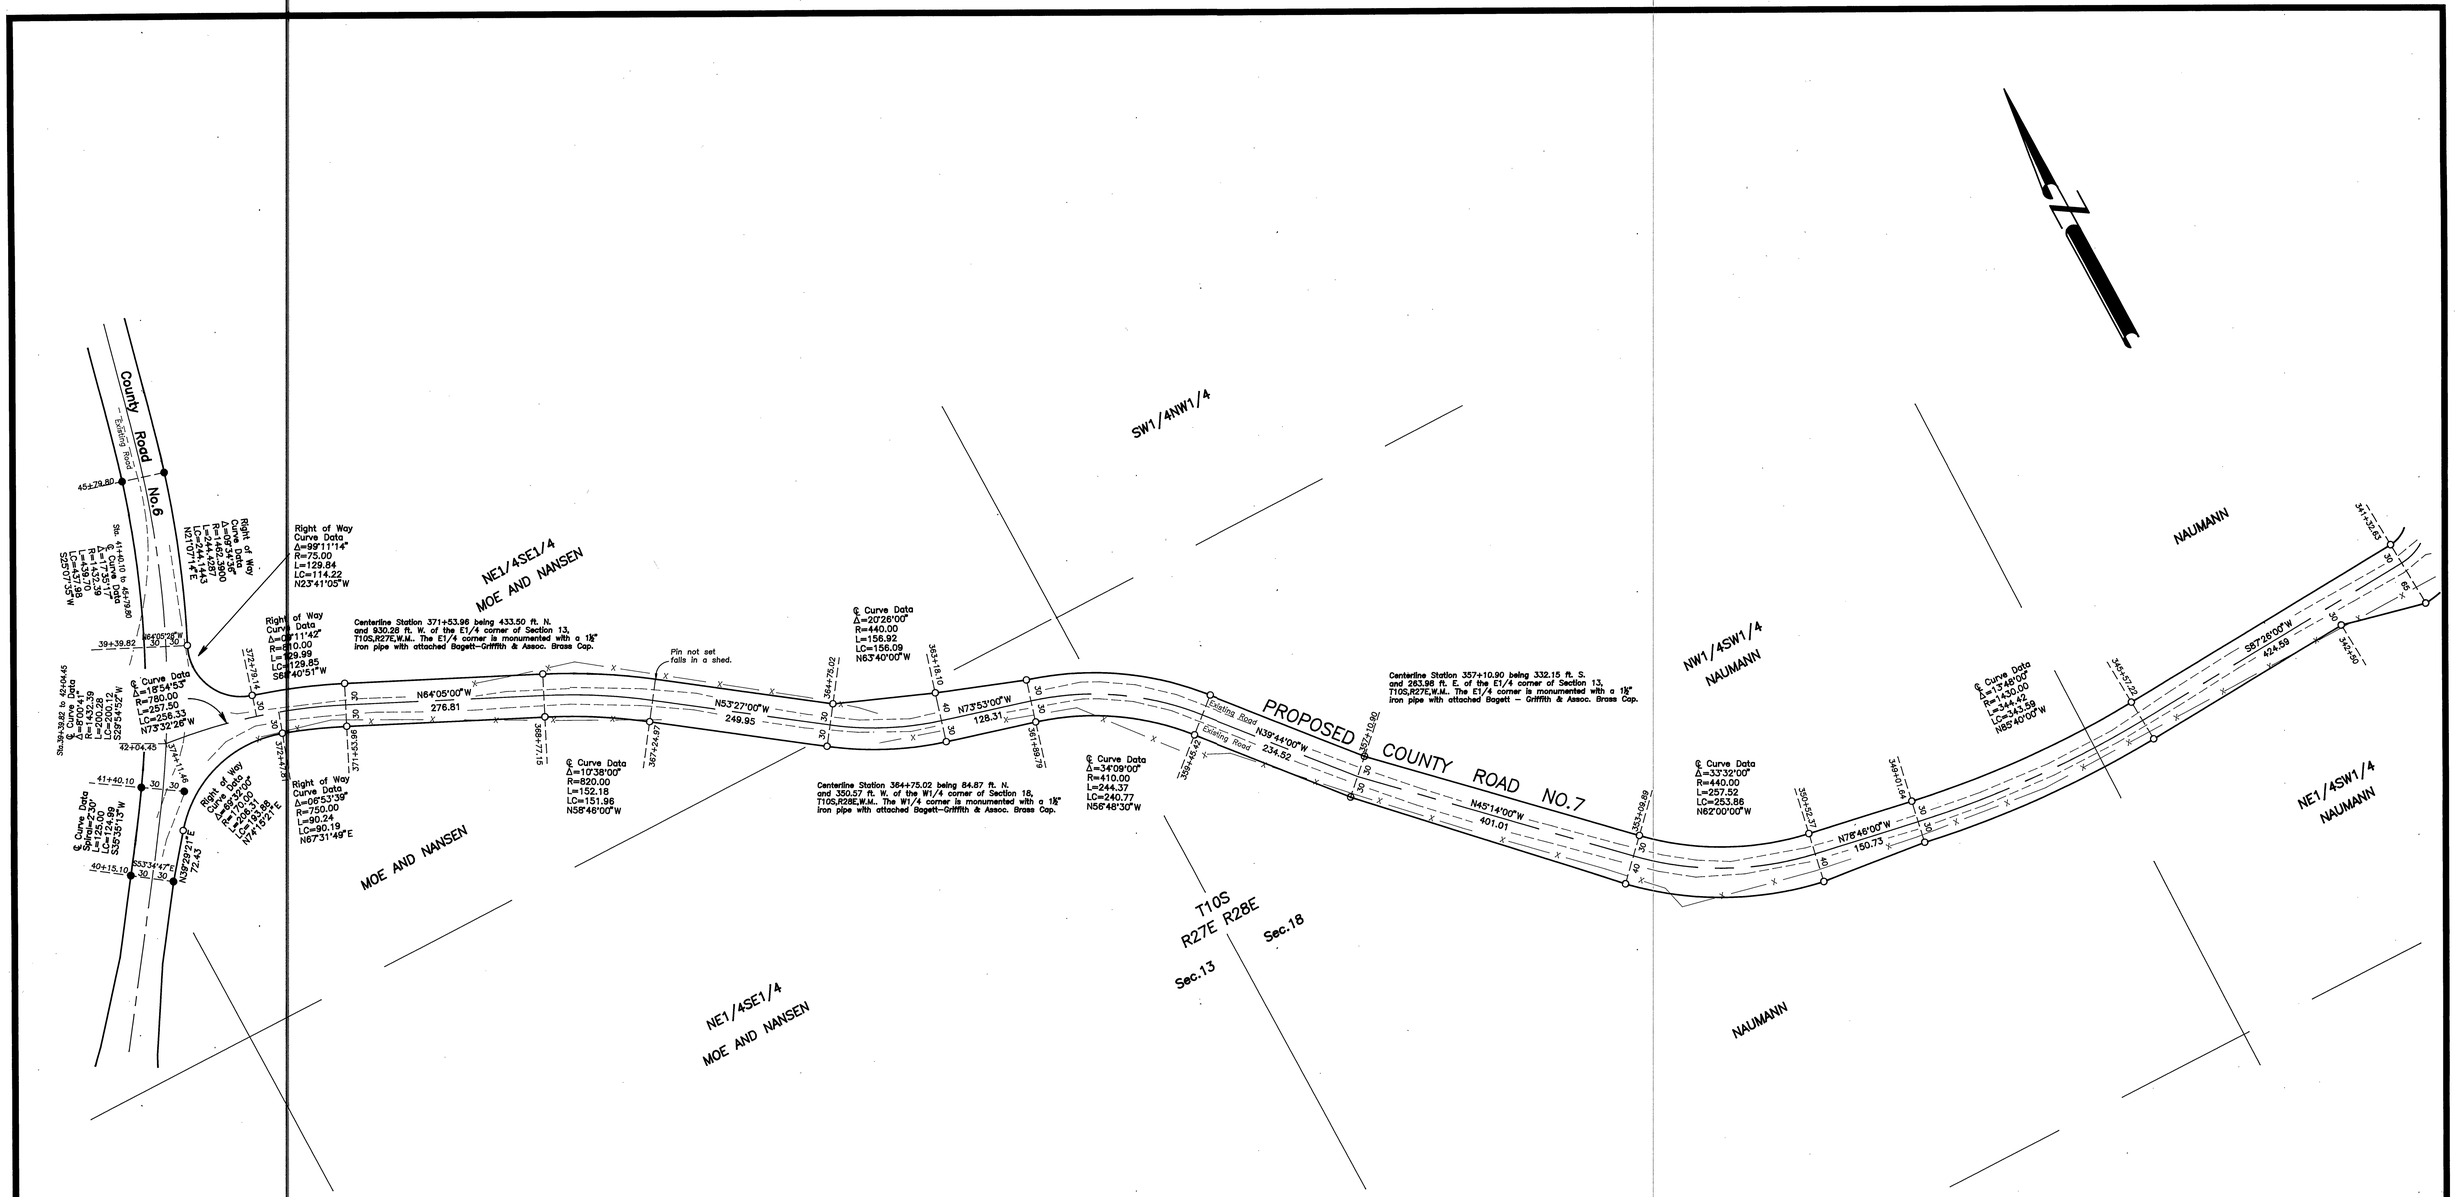

REGISTERED
PROFESSIONAL
LAND SURVEYOR

Robert D. Bagett

OREGON
JULY 12, 1983
ROBERT D. BAGETT
598

Renewal Date 12/31/94

SHEET 7 OF 7

BAGETT - GRIFFITH & ASSOCIATES
John Day, Oregon

MAP OF SURVEY
OF PROPOSED COUNTY ROAD NO.7 SITUATED IN THE SW1/4 SEC.35, T9S,R28E AND IN THE NE1/4; SE1/4 SEC.13, T10S, R27E AND IN THE NW1/4 SEC.2; SE1/4; SW1/4 SEC.3; SE1/4; SW1/4 SEC.4; SE1/4; SW1/4 SEC.5; NE1/4; SE1/4 SEC.7; NW1/4 SEC.8; NE1/4; SW1/4; NW1/4 SEC.18 T9S,R28E,W.M.
GRANT COUNTY, OREGON

SURVEYED FOR	GRANT COUNTY ROAD DEPARTMENT	
SURVEYED BY	RDB & SDF & GJR & DEM & RJL	Feb. 1993 to July 1994
Scale: 1"=100'	Drawn by: J.L.W.	

RECORD MAP OF SURVEY NO.1312

IDAHO BLUEPRINT & SUP. CO. INC. – BOISE, IDAHO