


TOWNSHIP 10 SOUTH, RANGE 26 EAST, OF THE WILLAMETTE MERIDIAN, OREGON.

DEPENDENT RESURVEY

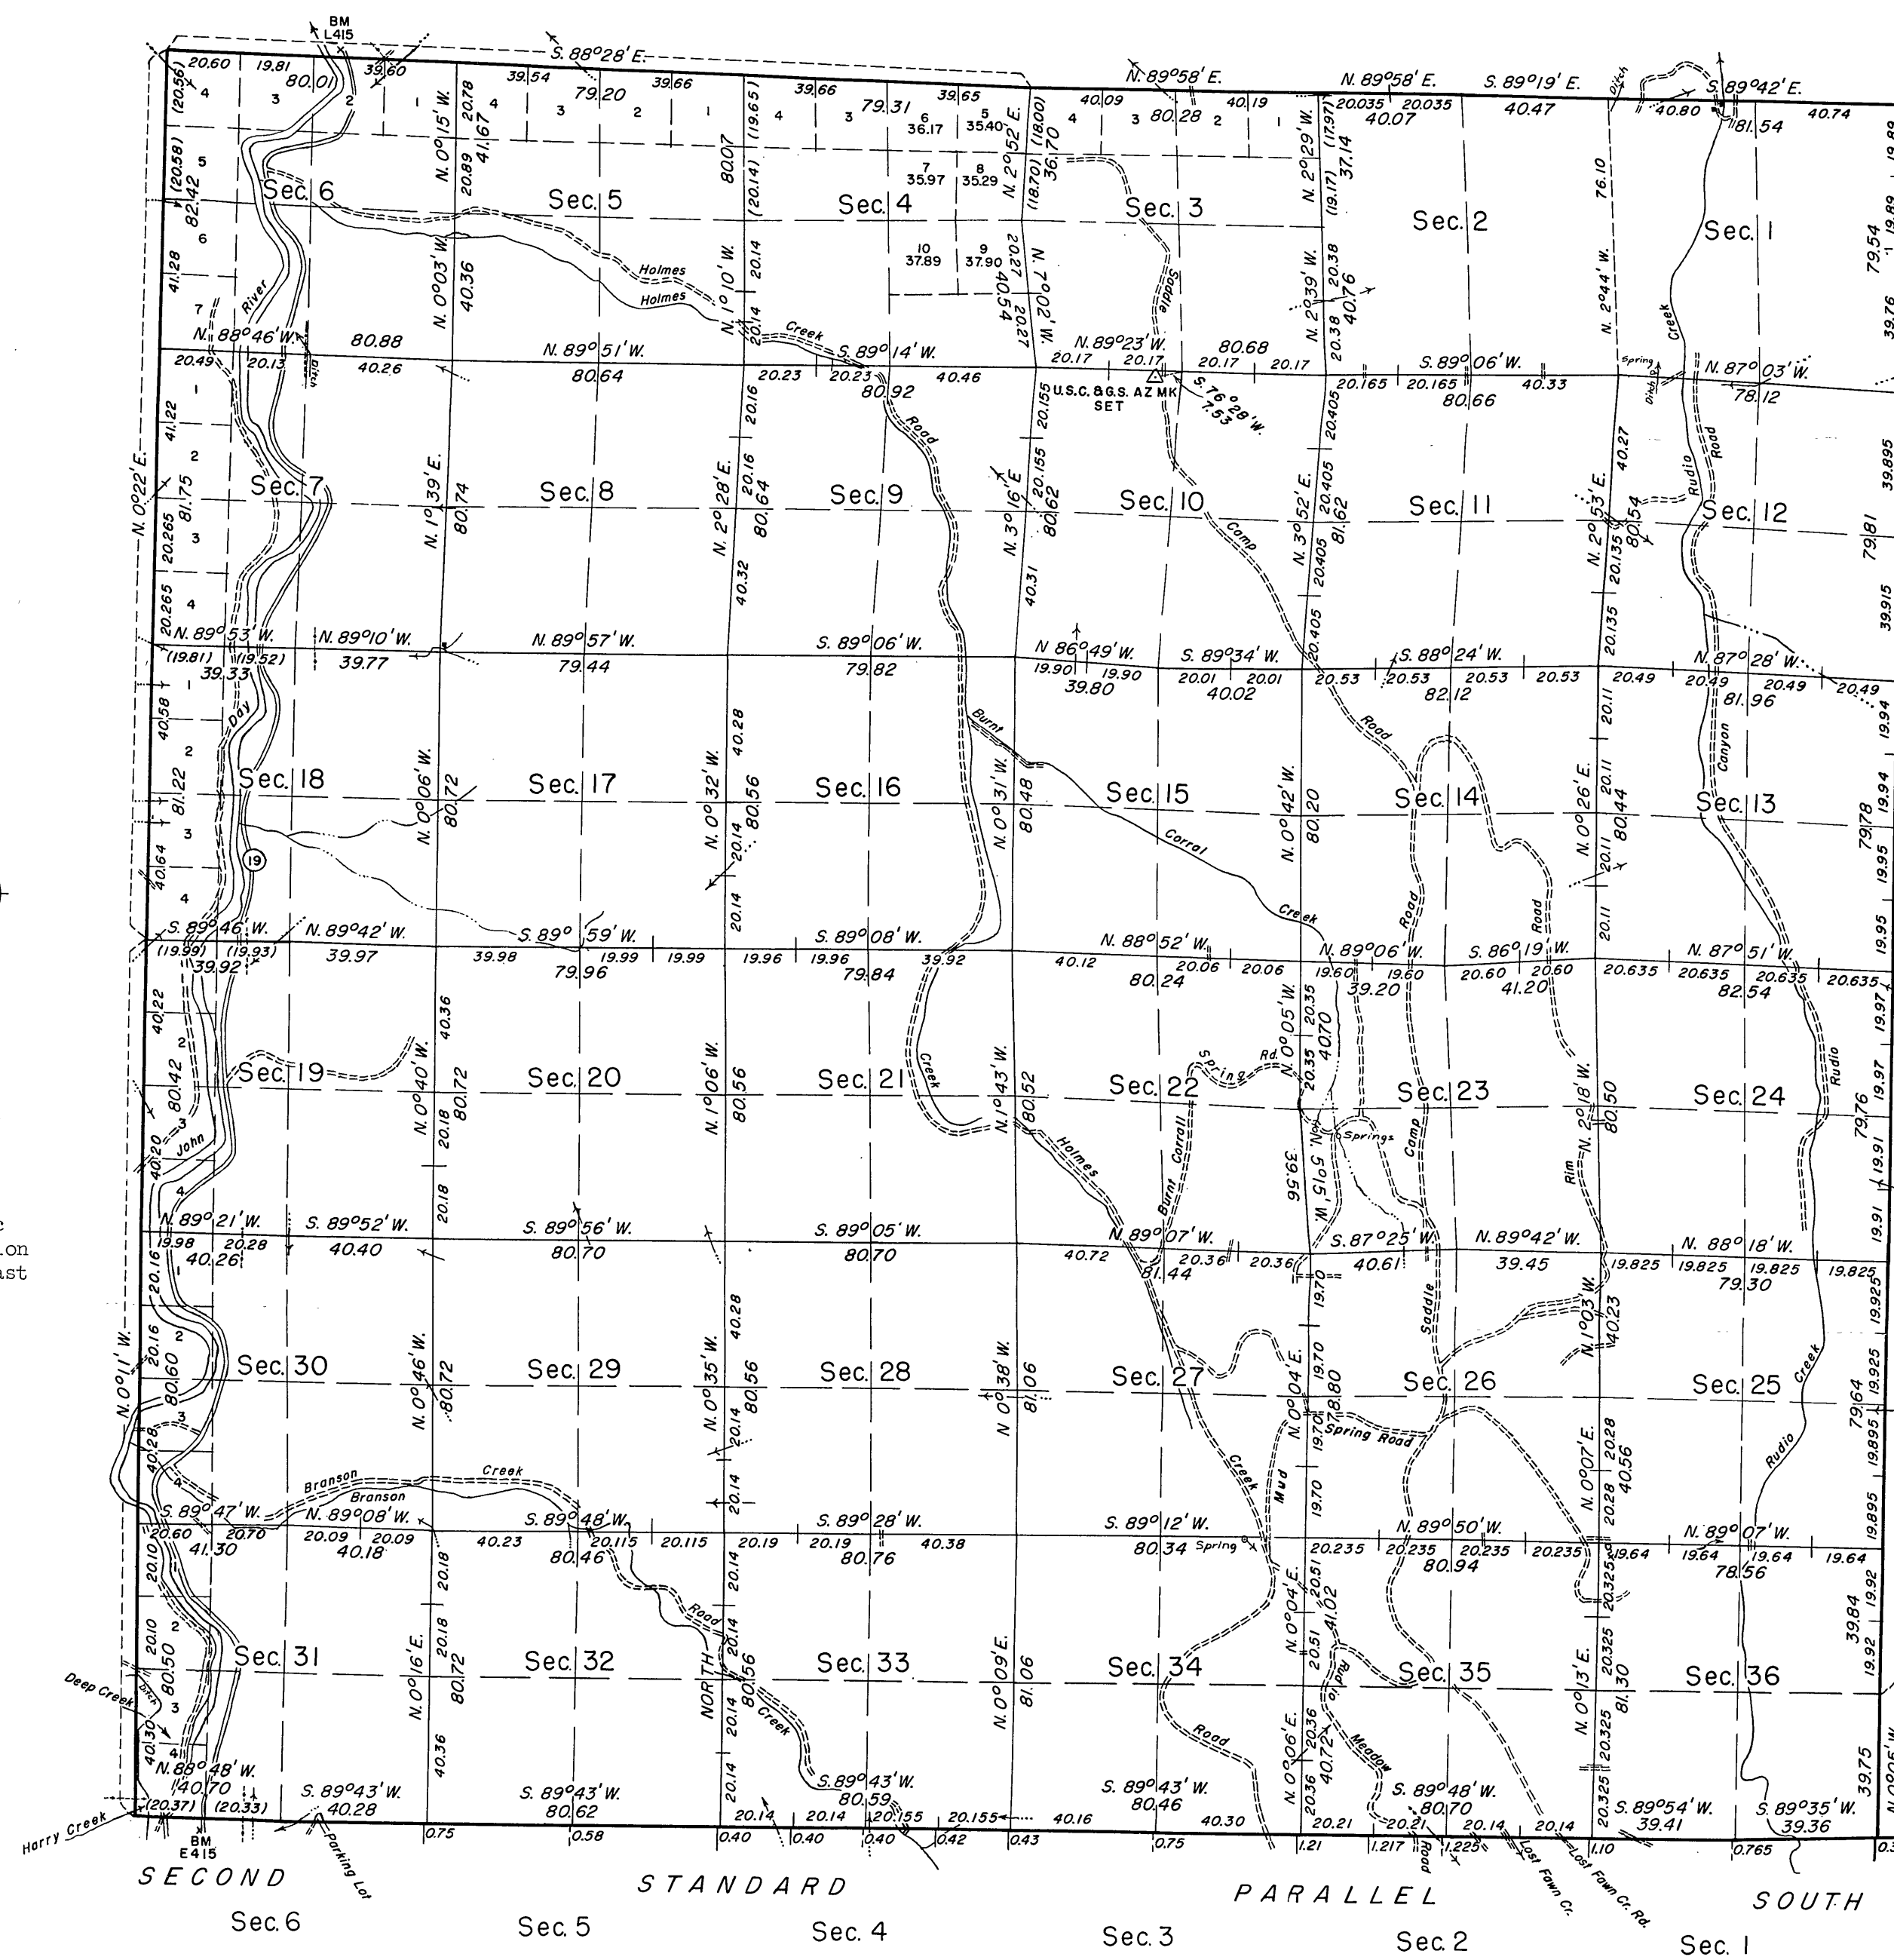

This plat represents a retracement and reestablishment of the North, South, and West boundaries and a portion of the subdivisional lines of T. 10 S., R. 26 E., Willamette Meridian, Oregon, designed to restore the corners in their true original location according to the best available evidence; and, excepting as new or modified vacant subdivisions are shown hereon, the lottings and areas are as shown on the plat approved December 19, 1881.

The second standard parallel south and the north, east, and west boundaries of the township were surveyed in 1879 by E. A. Thatcher. The second standard parallel south, south boundary of the township, was retraced by A. F. York in 1880. In 1881, A. F. York again retraced the second standard parallel south, and the north, east, and west boundaries, and subdivided the township. The west boundary was retraced by M. A. Fullerton in 1881. In 1955-60, the east boundary was dependently resurveyed under this assignment.

Dependent resurvey of the second standard parallel south along the south boundary, and the north and west boundaries and a portion of the subdivisional lines of T. 10 S., R. 26 E., Willamette Meridian, Oregon, executed by C. Albert White and John M. Jelley, October 17, 1960, to June 16, 1961, under Special Instructions dated August 17, 1955, which provide for the surveys included under Group No. 319, Oregon.

UNITED STATES DEPARTMENT OF THE INTERIOR
BUREAU OF LAND MANAGEMENT
Washington, D. C. November 21, 1963

This plat is strictly conformable to the approved field notes, and the survey, having been correctly executed in accordance with the requirements of law and the regulations of this Bureau, is hereby accepted.

For the Director

E. E. Remington
Chief, Division of Engineering

Latitude 44° 39.1' N.
Longitude 119° 31.8' W.

Timber in this area consists of scattered stands of ponderosa pine, Douglas fir, white fir, with some tamarack and juniper.

Area resurveyed - 21,731.34 Acres