


T18S, R27E, WM

GRANT CO., OR
SEC. 17 & 20

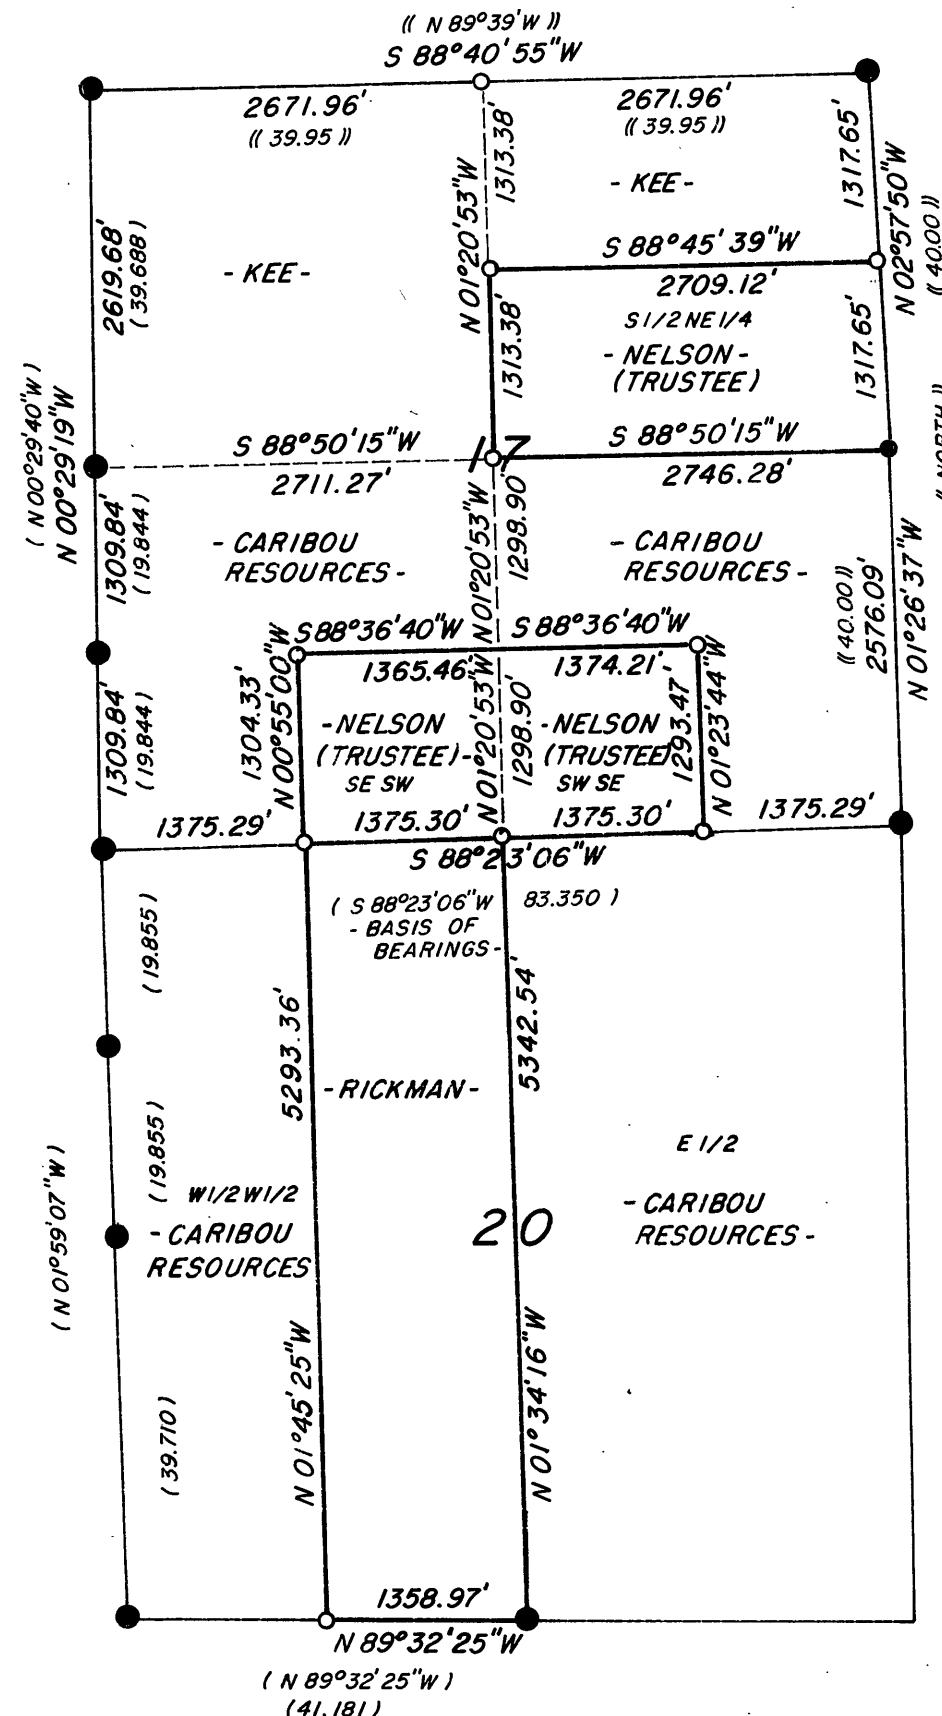

LEGEND

- 3" dia. brass caps on 2" X 36" iron pipes found. Set by B.L.M.
- G.L.O. corner found - set 5/8" iron pin with 1-1/2" alum. cap stamped - PLS 1288 MAPS 1994 -
- Set 5/8" iron pins with 1-1/2" alum. caps stamped - PLS 1288 MAPS 1994 - Set at proportioned locations
- () B.L.M. data of record
- " " G.L.O. data of record

NOTE & NARRATIVE

This survey was done in May & June of 1994 at the request of Caribou Resources & Snow Mtn. Pine Co. to establish property boundaries for timber harvest. Bearings are based on the B.L.M. bearing - E & W between Sections 17 & 20. Corners found were the control for this survey.

See attached Corner Record Sheets on corners set during this survey.

PREVIOUS SURVEYS

B.L.M. survey by Daniel E. Weller, Cadastral Surveyor, beginning April 22, 1992 and completed on June 17, 1993. This survey has not yet met final approval by the Chief Cadastral Surveyor of Oregon.

G.L.O. survey by Alonzo Gesner under contract no. 206 dated July 10, 1874.

RECEIVED AND
FILED

JUL 21 1994

OFFICE OF COUNTY SURVEYOR
Attest: *Joseph R. Kull*

REGISTERED PROFESSIONAL LAND SURVEYOR <i>Chris T. Palmer</i>		CARIBOU RESOURCES & SNOW MTN PINE CO. <u>SURVEY PLAT</u>	
OREGON SEPTEMBER 23, 1977 CHRIS T. PALMER 1288 RENEWAL DATE 1-1-95		Scale: 1" = 1320' Dsn: Drn: CHRIS Ckd:	Date: JUNE 1994 Job: 1480, 1510 Sht. No. / of 1 /

MAP's

M. A. PALMER & SONS, INC.
ENGINEERING & SURVEYING
254 N. Alder - Box 61
Burns, Oregon 97720

MAP OF SURVEY NO. 1335