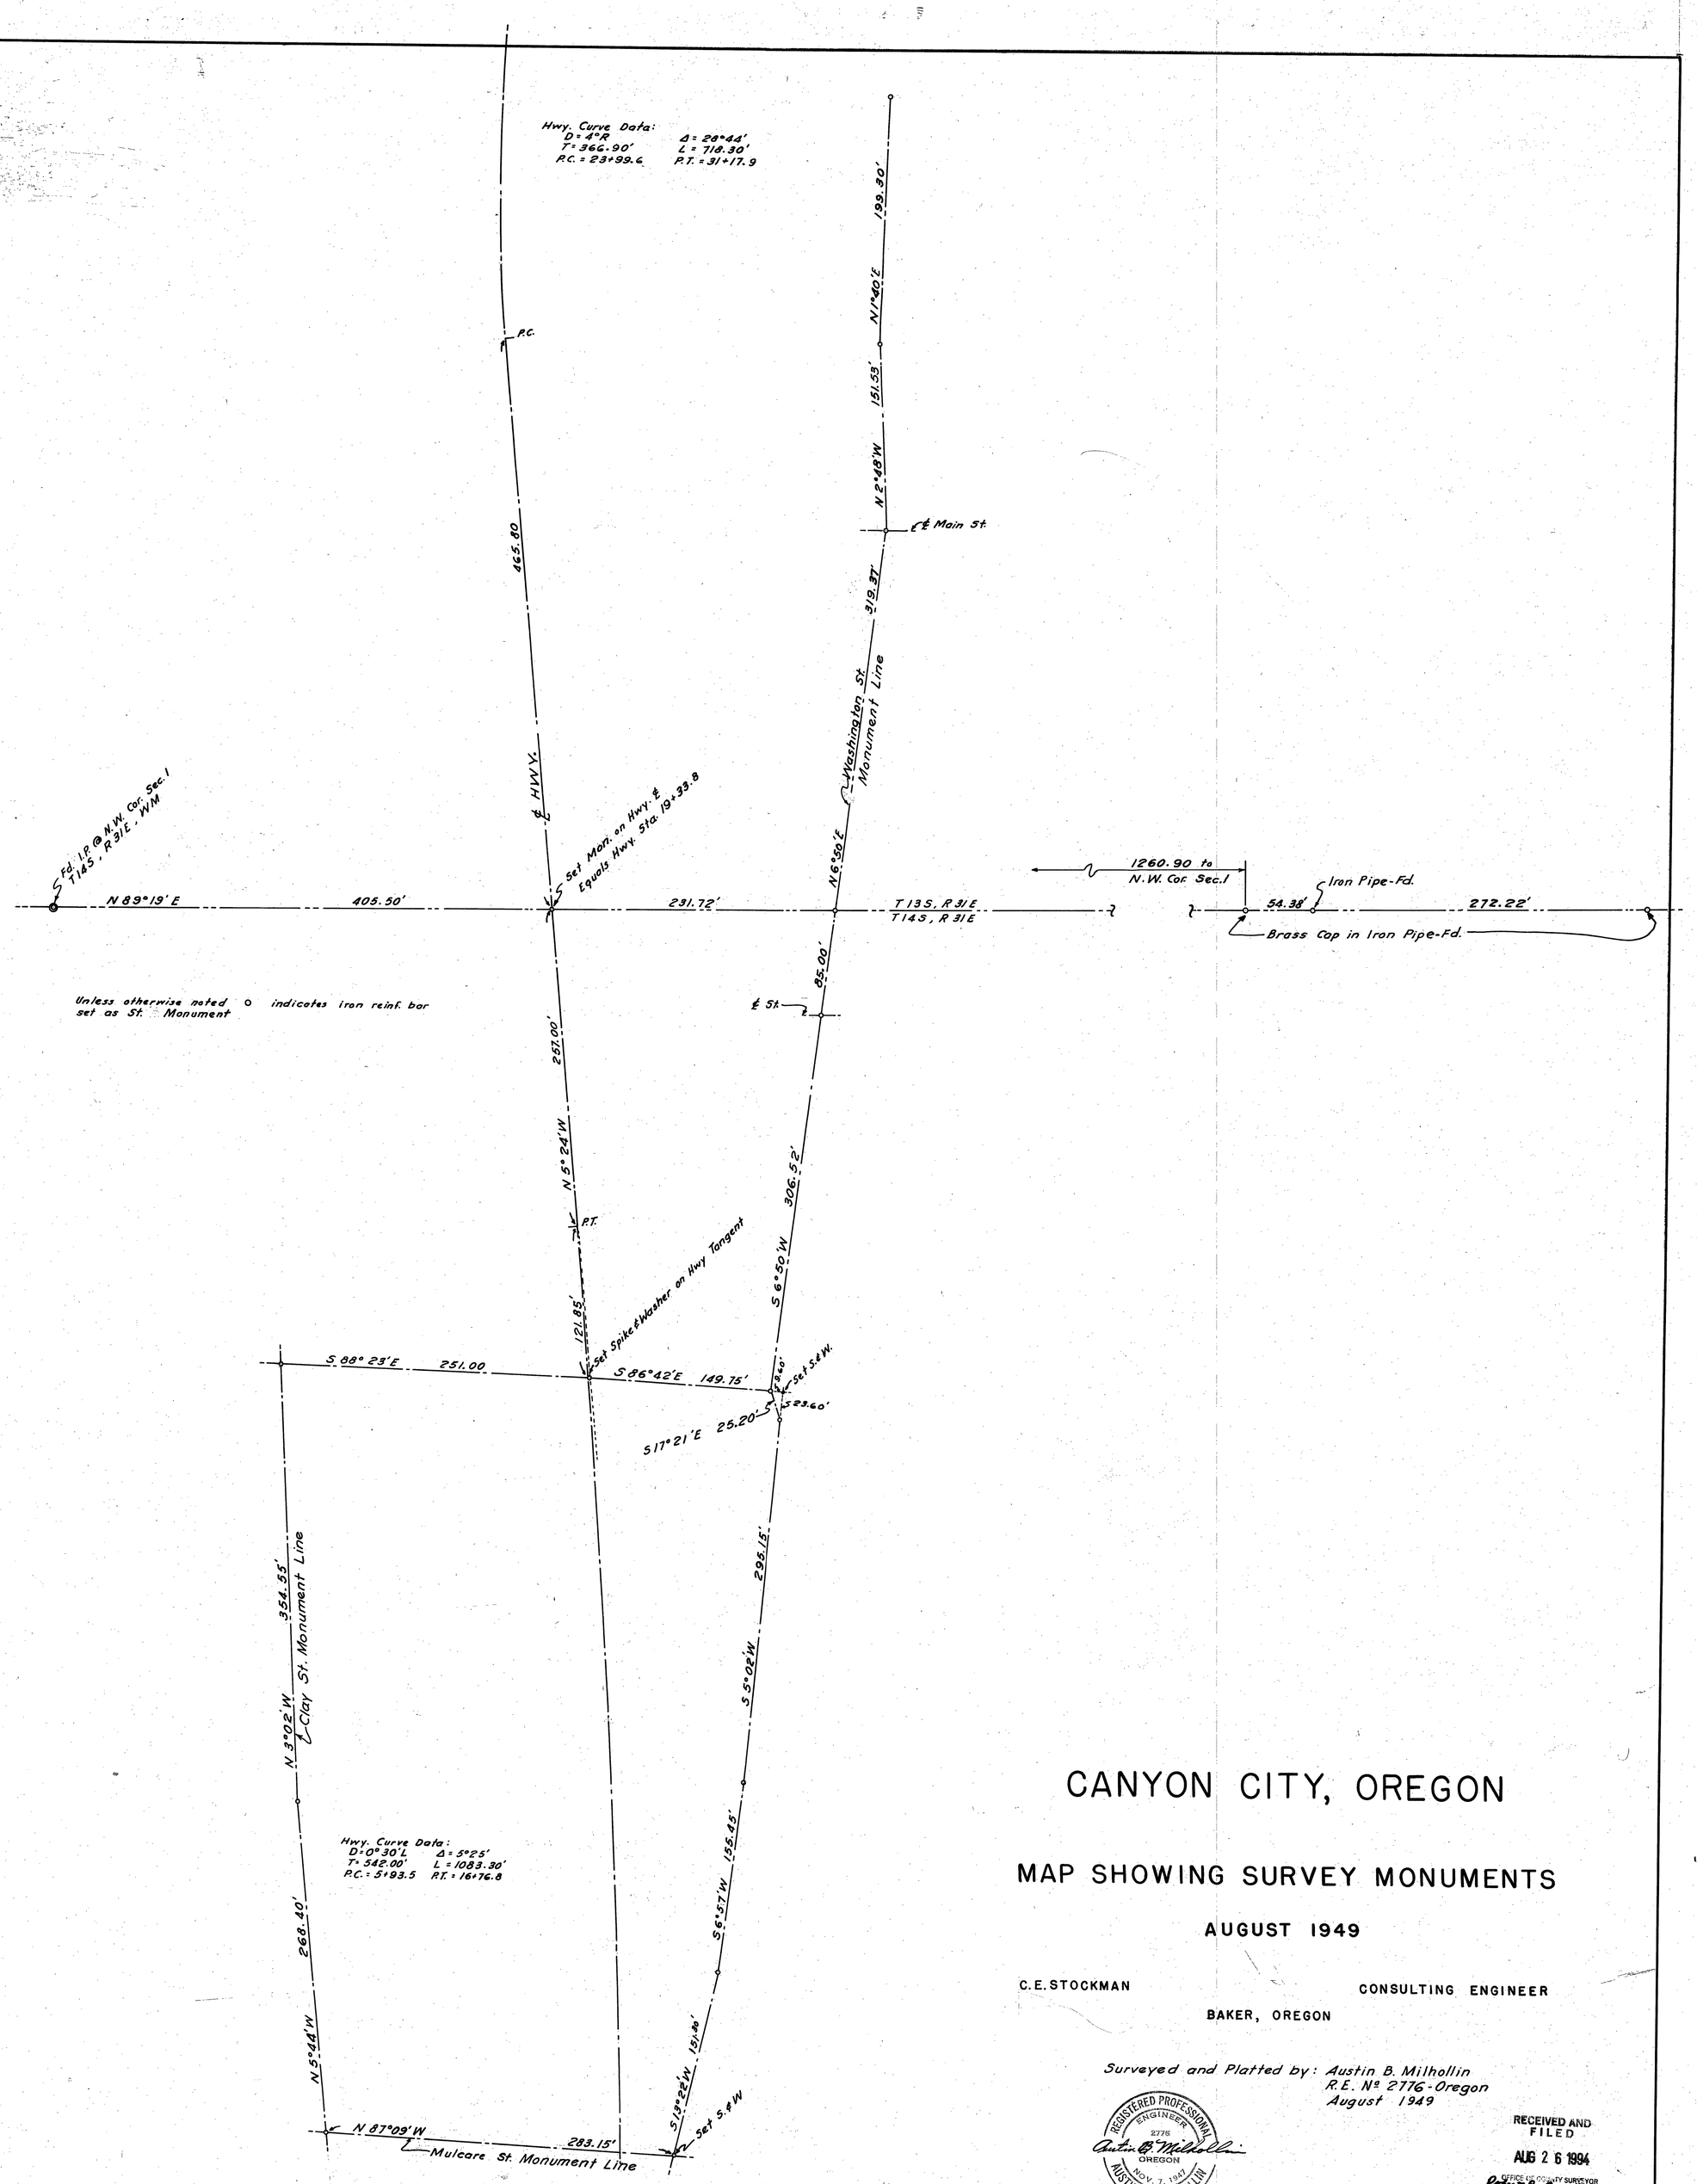

CANYON CITY, OREGON

MAP SHOWING SURVEY MONUMENTS

AUGUST 1949

C.E. STOCKMAN — CONSULTING ENGINEER

BAKER, OREGON

Surveyed and Platted by: Austin B. Milhollin
R.E. Nº 2776-Oregon
August 1949

REGISTERED PROFESSIONAL ENGINEER 2776 OREGON NOV. 7, 1947 AUSTIN B. MILHOLLIN

Austin B. Milhollin

RECEIVED AND FILED
AUG 26 1994
OFFICE OF COUNTY SURVEYOR
Attest:

MAP OF SURVEY NO. 1338