


NOTES: Found one B.T. for North $\frac{1}{4}$ Cor. of Sec. 3. Stone not found.
Set iron post monument with aluminum cap at corner location, which is N. 89°19'E., 2658.6' from the Northeast Corner of Sec. 4, T. 9 S., R. 35 $\frac{1}{2}$ E., W.M.

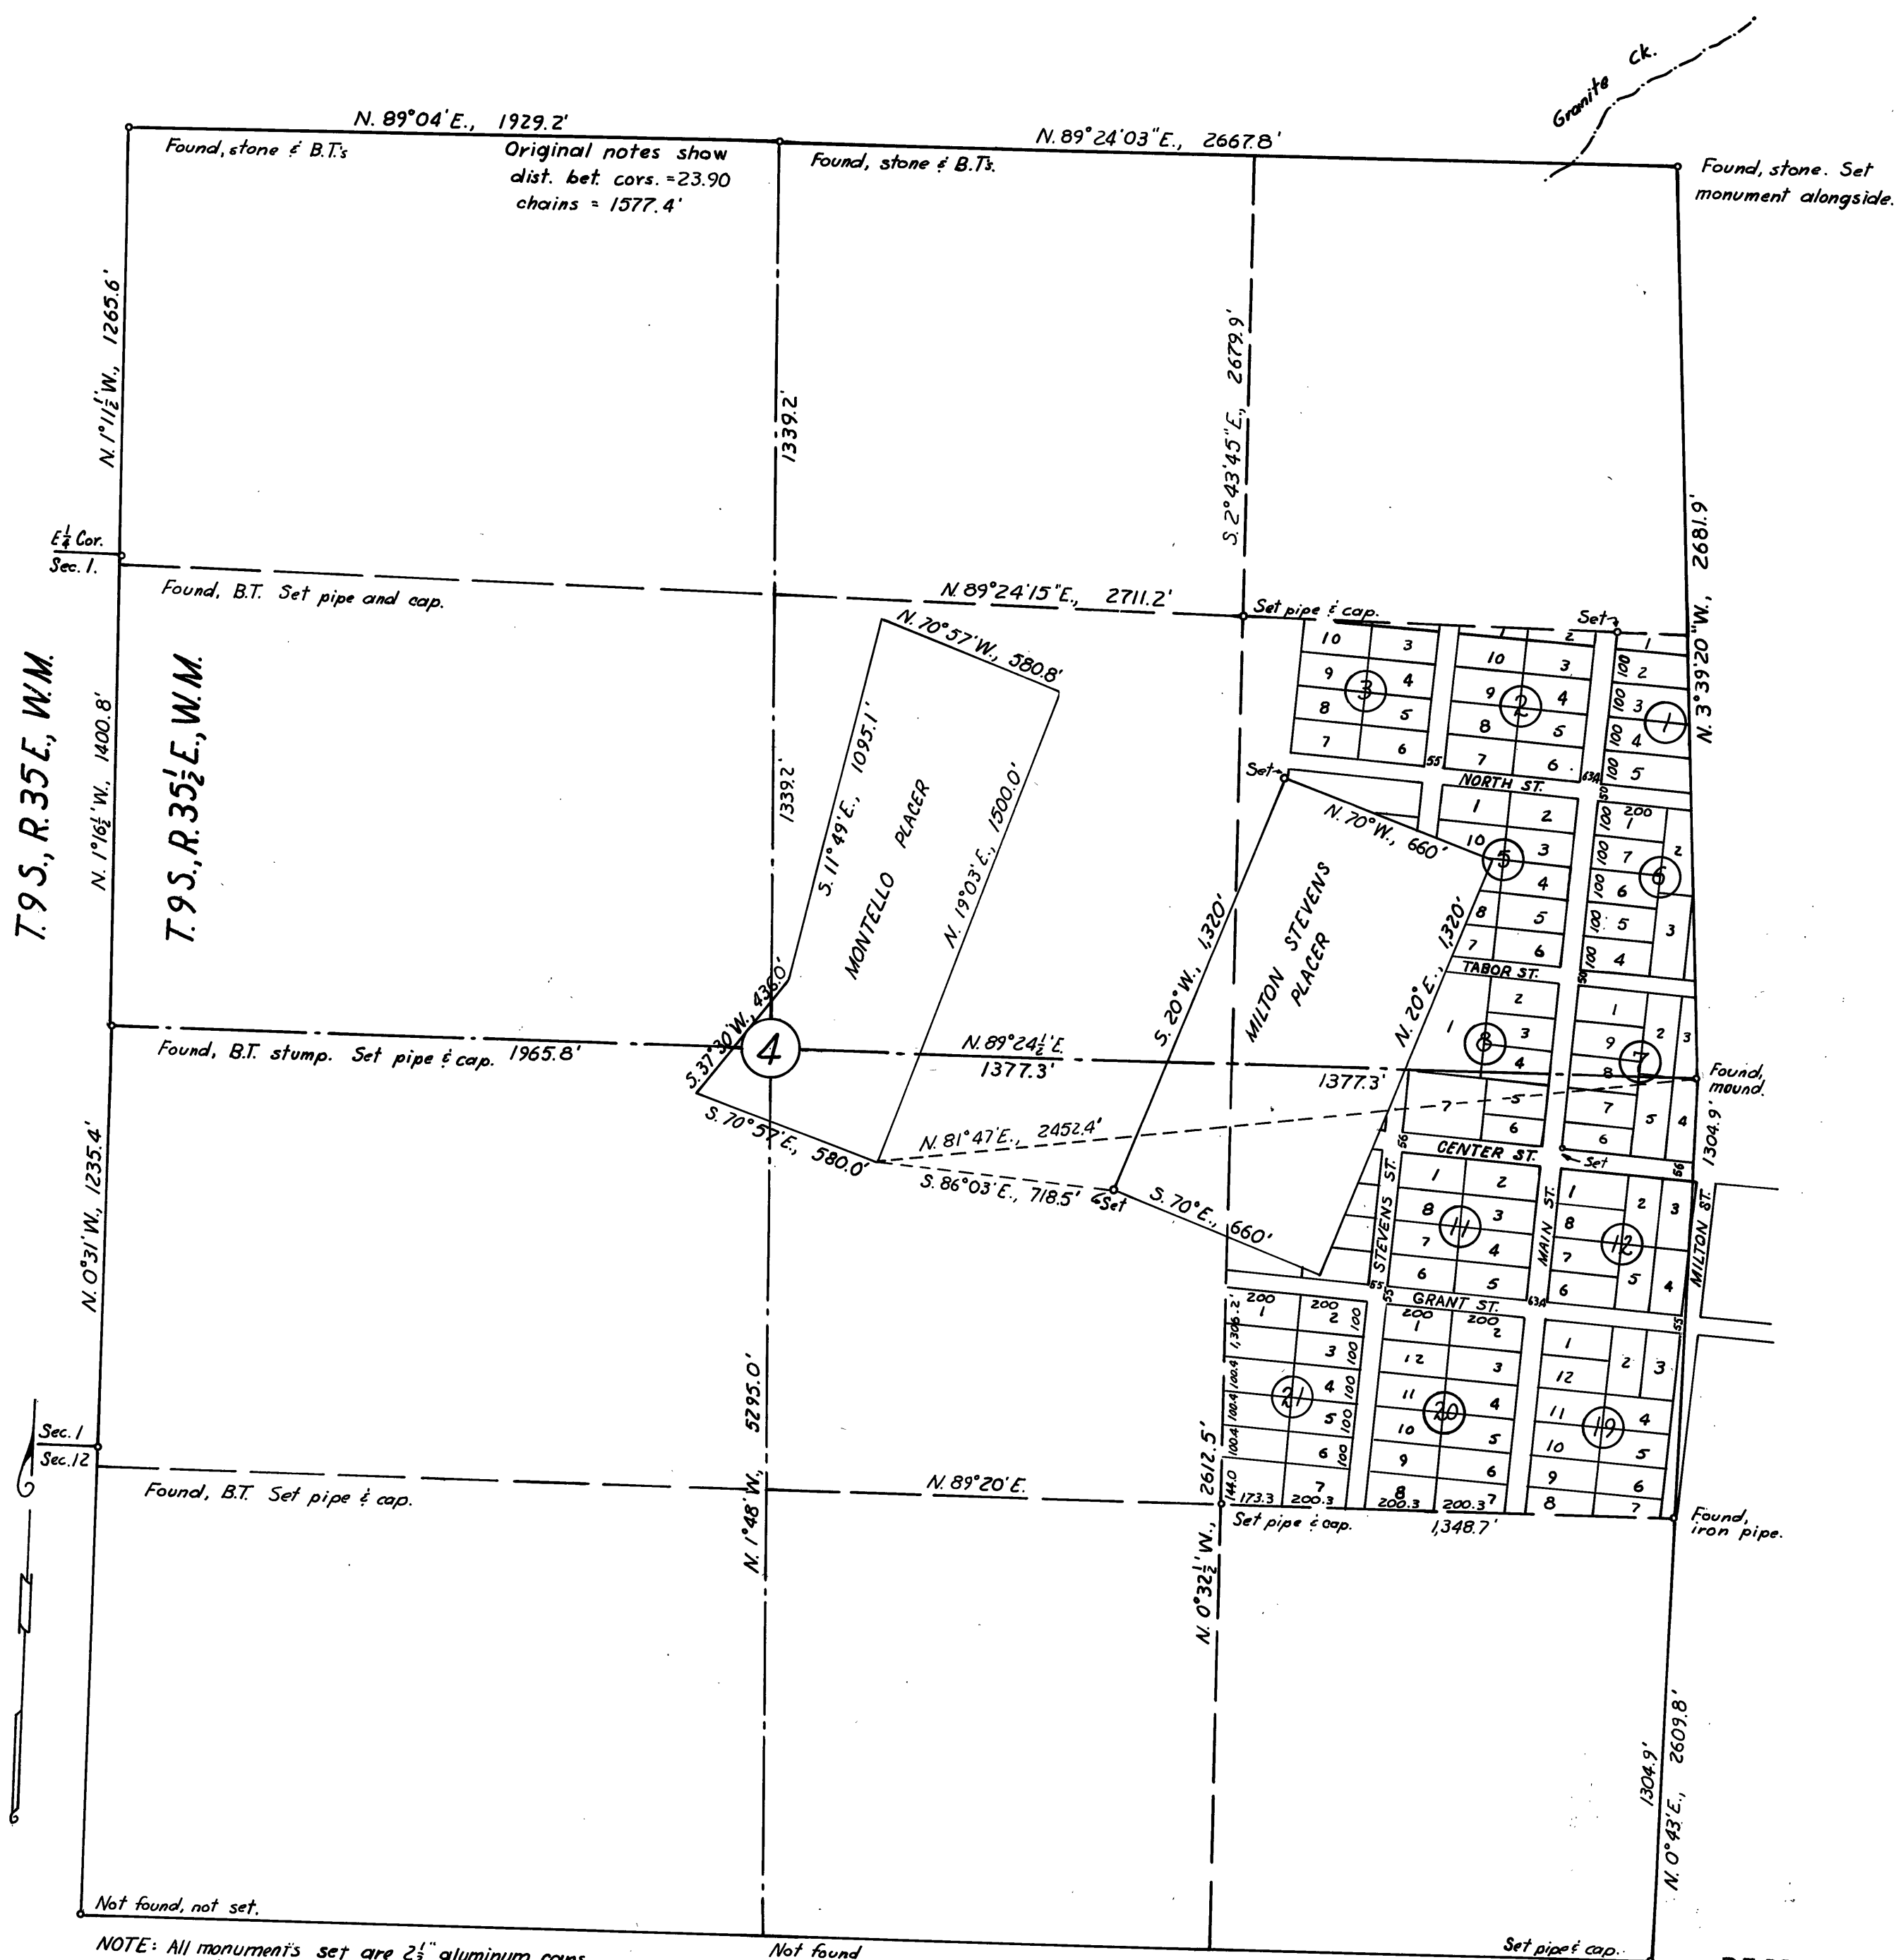

NOTE: All monuments set are 2 1/2" aluminum caps on 1" std. galvanized pipes with identification stamped in cap. Meridian by solar observation.

Not found
Not set.

SURVEY OF SUBDIVISION OF SECTION 4, T. 9 S., R. 35 $\frac{1}{2}$ E., W.M. & GRANITE, OREGON

FOR U.S. FOREST SERVICE


Surveyed Oct 29, 1963 - June 6, 1966

SCALE 1" = 400'

RECEIVED AND
FILED

JOHN LIVEIRA, County Clerk

By _____ Deputy

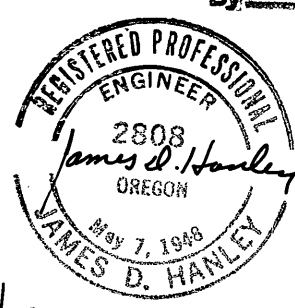

Survey Map # 134