156036

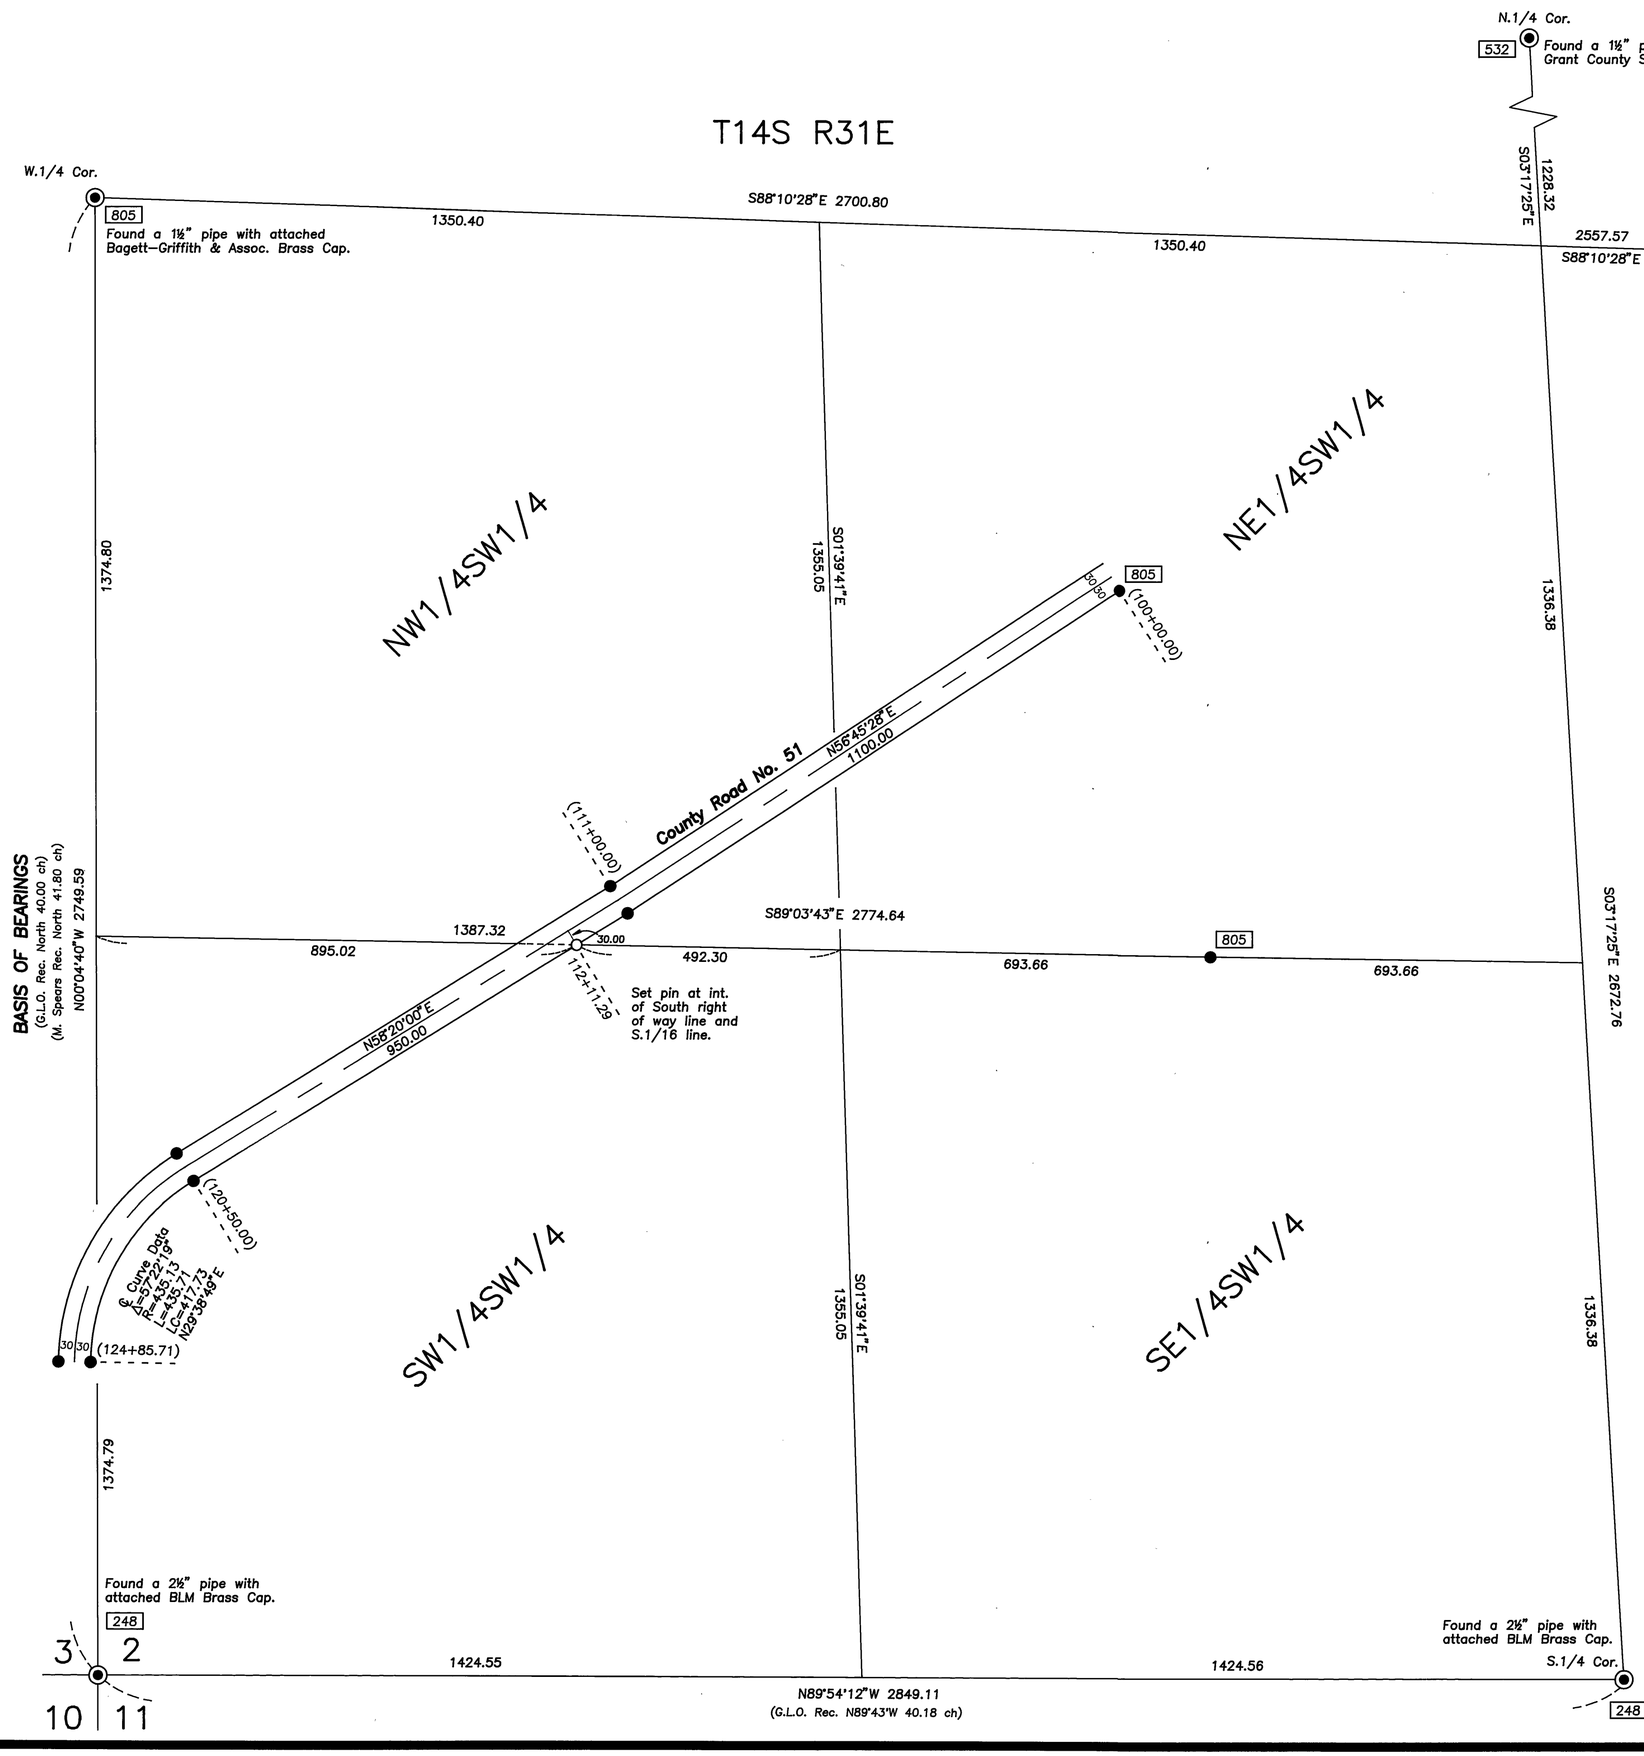

BASIS OF BEARINGS

RECORD MAP OF SURVEY NO. 805

LEGEND

- ◉ Found monument as shown.
- ● Found 5/8" iron pin with attached cap marked BGA SURVEY MARKER, set in Record Map of Survey No. 1243 (unless otherwise noted).
- ○ Set 5/8"x30" iron pin with attached yellow plastic cap marked BGA SURVEY MARKER.
- ( ) Record bearing and distance
- ▭ Found Monument from Recorded Survey No. ▭ Survey No. appears in box.

REFERENCES

Record Map of Survey No.'s
248, 532, 805, 1243.

Deeds

Book	Page	Instrument No.
129	185	942149
		940002

NARRATIVE

This survey was performed for the Grant County Road Department, at the request of Bob Kowing, Road Supervisor. The purpose of this survey was to monument the intersection of the north line of the SW¼SW¼ of Section 2 with the new relocated southerly right of way line of County Road No. 51.

A search was made of the available records pertaining to this survey. I previously subdivided Section 2 in 1984, as shown on Record Map of Survey No. 805. In 1993, I located the new proposed right of way lines for this portion of County Road No. 51, as shown on Record Map of Survey No. 1243.

During this current survey we tied appurtenant monuments of Survey 805 and 1243 and set the intersection monument as shown hereon.

I found no unusual conditions with this survey.

REGISTERED
PROFESSIONAL
LAND SURVEYOR
Robert D Bagett
OREGON
JULY 12, 1963
ROBERT D. BAGETT
598
Renewal Date 12/31/94

RECEIVED AND FILED
Nov. 30, 1994
OFFICE OF COUNTY SURVEYOR
Robert D Bagett
ATTEST: Steven D. Trollvale

BAGETT - GRIFFITH & ASSOCIATES
John Day, Oregon

MAP OF SURVEY
INTERSECTION OF THE NORTH LINE OF THE SW1/4SW1/4 OF SECTION 2 T14S,R31E WITH THE SOUTHERLY RIGHT OF WAY LINE OF COUNTY ROAD NO. 51

GRANT COUNTY, OREGON

SURVEYED FOR	GRANT COUNTY ROAD DEPARTMENT	
SURVEYED BY	RDB & SDF & DEM	10/14/94
Scale: 1"=200'	Drawn by: G.J.R.	

RECORD MAP OF SURVEY NO. 1343