


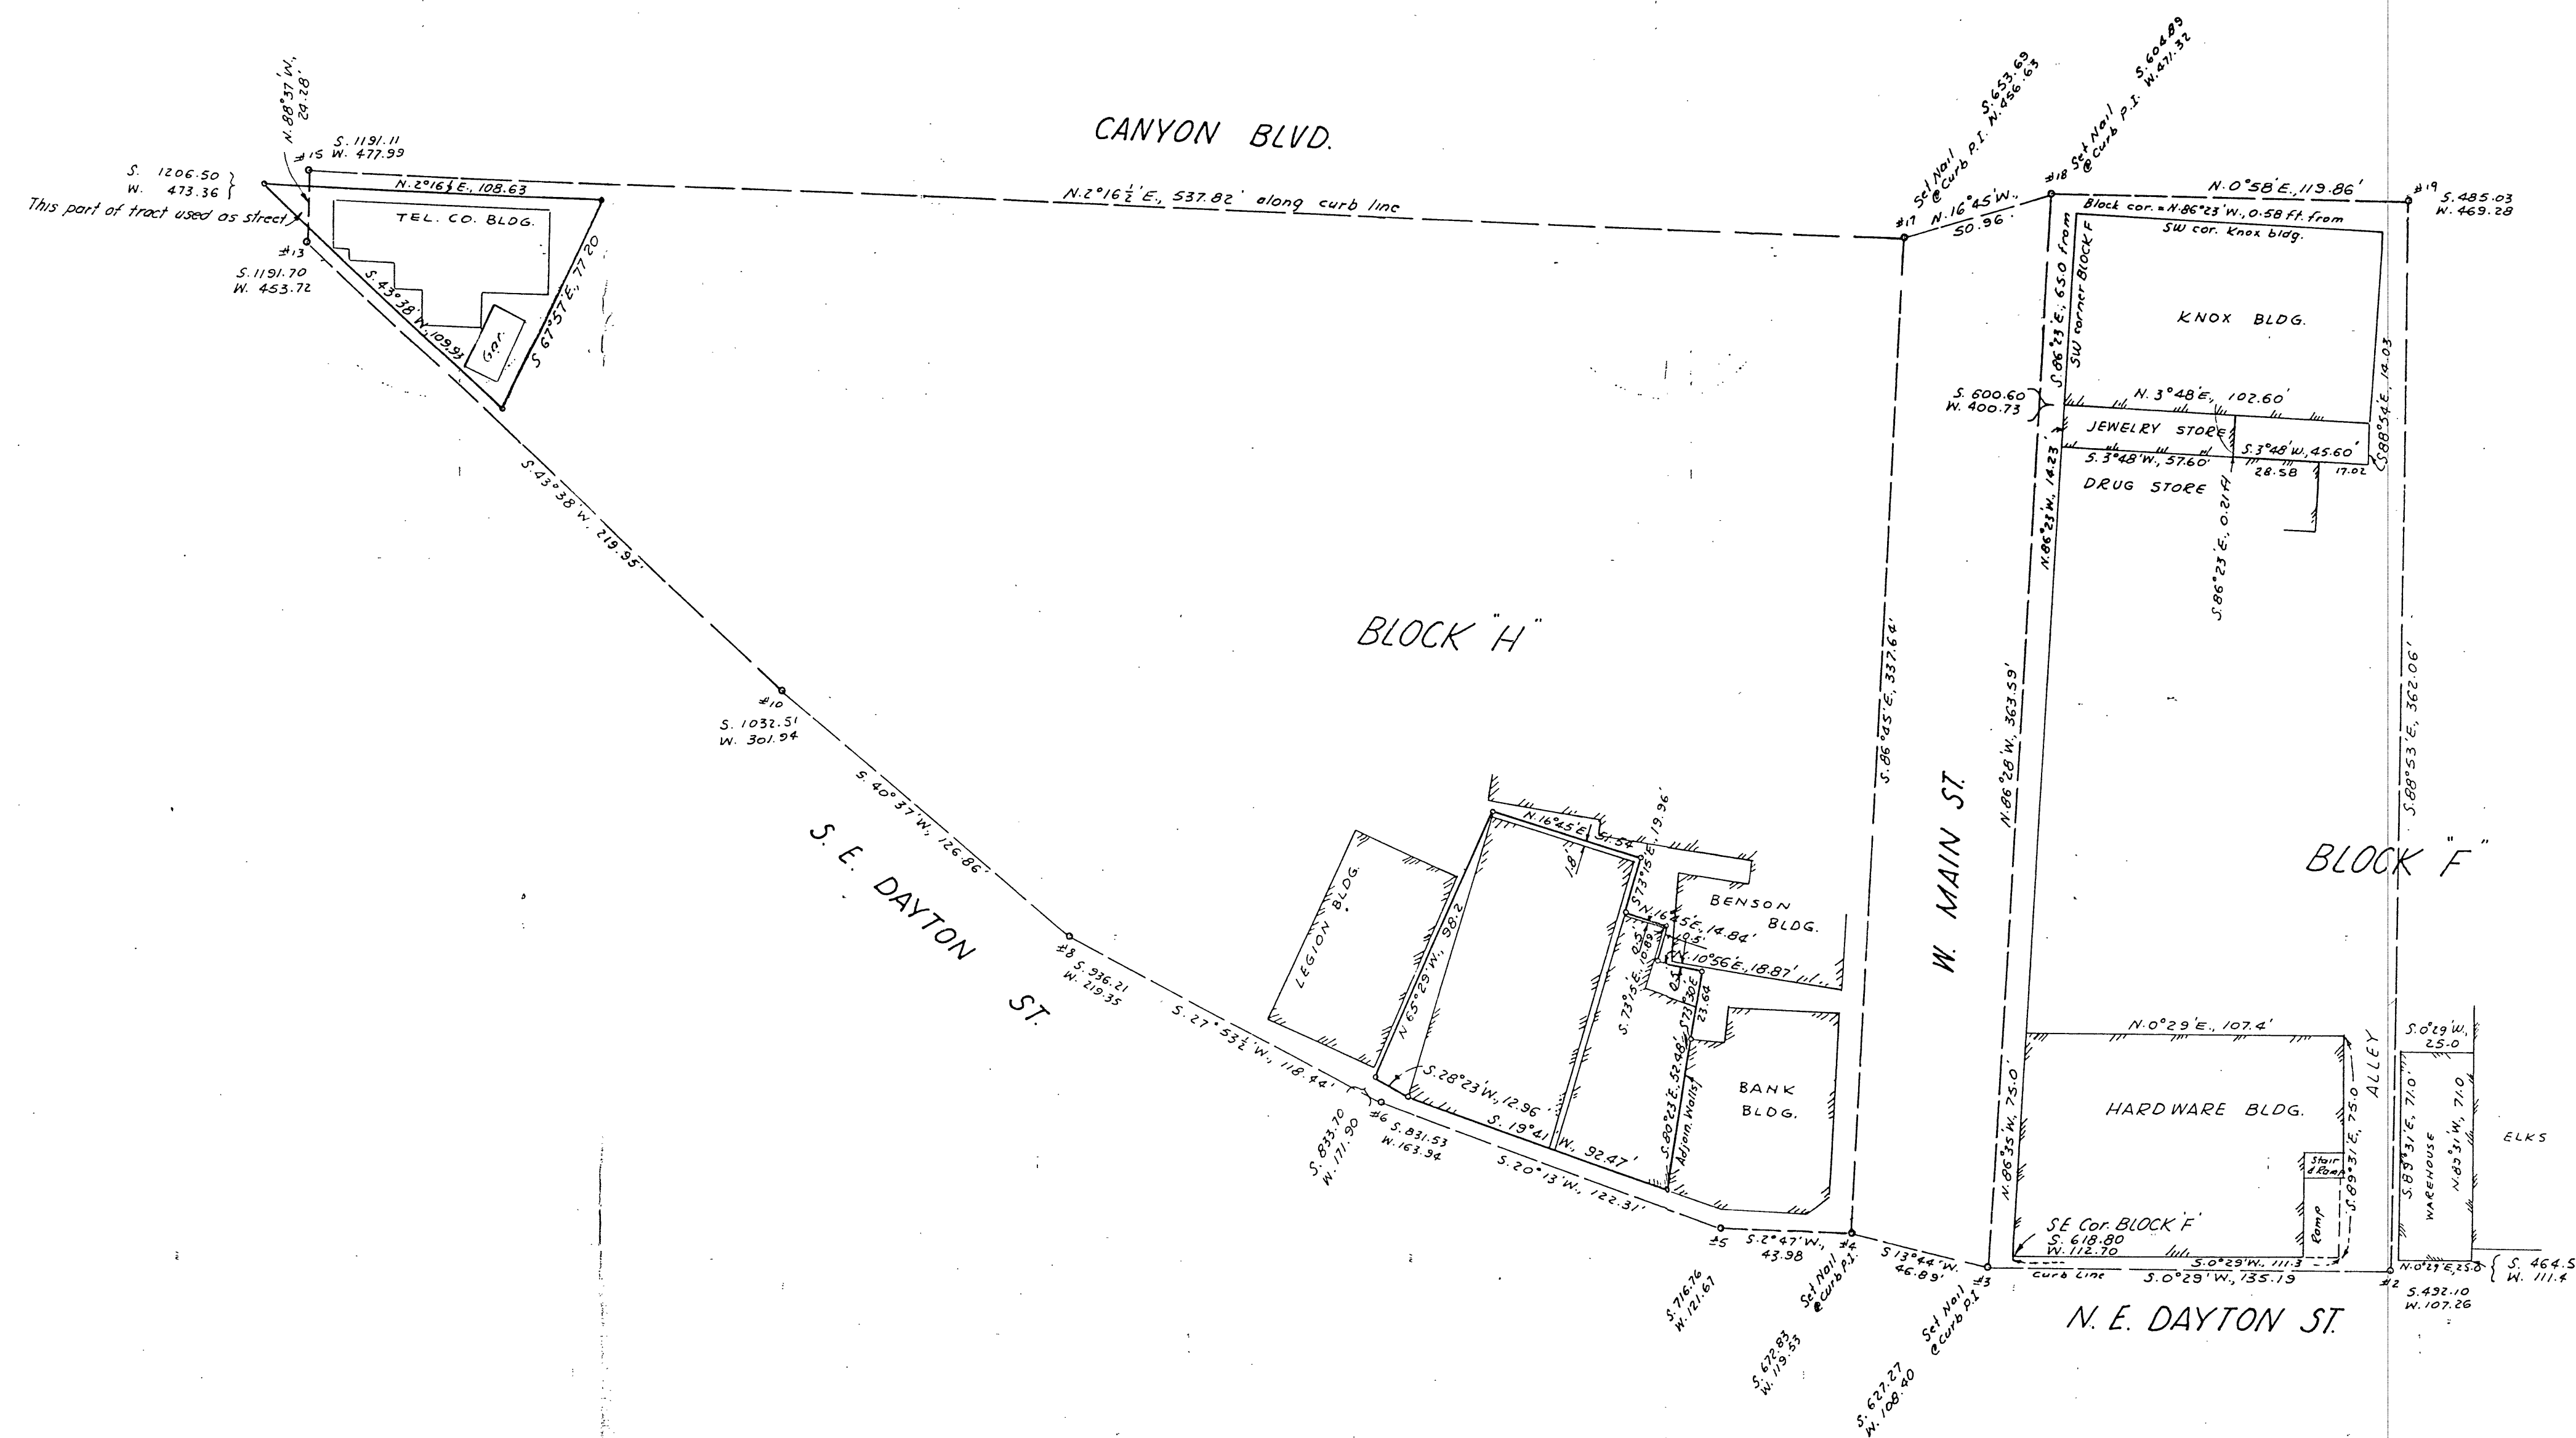

RECEIVED AND
FILED
 DEC 14 1968
 JOHN LIVEIRA, County Clerk
 By _____ Deputy

MAP OF TRACT SURVEYS
 JOHN DAY, OREGON

SCALE 1 IN = 40 FT. AUG & SEPT, 1964

Survey Map #135

James D. Houtley