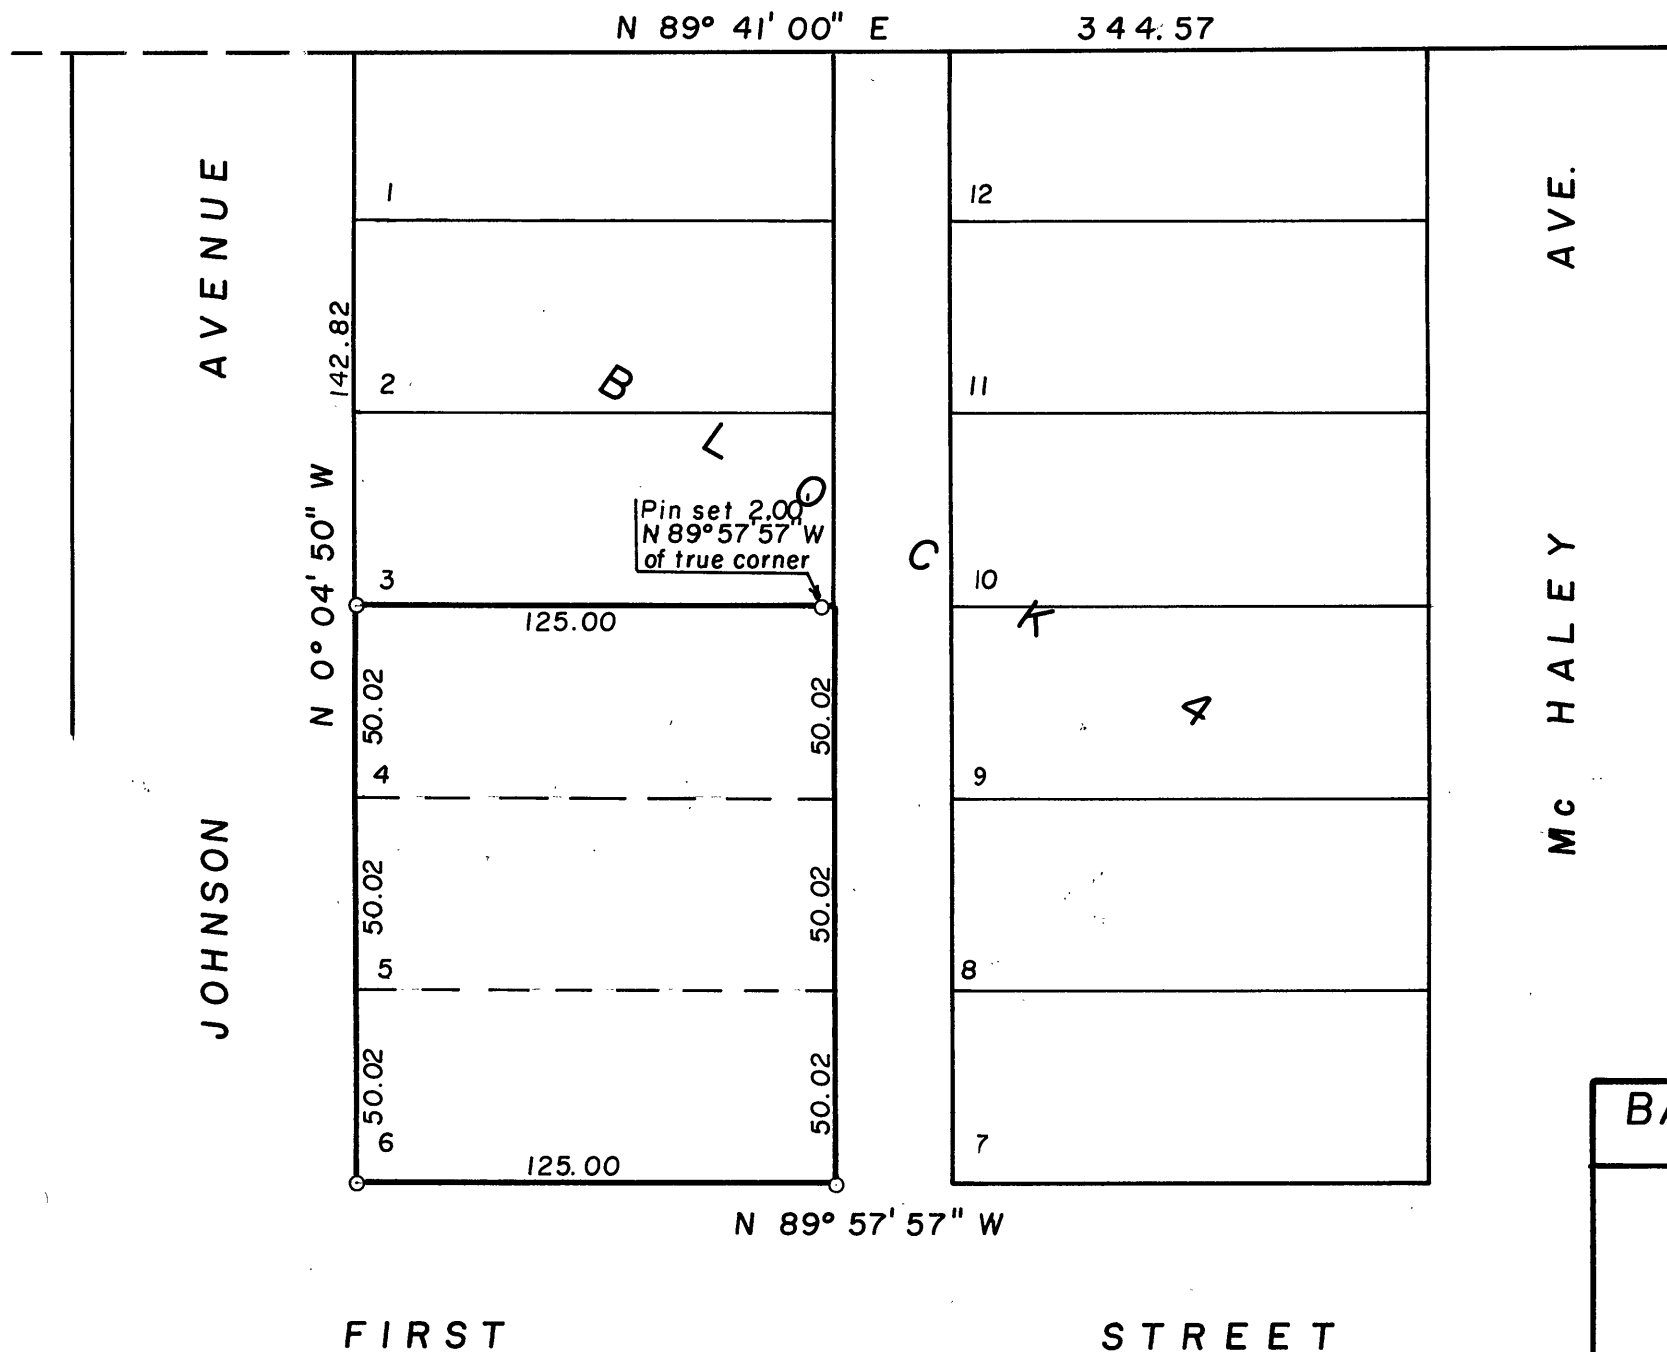


BASIS OF BEARINGS
"SOLARS"

REGISTERED
OREGON
LAND SURVEYOR

Duane I. Griffith

JULY 10, 1964
DUANE I. GRIFFITH
644

BAGETT & GRIFFITH SURVEYING

JOHN DAY, OREGON

Map of Survey

Lots 4, 5, & 6, Block 4

CLEAVER COZART ADDITION

Prairie City

Grant County, Oregon

SURVEYED FOR	John Fossum	
SURVEYED BY	DIG & RDB	2 / 1969
Scale: 1" = 50'	Drawn by DIG	2 / 1969

RECEIVED AND
FILED

FEB 23 1969

John Liveira
JOHN LIVEIRA, County Clerk

By _____ Deputy

Survey Map 137