
## SECTION 30, T8S,R32E R31E (N89°47'W 40.52 CH.) ((N89°21'11"W 2665.64)) N89°21'47"W 2665.81 1350.01 1315.80 599 N89°21'47"W 599 1351.03 1317.78 N89°22'01"W 2671.86 ((N89°21'20"W 2671.89)) ((N89°21'20"W)) S**89°22'18"**E 1352.10 1319.76 599 2629.00 ((2629.30))BEARINGS BASI 1348.62 1318.29 599 N88°41'26"W 2666.91 ((N88°41°21"W 2667.12)) (N89°44'W 40.46 CH.)

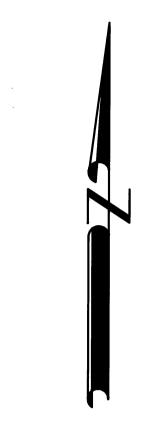

This survey was performed at the request of Robert Lindenmeyer. The purpose of this survey was to locate and monument the NE and SE corners of Gov't Lot 2 and the SE corner of corners of Gov't Lot 2 and the SE corner of Gov't Lot 4 of Section 30, and to post the lines indicated hereon with lath. A search was made of the available records pertaining to this survey. Field measurements were made to locate existing controlling monuments of record affecting the subdivision of this section, ie, the NW cor., SW cor., N1/4 cor., S1/4 cor., E1/4 cor., W1/4 cor., C1/4 cor., N1/16 cor. on the west boundary of Section 30. All of the above corners were found in position and monumented as shown on Record Map in position and monumented as shown on Record Map of Survey No. 599. I accept the position of the found monuments. We subdivided, by survey, the W1/2 of Section 30, as shown hereon. We determined the position of corners to be set and set monuments at the following corners: W1/16 cor. on the south boundary; C—W 1/16 cor.; NW1/16 cor. We posted the east line of Gov't Lots 2, 3, and 4 and the north line of Gov't Lot 2 of Section 30. We also took new hearing trees at each of the corners set Sec bearing trees at each of the corners set. See Corner Restoration sheets for details of monuments set and new bearing trees filed in Corner Restoration Book.



## BASIS OF BEARINGS

RECORD MAP OF SURVEY NO. 599 AS SHOWN

## LEGEND

- Found 2½" Galv. iron pipe with 2½" brass cap.
- Set 5/8"x30" iron pin with attached alum. cap marked BGB SURVEY MARKER, with appropriate corner markings.
  - Fence line.

- GLO Record bearing and distance.
- Record bearing and distance from Record Map of Survey No. 599.
  - Found Monument from Recorded Survey No. Survey No. appears in box.

## **REFERENCES**

Record Map of Survey No. 599 Deed Record Instrument No. 950654

RECEIVED AND FILED

Oct 10,1995 OFFICE OF COUNTY SURVEYOR

REGISTERED **PROFESSIONAL** LAND SURVEYOR OREGON
JULY 12, 1963
ROBERT D. BAGETT

598 Renewal Date 12/31/95 BAGETT, GRIFFITH & BLACKMAN

217 N. Canyon Blvd. John Day, Oregon

MAP OF SURVEY OF A TRACT OF LAND
SITUATED IN GOV'T LOTS 2,3, AND 4
OF SECTION 30 T8S,R32E. W.M.

GRANT COUNTY, OREGON

SURVEYED FOR ROBERT LINDENMEYER SURVEYED BY RDB & JLW & GJR 9/18/95 Scale: 1"=500' Drawn by: G.J.R.

RECORD MAP OF SURVEY NO. 1379