


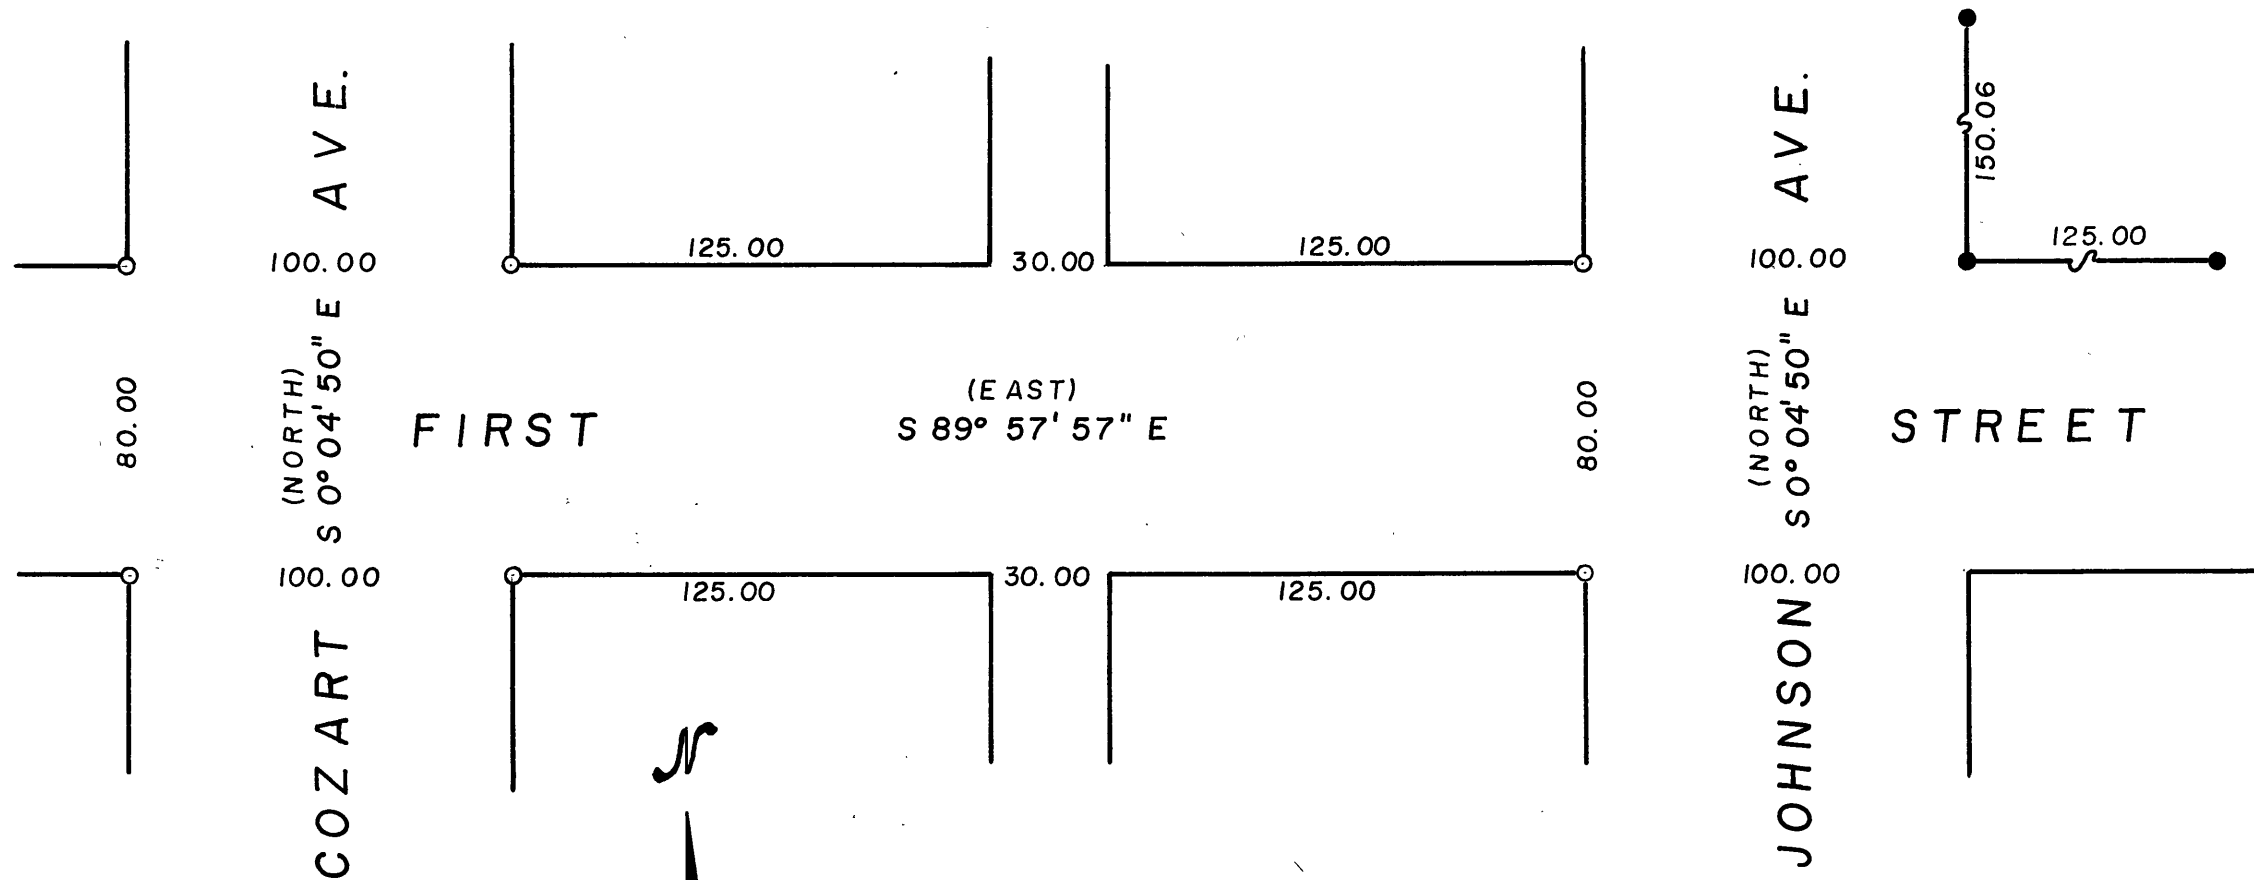

RECEIVED AND
FILED
 MAR 13 1969
 JOHN LIVERA, County Clerk
 By _____ Deputy

- LEGEND**
- Fd. monuments of record
 - Set 5/8"x 30" iron pin
 - () Record

Bearings based on
 solar observations.

REGISTERED
OREGON
 LAND SURVEYOR
Duane I. Griffith
 JULY 10, 1964
 DUANE I. GRIFFITH
 644

BAGETT & GRIFFITH SURVEYING		
JOHN DAY, OREGON		
Map of Survey		
First Street, between Cozart Avenue & Johnson Avenue Prairie City Grant County, Oregon		
Surveyed for	City of Prairie City	
Surveyed by	DIG & RDB	Mar. 1969
Scale: 1" = 50'	Drawn by DIG	Mar. 1969

Survey Map # 139