


TOWNSHIP 18 SOUTH, RANGE 27 EAST, OF THE WILLAMETTE MERIDIAN, OREGON
DEPENDENT RESURVEY

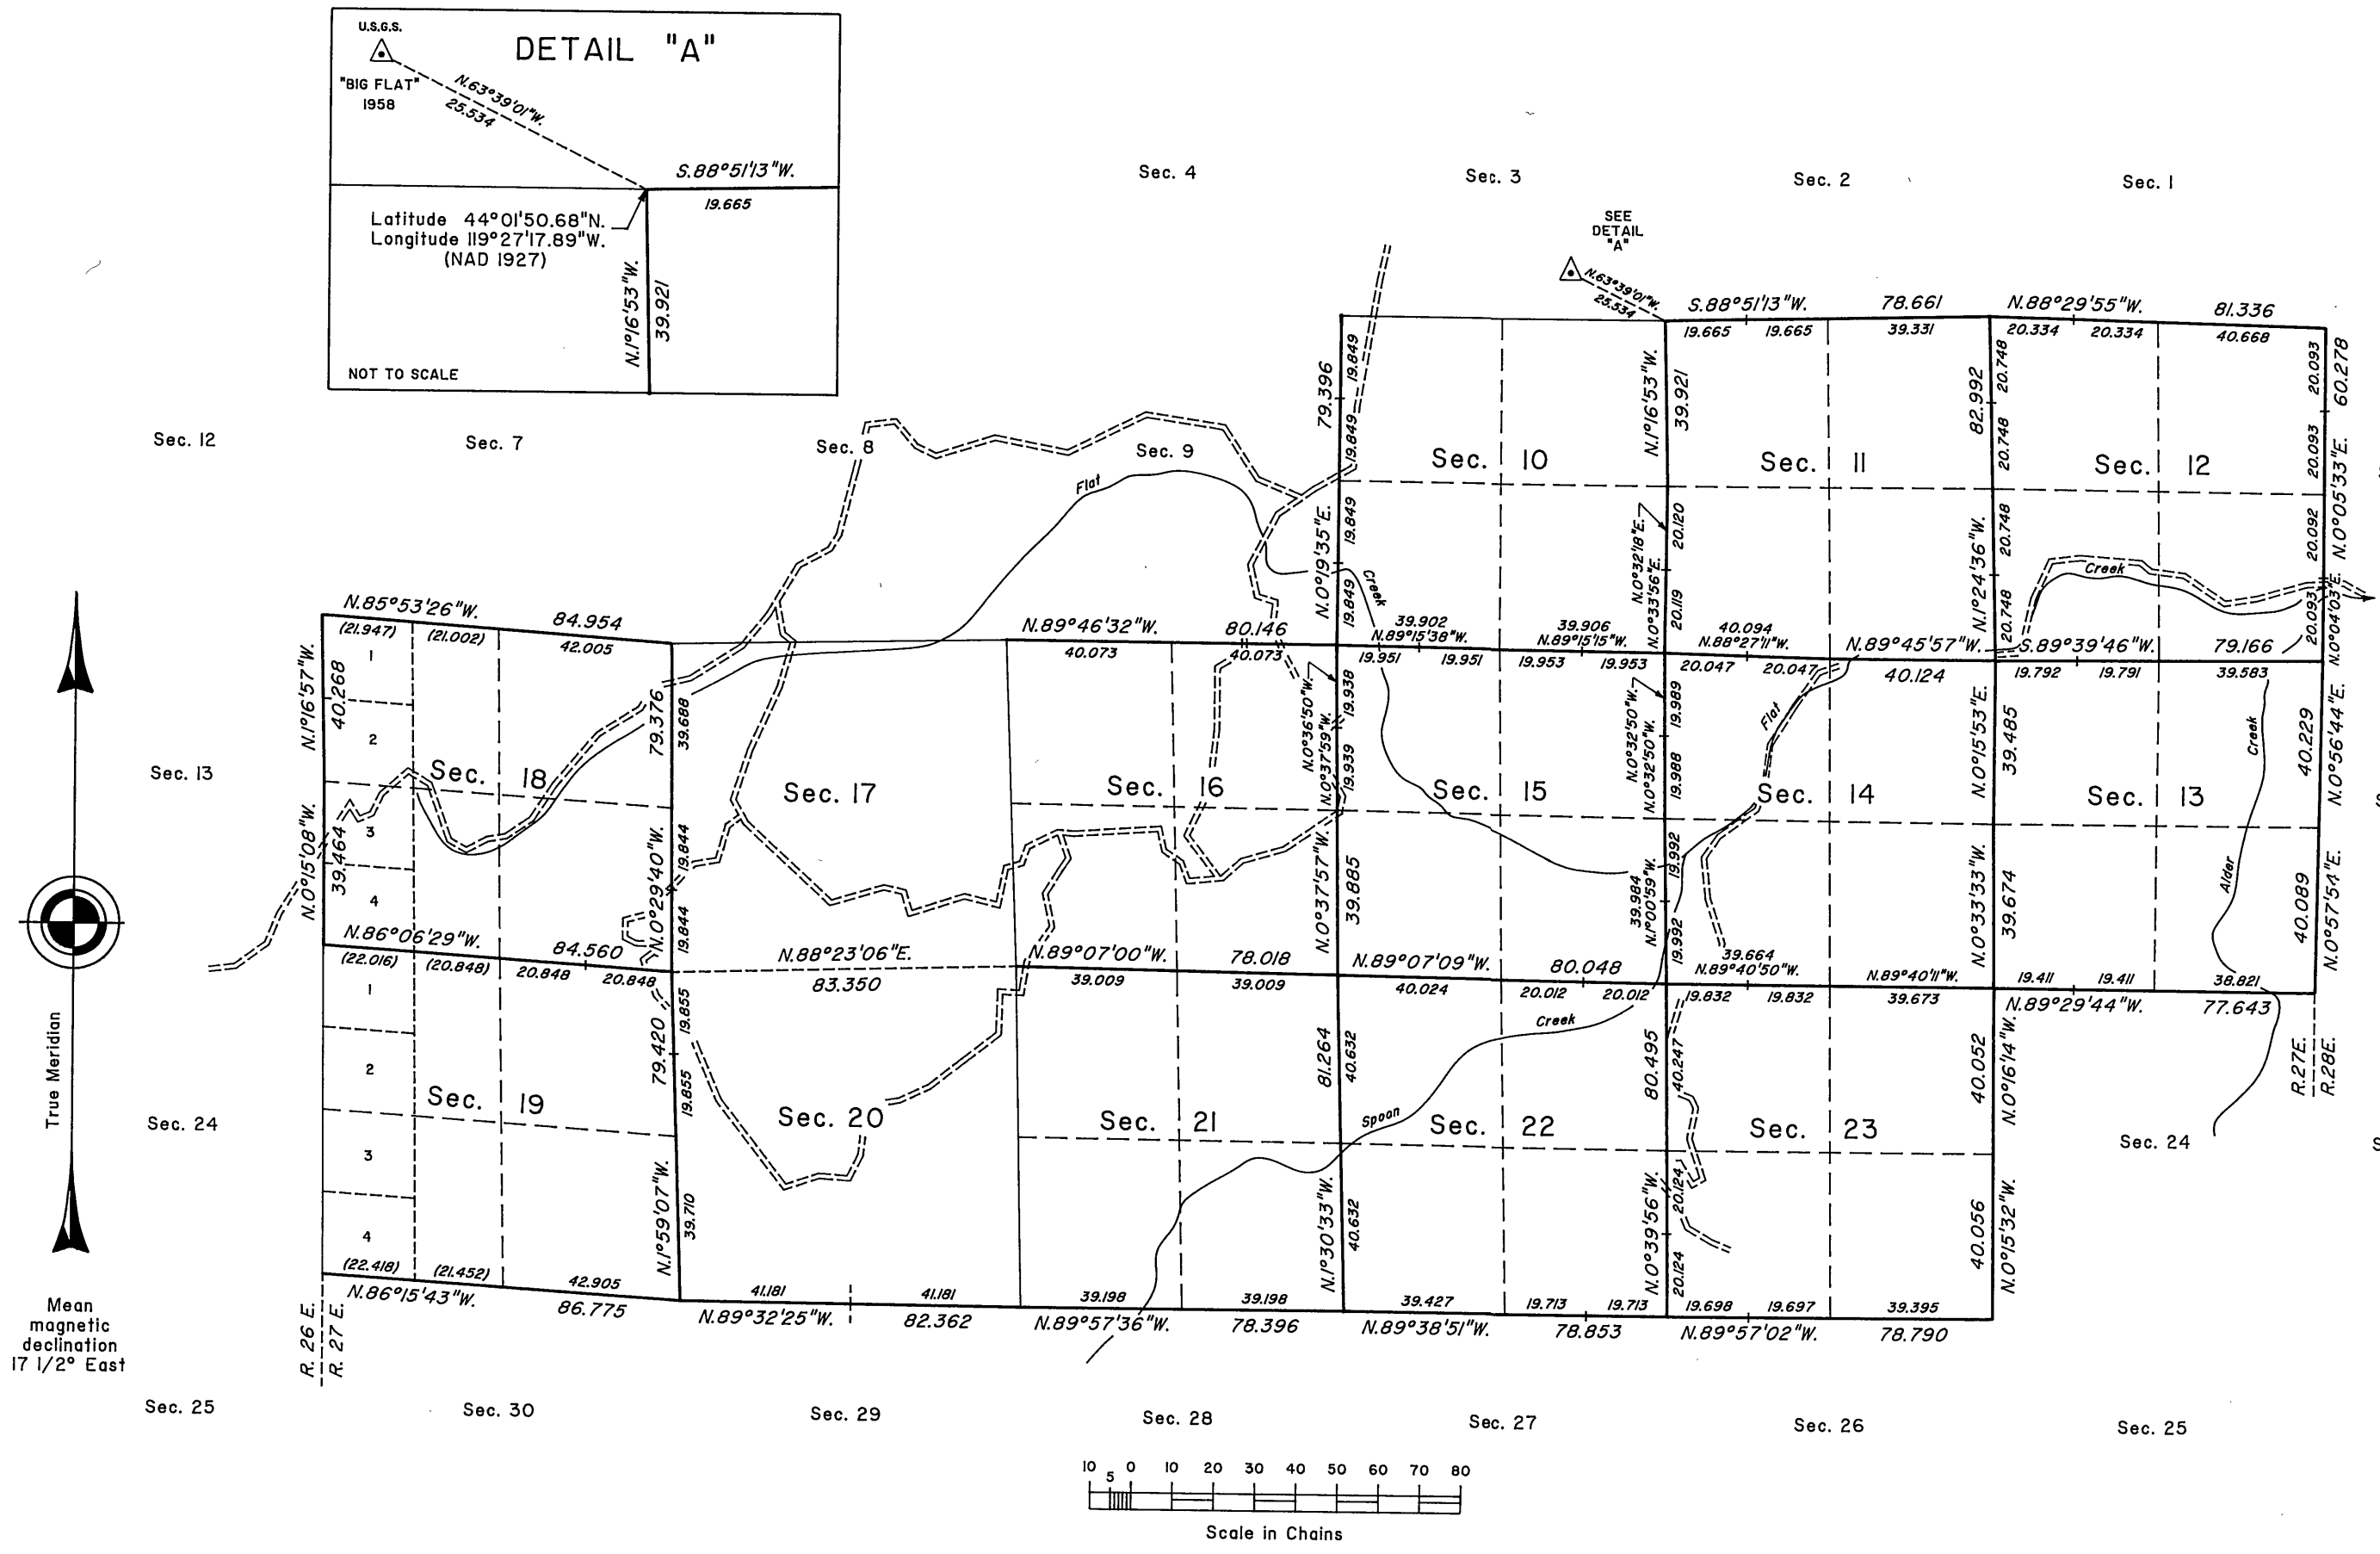

A history of surveys is contained in the field notes.

This plat represents a dependent resurvey of a portion of the east and west boundaries and subdivisional lines, T. 18 S., R. 27 E., Willamette Meridian, Oregon, designed to restore the corners in their true original locations according to the best available evidence.

Measured distances and directions have been adjusted by Cadastral Measurement Management (CMM), a computer software that incorporates a least squares adjustment routine. The adjusted bearings and distances are reported to the nearest second and 0.001 chain.

The lottings and areas are as shown on the plat approved October 26, 1874.

The survey was executed by Daniel E. Weller, Cadastral Surveyor, beginning April 22, 1992, and completed June 17, 1993, pursuant to Special Instructions dated April 14, 1992, under Group Number 1647, Oregon.

Timber in this area consists of pine, fir, juniper, larch, and aspen.

At the request of the U.S. Forest Service, the true area for each quarter-quarter section is reported for all lands under their jurisdiction. Where the true area is within 5% of the record area, the quarter-quarter section will retain its aliquot part designation even though the area changes. The quarter-quarter section will continue to be divided by legal subdivision.

The tie to the geodetic control station is reported as mean bearing and sea level distance.

LEGAL SUBDIVISION	OFFICIAL AREA
SECTION 11	
SE 1/4 NE 1/4	40.91 Acres
SW 1/4 NE 1/4	40.52 Acres
NE 1/4 SE 1/4	41.26 Acres
NW 1/4 SE 1/4	41.18 Acres
NE 1/4 SW 1/4	40.34 Acres
NW 1/4 SW 1/4	39.81 Acres

LEGAL SUBDIVISION	OFFICIAL AREA
SECTION 12	
SE 1/4 NE 1/4	40.60 Acres
SW 1/4 NE 1/4	40.92 Acres
NE 1/4 SE 1/4	40.32 Acres
NW 1/4 SE 1/4	40.65 Acres
NE 1/4 SW 1/4	40.98 Acres
NW 1/4 SW 1/4	41.30 Acres
SE 1/4 NW 1/4	41.25 Acres
SW 1/4 NW 1/4	41.57 Acres

LEGAL SUBDIVISION	OFFICIAL AREA
SECTION 13	
SW 1/4 SW 1/4	38.71 Acres
NW 1/4 SW 1/4	39.05 Acres
SW 1/4 NW 1/4	39.09 Acres
NW 1/4 NW 1/4	39.14 Acres

LEGAL SUBDIVISION	OFFICIAL AREA
SECTION 14	
SE 1/4 SW 1/4	39.61 Acres
NW 1/4 SW 1/4	39.83 Acres
SW 1/4 NW 1/4	39.84 Acres

LEGAL SUBDIVISION	OFFICIAL AREA
SECTION 15	
SE 1/4 NE 1/4	39.78 Acres
SW 1/4 NE 1/4	39.76 Acres
NE 1/4 SE 1/4	39.81 Acres
SW 1/4 SE 1/4	39.90 Acres
NW 1/4 SE 1/4	39.79 Acres
NE 1/4 SW 1/4	39.89 Acres
SW 1/4 SW 1/4	39.91 Acres
NE 1/4 NW 1/4	39.89 Acres
SW 1/4 NW 1/4	39.86 Acres
SE 1/4 NW 1/4	39.86 Acres
SW 1/4 NW 1/4	39.83 Acres

LEGAL SUBDIVISION	OFFICIAL AREA
SECTION 18	
NE 1/4 SE 1/4	41.33 Acres
SW 1/4 SE 1/4	41.20 Acres
NW 1/4 SE 1/4	41.28 Acres
NE 1/4 SW 1/4	40.96 Acres
SE 1/4 SW 1/4	41.06 Acres
LOT 3	43.25 Acres
LOT 4	43.03 Acres

LEGAL SUBDIVISION	OFFICIAL AREA
SECTION 22	
SW 1/4 NE 1/4	40.17 Acres
NW 1/4 NE 1/4	40.32 Acres
SE 1/4 SE 1/4	39.78 Acres
SW 1/4 SE 1/4	39.87 Acres
NW 1/4 SE 1/4	40.02 Acres
NE 1/4 SW 1/4	40.11 Acres
SW 1/4 SW 1/4	39.97 Acres
NE 1/4 NW 1/4	40.06 Acres
SW 1/4 NW 1/4	40.21 Acres
SE 1/4 NW 1/4	40.41 Acres
SW 1/4 NW 1/4	40.26 Acres
SE 1/4 NW 1/4	40.35 Acres
NW 1/4 NW 1/4	40.50 Acres

LEGAL SUBDIVISION	OFFICIAL AREA
SECTION 23	
NE 1/4 NE 1/4	39.72 Acres
SE 1/4 NE 1/4	39.65 Acres
SW 1/4 NE 1/4	39.70 Acres
NW 1/4 NE 1/4	39.77 Acres
NE 1/4 SE 1/4	39.58 Acres
SE 1/4 SE 1/4	39.51 Acres
SW 1/4 SE 1/4	39.55 Acres
NW 1/4 SE 1/4	39.63 Acres
NE 1/4 SW 1/4	39.60 Acres
SE 1/4 SW 1/4	39.65 Acres
SW 1/4 SW 1/4	39.60 Acres
NE 1/4 NW 1/4	39.80 Acres
SE 1/4 NW 1/4	39.74 Acres

UNITED STATES DEPARTMENT OF THE INTERIOR
BUREAU OF LAND MANAGEMENT

Portland, Oregon June 1, 1995

This plat is strictly conformable to the approved field notes, and the survey, having been correctly executed in accordance with the requirements of law and the regulations of this Bureau, is hereby accepted.

For the Director
Wayne M. Gardner
Chief Cadastral Surveyor of Oregon

RECEIVED AND
FILED
NOV 21 1995

OFFICE OF COUNTY SURVEYOR
Robert A. Smith
Agent

D.E.W.

Print